


HANSON'S ADDITION OF TOUCHET 54

PAGE

~~BOOK 16 PAGE 64~~
O.W.R. & N. CO.

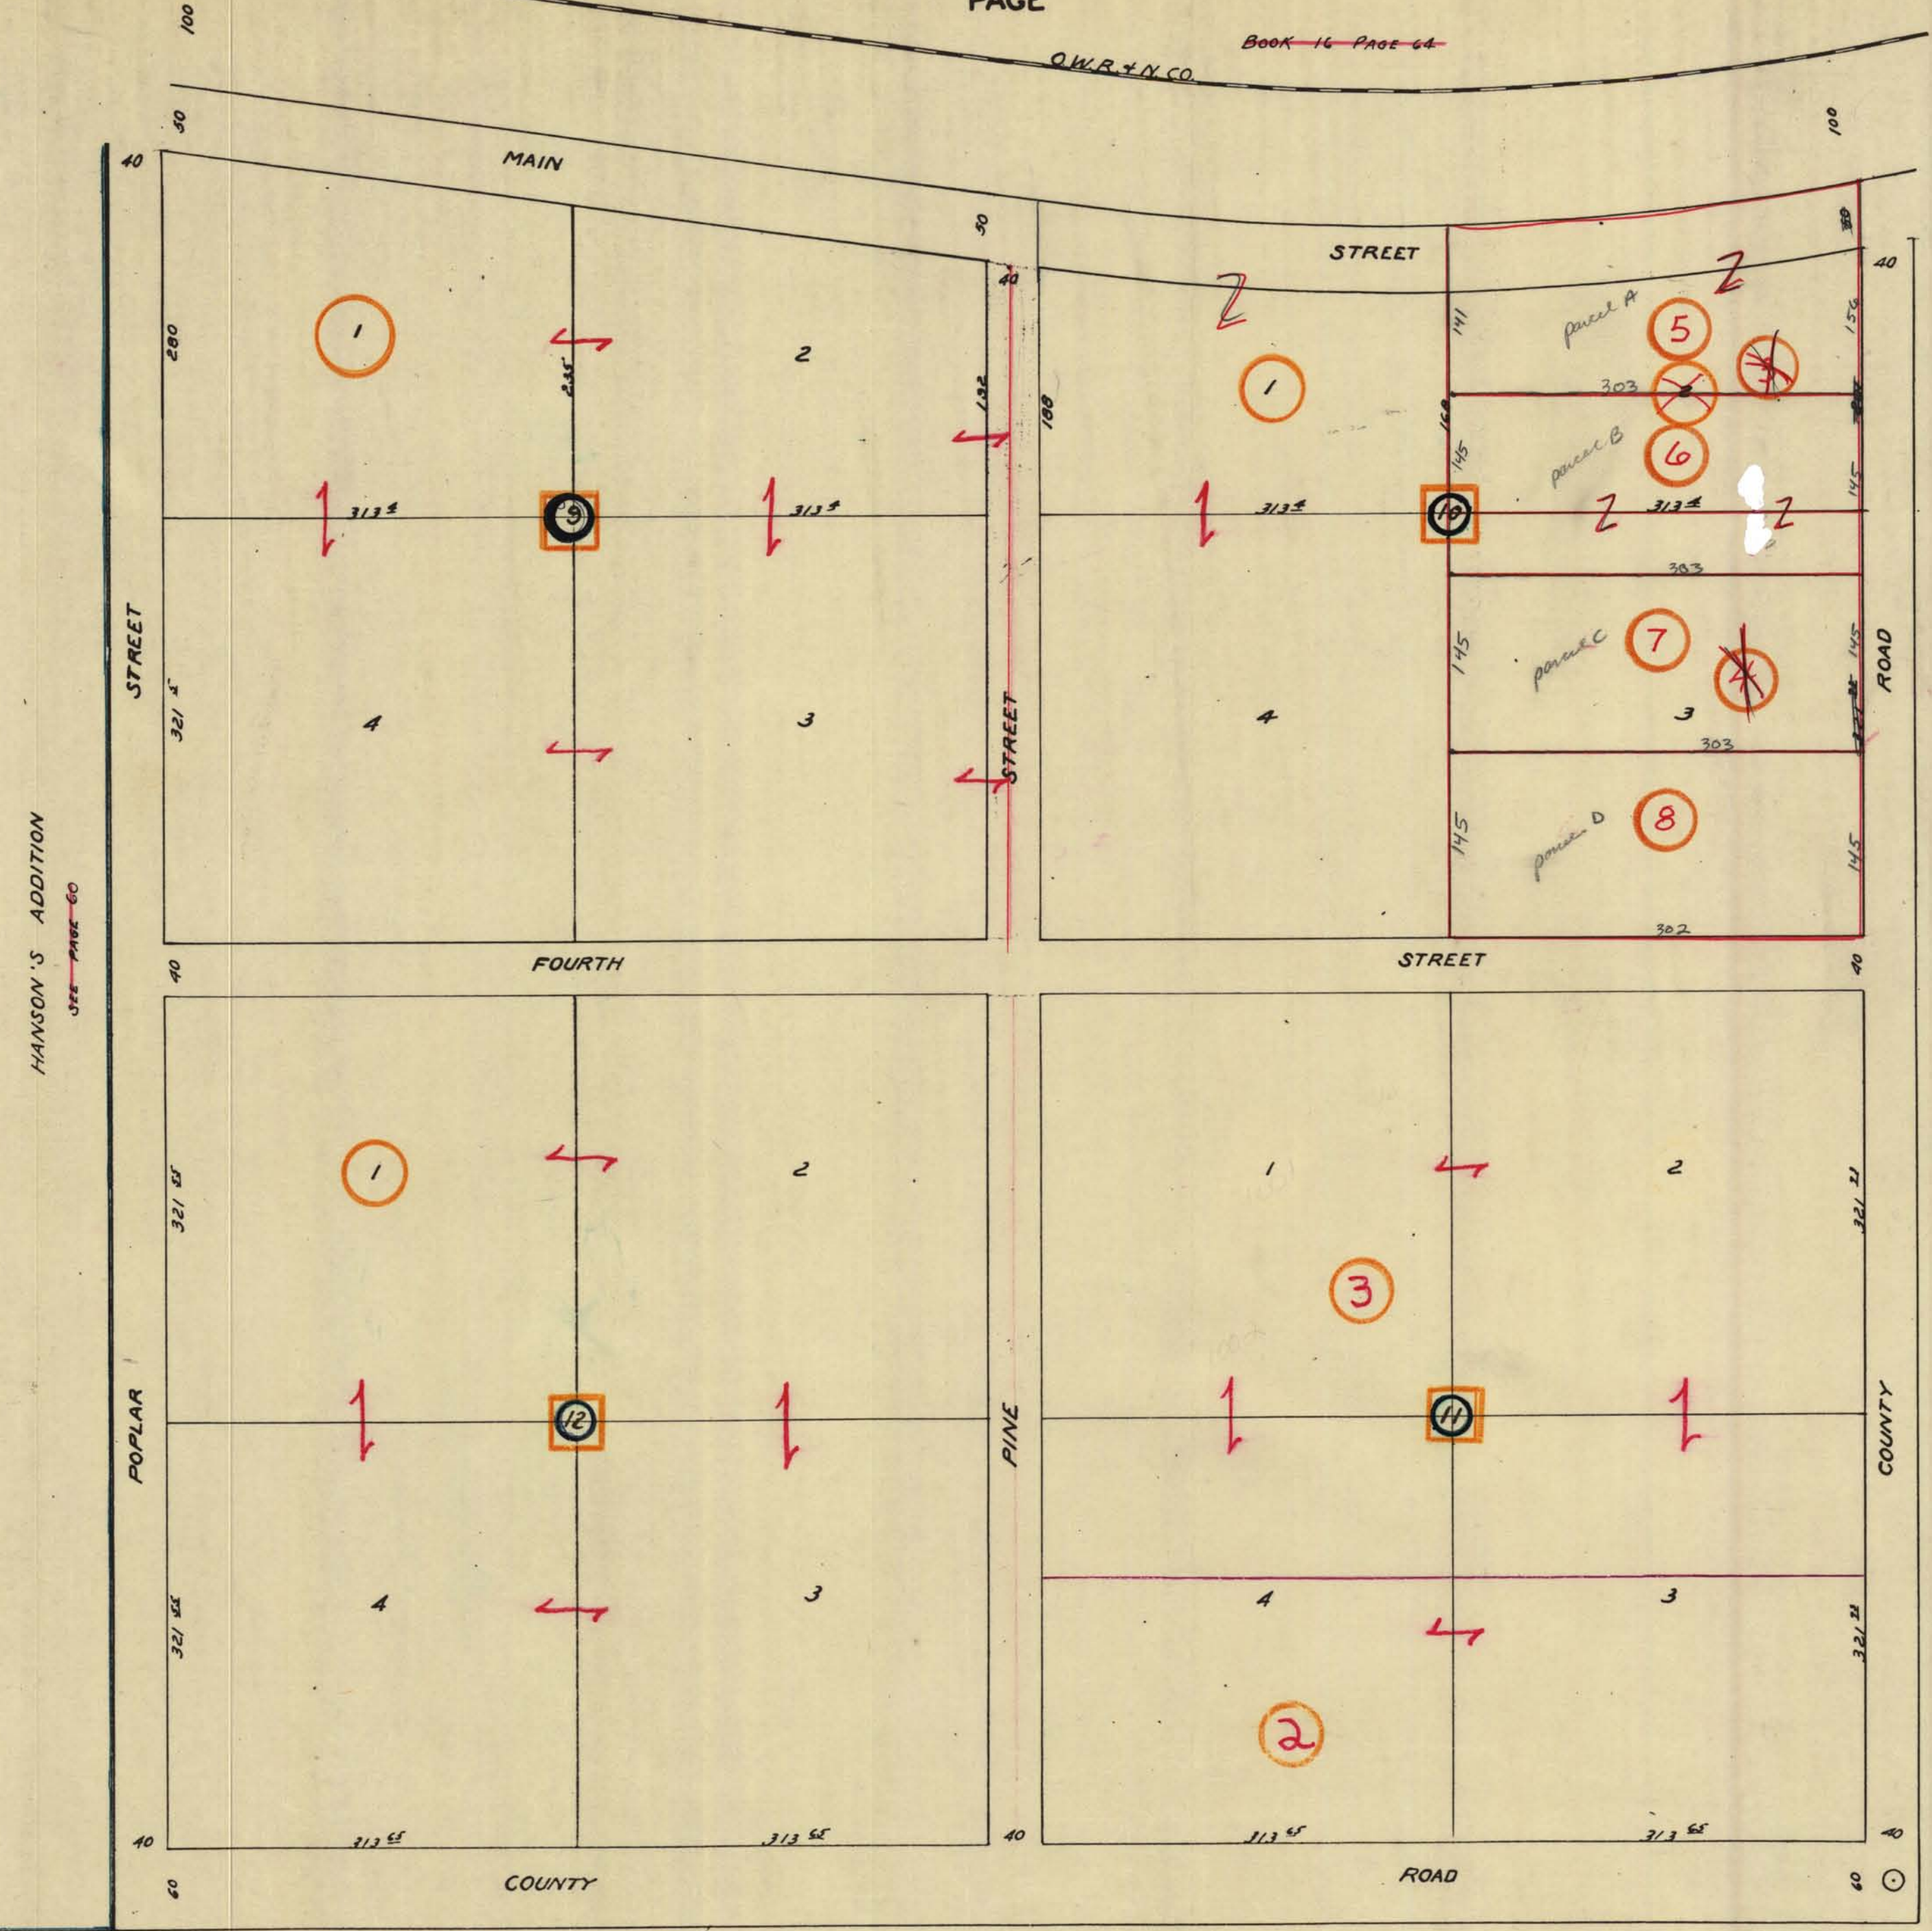

HANSON'S ADDITION
~~OFF PAGE 60~~

~~BOOK 16 PAGE 66~~

SCALE 1" = 100'

~~BOOK 16 PAGE 2~~

SE. COR. 34-7-33