

373 ➔ 197

## Table of Contents

### Inspections

CITY OF CASSVILLE MO • 1 • 3A • Pre-Lining [13 • Apr • 2023] .....	1
Street: MILL ST Street: MILL ST	
CITY OF CASSVILLE MO • 12 • 9 • Pre-Lining [03 • May • 2023] .....	3
Street: HAROLD ST Street: HAROLD ST	
CITY OF CASSVILLE MO • 145 • 148 • Pre-Lining [19 • Apr • 2023] .....	5
Street: MAIN ST Street: MAIN ST	
CITY OF CASSVILLE MO • 15 • 14 • Pre-Lining [04 • May • 2023] .....	7
Street: HAROLD ST Street: HAROLD ST	
CITY OF CASSVILLE MO • 151 • 179 • Pre-Lining [19 • Apr • 2023] .....	9
Street: EAST ST Street: EAST ST	
CITY OF CASSVILLE MO • 152 • 151 • Pre-Lining [19 • Apr • 2023] .....	11
Street: EAST ST Street: EAST ST	
CITY OF CASSVILLE MO • 16 • 15 • Pre-Lining [04 • May • 2023] .....	13
Street: HAROLD ST Street: HAROLD ST	
CITY OF CASSVILLE MO • 17 • 68 • Pre-Lining [23 • May • 2023] .....	15
Street: FAIR ST Street: FAIR ST	
CITY OF CASSVILLE MO • 173 • 174 • Pre-Lining [02 • May • 2023] .....	17
Street: 7TH ST Street: 7TH ST	
CITY OF CASSVILLE MO • 178 • 173 • Pre-Lining [02 • May • 2023] .....	19
Street: 7TH ST Street: 7TH ST	
CITY OF CASSVILLE MO • 179 • 178 • Pre-Lining [19 • Apr • 2023] .....	21
Street: EAST ST Street: EAST ST	
CITY OF CASSVILLE MO • 180 • 219 • Pre-Lining [19 • Apr • 2023] .....	23
Street: WEST ST Street: WEST ST	
CITY OF CASSVILLE MO • 19 • 17 • Pre-Lining [22 • May • 2023] .....	25
Street: FAIR ST Street: FAIR ST	
CITY OF CASSVILLE MO • 190 • 192 • Pre-Lining [02 • May • 2023] .....	27
Street: HIGHWAY 86 Street: HIGHWAY 86	
CITY OF CASSVILLE MO • 21 • 19 • Pre-Lining [22 • May • 2023] .....	29
Street: FAIR ST Street: FAIR ST	
CITY OF CASSVILLE MO • 215 • 177 • Pre-Lining [19 • Apr • 2023] .....	31
Street: EAST ST Street: EAST ST	
CITY OF CASSVILLE MO • 217 • 218 • Pre-Lining [19 • Apr • 2023] .....	33
Street: WEST ST Street: WEST ST	
CITY OF CASSVILLE MO • 218 • 219 • Pre-Lining [19 • Apr • 2023] .....	35
Street: WEST ST Street: WEST ST	
CITY OF CASSVILLE MO • 219 • 615 • Pre-Lining [19 • Apr • 2023] .....	37
Street: 4TH ST Street: 4TH ST	

## Table of Contents (continued)

CITY OF CASSVILLE MO • 229 • 229-A • Pre-Lining [02 • May • 2023] .....	39
Street: HIGHWAY 86    Street: HIGHWAY 86	
CITY OF CASSVILLE MO • 229-A • 190 • Pre-Lining [02 • May • 2023] .....	41
Street: HIGHWAY 86    Street: HIGHWAY 86	
CITY OF CASSVILLE MO • 234 • 48 • Pre-Lining [20 • Apr • 2023] .....	43
Street: TOWNSEND ST    Street: TOWNSEND ST	
CITY OF CASSVILLE MO • 238 • 234 • Pre-Lining [20 • Apr • 2023] .....	45
Street: TOWNSEND ST    Street: TOWNSEND ST	
CITY OF CASSVILLE MO • 239 • 238 • Pre-Lining [20 • Apr • 2023] .....	47
Street: TOWNSEND ST    Street: TOWNSEND ST	
CITY OF CASSVILLE MO • 260 • 261 • Pre-Lining [13 • Apr • 2023] .....	49
Street: IVEY ST    Street: IVEY ST	
CITY OF CASSVILLE MO • 261 • 46 • Pre-Lining [13 • Apr • 2023] .....	51
Street: IVEY ST    Street: IVEY ST	
CITY OF CASSVILLE MO • 262-A • 262 • Pre-Lining [18 • Apr • 2023] .....	53
Street: 13TH ST    Street: 13TH ST	
CITY OF CASSVILLE MO • 307-A • 307 • Pre-Lining [20 • Apr • 2023] .....	55
Street: 11TH ST    Street: 11TH ST	
CITY OF CASSVILLE MO • 338 • 339 • Pre-Lining [19 • Apr • 2023] .....	57
Street: E 13TH ST    Street: E 13TH ST	
CITY OF CASSVILLE MO • 339 • 340 • Pre-Lining [01 • May • 2023] .....	59
Street: 13TH ST    Street: 13TH ST	
CITY OF CASSVILLE MO • 341 • 340 • Pre-Lining [01 • May • 2023] .....	61
Street: WILDWOOD DR    Street: WILDWOOD DR	
CITY OF CASSVILLE MO • 38 • 39 • Pre-Lining [11 • Apr • 2023] .....	63
Street: PRESELY DR    Street: PRESELY DR	
CITY OF CASSVILLE MO • 39 • 40 • Pre-Lining [11 • Apr • 2023] .....	65
Street: PRESELY DR    Street: PRESELY DR	
CITY OF CASSVILLE MO • 40 • 44 • Pre-Lining [03 • May • 2023] .....	67
Street: 11TH ST    Street: 11TH ST	
CITY OF CASSVILLE MO • 41 • 44 • Pre-Lining [12 • Apr • 2023] .....	69
Street: SAPP ST    Street: SAPP ST	
CITY OF CASSVILLE MO • 410 • 341 • Pre-Lining [01 • May • 2023] .....	71
Street: WILDWOOD DR    Street: WILDWOOD DR	
CITY OF CASSVILLE MO • 419 • 421-A • Pre-Lining [11 • Apr • 2023] .....	73
Street: COUNTY FARM ROAD    Street: COUNTY FARM ROAD	
CITY OF CASSVILLE MO • 419-A • 419 • Pre-Lining [11 • Apr • 2023] .....	75
Street: COUNTY FARM ROAD    Street: COUNTY FARM ROAD	


## Table of Contents (continued)

CITY OF CASSVILLE MO • 42 • 43 • Pre-Lining [12 • Apr • 2023] .....	77
Street: SAPP ST    Street: SAPP ST	
CITY OF CASSVILLE MO • 421 • 422 • Pre-Lining [19 • Apr • 2023] .....	79
Street: COUNTY FARM RD    Street: COUNTY FARM RD	
CITY OF CASSVILLE MO • 421-A • 421 • Pre-Lining [11 • Apr • 2023] .....	81
Street: COUNTY FARM ROAD    Street: COUNTY FARM ROAD	
CITY OF CASSVILLE MO • 422 • 40 • Pre-Lining [03 • May • 2023] .....	83
Street: 11TH ST    Street: 11TH ST	
CITY OF CASSVILLE MO • 43 • 41 • Pre-Lining [12 • Apr • 2023] .....	85
Street: SAPP ST    Street: SAPP ST	
CITY OF CASSVILLE MO • 44 • 45 • Pre-Lining [03 • May • 2023] .....	87
Street: 11TH ST    Street: 11TH ST	
CITY OF CASSVILLE MO • 45 • 46 • Pre-Lining [03 • May • 2023] .....	89
Street: 11TH ST    Street: 11TH ST	
CITY OF CASSVILLE MO • 46 • 47 • Pre-Lining [04 • May • 2023] .....	91
Street: 11TH ST    Street: 11TH ST	
CITY OF CASSVILLE MO • 47 • 48 • Pre-Lining [08 • May • 2023] .....	93
Street: 11TH ST    Street: 11TH ST	
CITY OF CASSVILLE MO • 49 • 47 • Pre-Lining [18 • Apr • 2023] .....	95
Street: TOWNSEND ST    Street: TOWNSEND ST	
CITY OF CASSVILLE MO • 498 • 195-A • Pre-Lining [02 • May • 2023] .....	97
Street: FASCO RD    Street: FASCO RD	
CITY OF CASSVILLE MO • 50 • 49 • Pre-Lining [18 • Apr • 2023] .....	99
Street: TOWNSEND ST    Street: TOWNSEND ST	
CITY OF CASSVILLE MO • 522 • 498 • Pre-Lining [02 • May • 2023] .....	101
Street: FASCO RD    Street: FASCO RD	
CITY OF CASSVILLE MO • 556 • 419-A • Pre-Lining [11 • Apr • 2023] .....	103
Street: COUNTY FARM ROAD    Street: COUNTY FARM ROAD	
CITY OF CASSVILLE MO • 580 • 51 • Pre-Lining [18 • Apr • 2023] .....	105
Street: GRAVEL ST    Street: GRAVEL ST	
CITY OF CASSVILLE MO • 6 • 3 • Pre-Lining [13 • Apr • 2023] .....	107
Street: MILL ST    Street: MILL ST	
CITY OF CASSVILLE MO • 615 • 152 • Pre-Lining [19 • Apr • 2023] .....	109
Street: 4TH ST    Street: 4TH ST	
CITY OF CASSVILLE MO • 618 • 190 • Pre-Lining [02 • May • 2023] .....	111
Street: HIGHWAY 86    Street: HIGHWAY 86	
CITY OF CASSVILLE MO • 68 • 69 • Pre-Lining [23 • May • 2023] .....	113
Street: FAIR ST    Street: FAIR ST	



## Inspection Report

### Overview

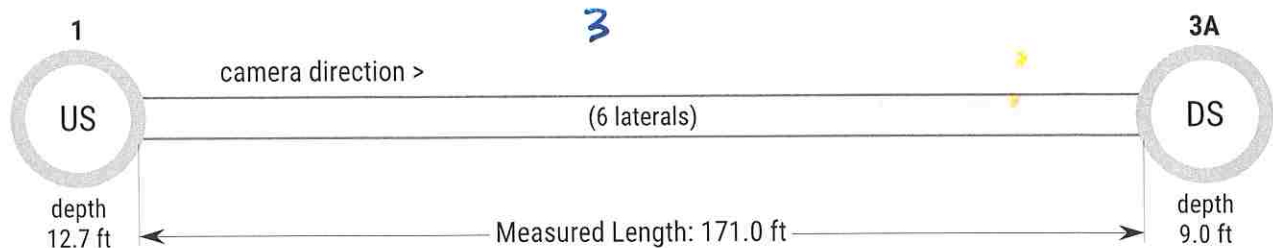

### Asset

Street: MILL ST  
City: CASSVILLE MO  
Pipe Use: Sanitary Sewage Pipe  
Pipe Geometry: 8 in (Circular)  
Material: Vitrified Clay Pipe  
Map #/Plan File: 14  
Drainage Area:  
Flow Direction: ↓ South  
Surface: Asphalt


### Inspection

Customer: ROSETTA CONSTRUCTION  
Project:  
Job #: 23010MO-11  
Media Date/Time: 2023/04/13 04:48  
Surveyed By: TYLER (P0038607-072022)  
Supervisor: DOUG B  
Pre-Cleaning: Light Cleaning  
Truck: 211MO  
Weather: Dry - No Precipitation During Survey  
Additional Info: MAHOLE 3A IS NOT ON MAPS, HAS DROP IN DOWN STREAM MANHOLE BUT APPEARS TO BE CAPPED OR BLOCKED

7895 St. Claire Ave, East St. Louis, IL 62207




## Observations

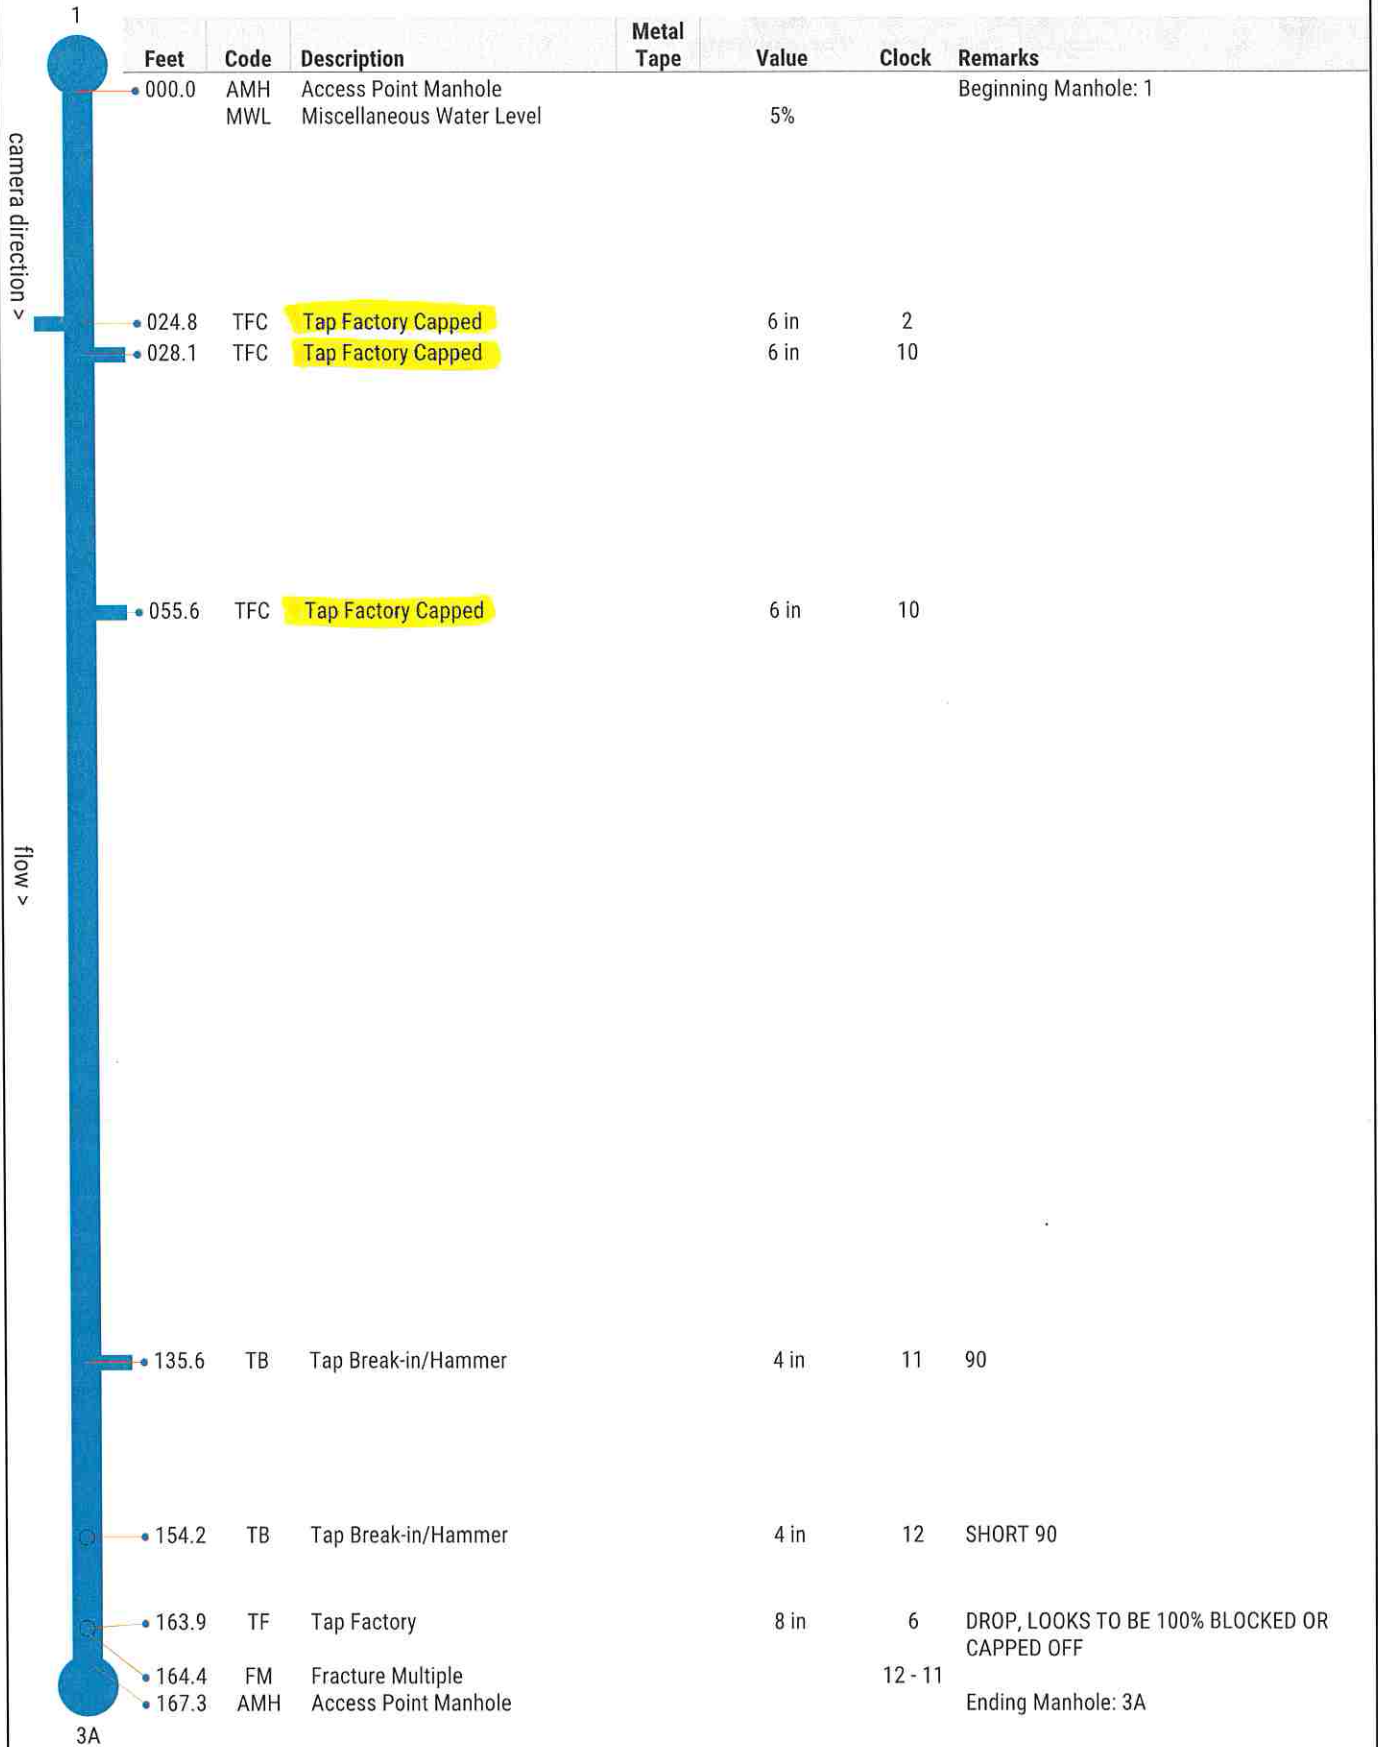

## Inspection Report

### Overview

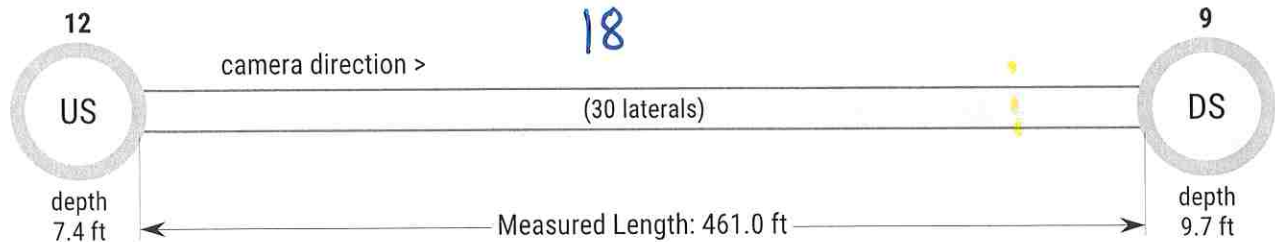

### Asset

Street: HAROLD ST  
City: CASSVILLE MO  
Pipe Use: Sanitary Sewage Pipe  
Pipe Geometry: 8 in (Circular)  
Material: Vitrified Clay Pipe  
Map #/Plan File: 15  
Drainage Area:  
Flow Direction: ✓ Southwest  
Surface: Asphalt

### Inspection

Customer: ROSETTA CONSTRUCTION  
Project:  
Job #: 23010MO-11  
Media Date/Time: 2023/05/03 01:03  
Surveyed By: TYLER (P0038607-072022)  
Supervisor: DOUG B  
Pre-Cleaning: Light Cleaning  
Truck: 211MO  
Weather: Dry - No Precipitation During Survey  
Additional Info:

7895 St. Claire Ave, East St. Louis, IL 62207


## Observations

	Feet	Code	Description	Metal Tape	Value	Clock	Remarks
camera direction >	12	• 000.0	AMH Access Point Manhole				Beginning Manhole: 12
			MWL Miscellaneous Water Level		5%		
	• 000.8	TB	Tap Break-in/Hammer		4 in	12	SHORT 90
	• 002.1	TFC	Tap Factory Capped		6 in	9	
	• 005.0	TFC	Tap Factory Capped		6 in	2	
	• 006.1	TB	Tap Break-in/Hammer		4 in	12	90 PVC
	• 015.0	TB	Tap Break-in/Hammer		4 in	12	90 PVC
	• 016.5	TB	Tap Break-in/Hammer		4 in	12	90 PVC
	• 017.6	JOM	Joint Offset Medium				
	• 023.5	TFC	Tap Factory Capped		6 in	3	
flow >	• 035.7	TFC	Tap Factory Capped		6 in	10	
	• 066.1	TFC	Tap Factory Capped		6 in	2	
	• 069.2	TB	Tap Break-in/Hammer		4 in	12	90 PVC
	• 078.5	TF	Tap Factory		6 in	9	
	• 127.2	TFC	Tap Factory Capped		6 in	10	
	• 139.2	TF	Tap Factory		6 in	2	LATERAL IS A 4IN INSIDE FACTORY CONNECTION
	• 158.5	TB	Tap Break-in/Hammer		4 in	12	90
	• 160.6	TB	Tap Break-in/Hammer		4 in	12	SHORT 90
	• 166.2	TB	Tap Break-in/Hammer		4 in	12	90
	• 181.6	TFC	Tap Factory Capped		6 in	10	
	• 193.7	TFC	Tap Factory Capped		6 in	2	
	• 197.2	TB	Tap Break-in/Hammer		4 in	12	90
	• 248.4	TFC	Tap Factory Capped		6 in	2	
	• 260.6	TFC	Tap Factory Capped		6 in	10	
	• 268.4	TB	Tap Break-in/Hammer		4 in	12	90
	• 298.0	TB	Tap Break-in/Hammer		4 in	12	
	• 306.1	TF	Tap Factory		6 in	2	
	• 335.3	TB	Tap Break-in/Hammer		4 in	12	SHORT 90
	• 342.6	TFC	Tap Factory Capped		6 in	2	
	• 347.5	TB	Tap Break-in/Hammer		4 in	12	90 AND LATERAL HAS CRACKED PIPE AROUND IT
	• 351.8	TB	Tap Break-in/Hammer		4 in	2	
	• 373.2	TFC	Tap Factory Capped		6 in	10	
	• 379.0	TF	Tap Factory		6 in	3	
	• 456.0	AMH	Access Point Manhole				Ending Manhole: 9
9							



## Inspection Report

### Overview

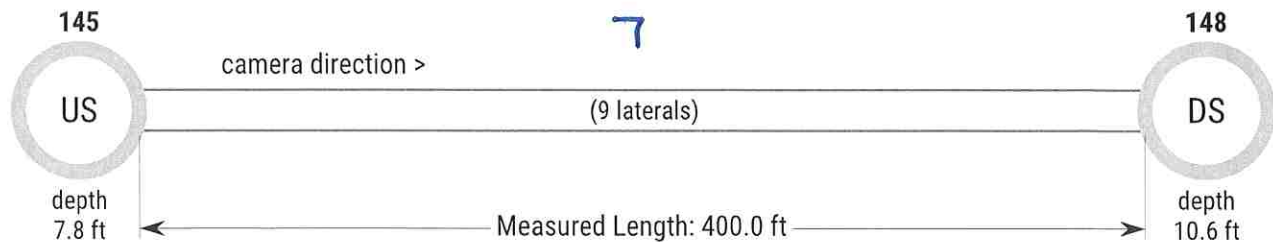

### Asset


Street: MAIN ST  
City: CASSVILLE MO  
Pipe Use: Sanitary Sewage Pipe  
Pipe Geometry: 8 in (Circular)  
Material: Vitrified Clay Pipe  
Map #/Plan File: 17  
Drainage Area:  
Flow Direction: ↗Northeast  
Surface: Gravel

### Inspection

Customer: ROSETTA CONSTRUCTION  
Project:  
Job #: 23010MO-11  
Media Date/Time: 2023/04/19 08:08  
Surveyed By: TYLER (P0038607-072022)  
Supervisor: DOUG B  
Pre-Cleaning: Heavy Cleaning  
Truck: 211MO  
Weather: Dry - No Precipitation During Survey  
Additional Info: RECOMMEND BYPASS, RAN ROOT SAW TO CUT OFF TWO TAPS


7895 St. Claire Ave, East St. Louis, IL 62207

## Observations

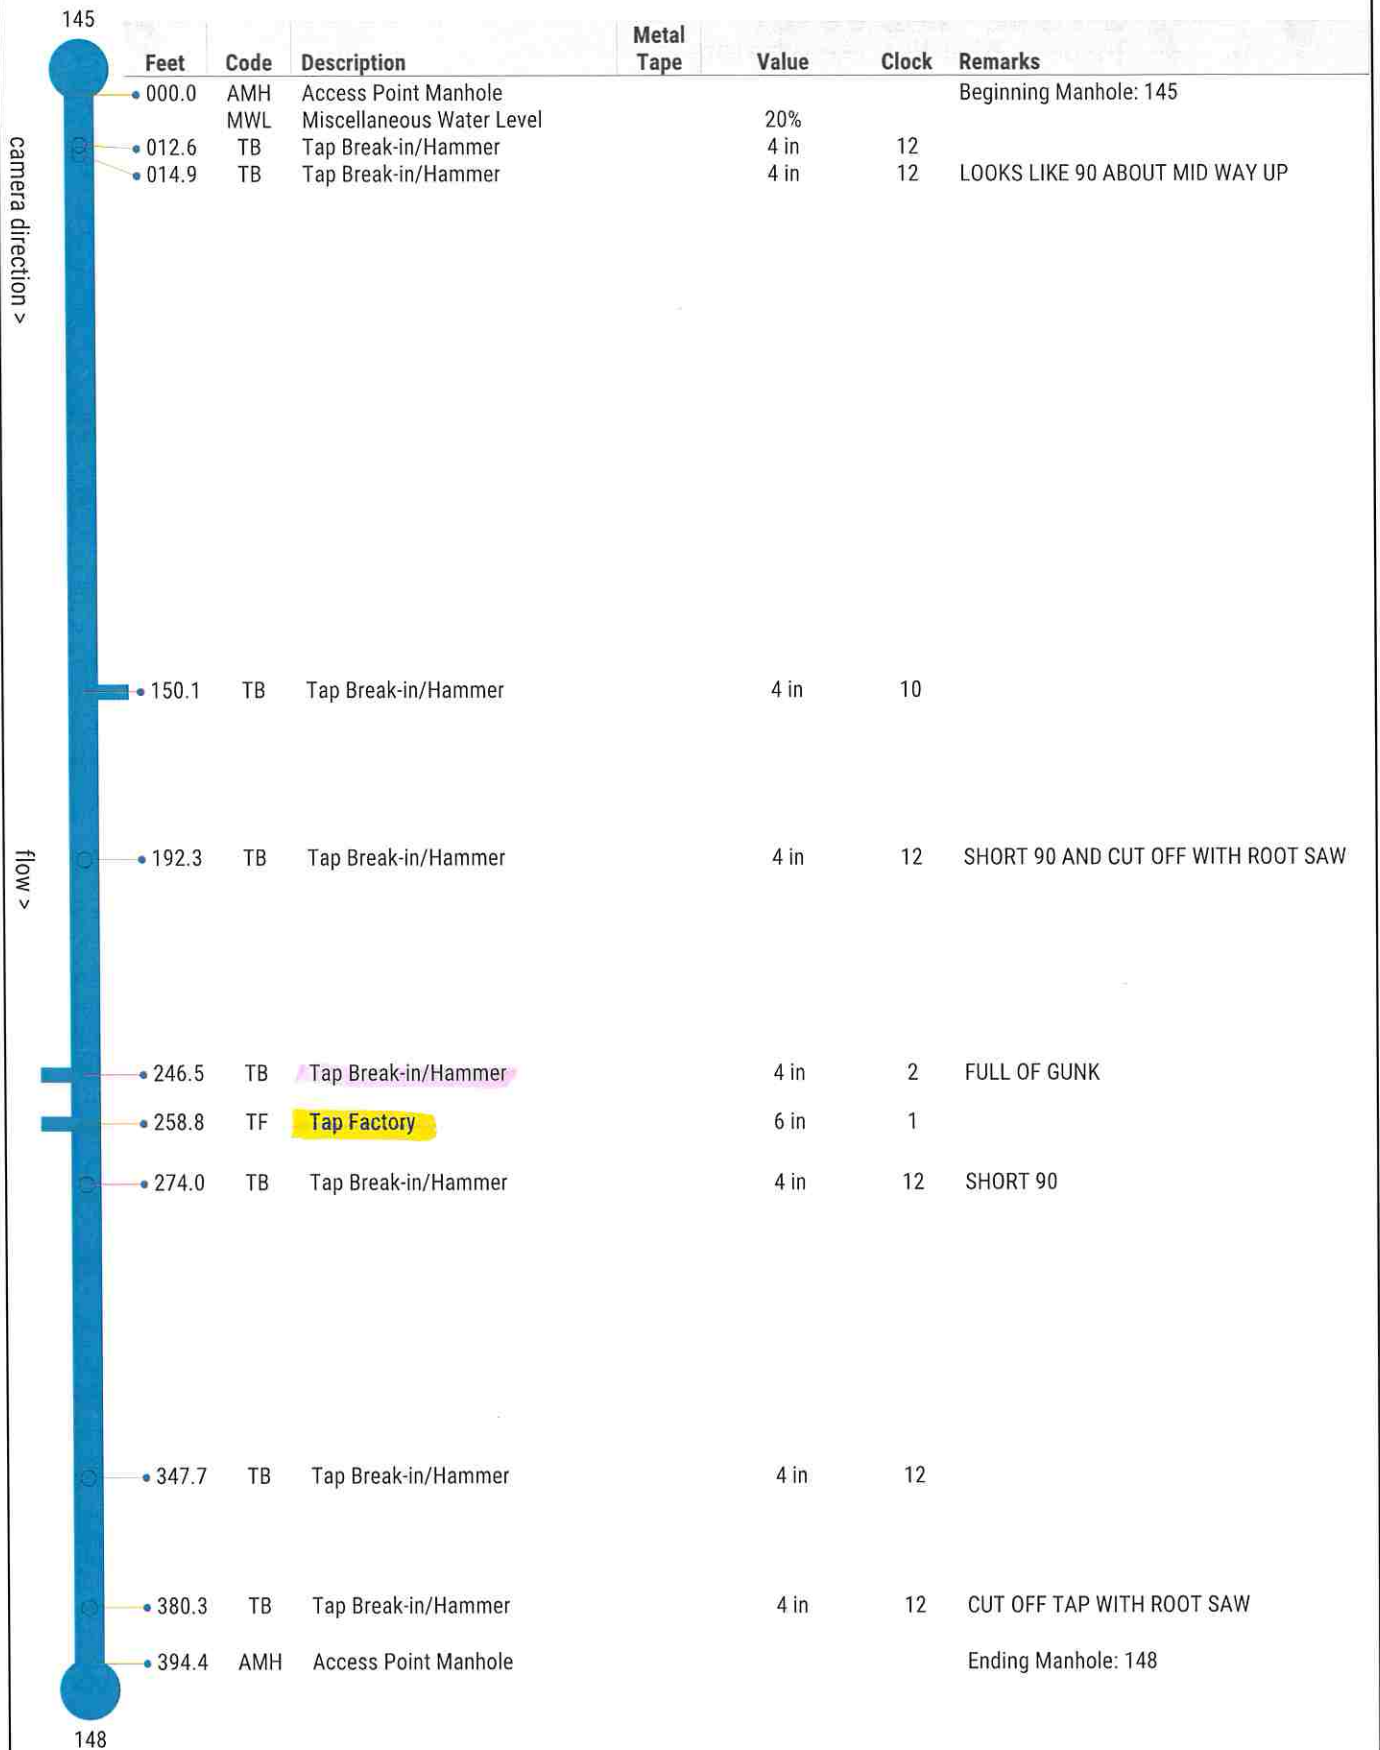

## Inspection Report

### Overview

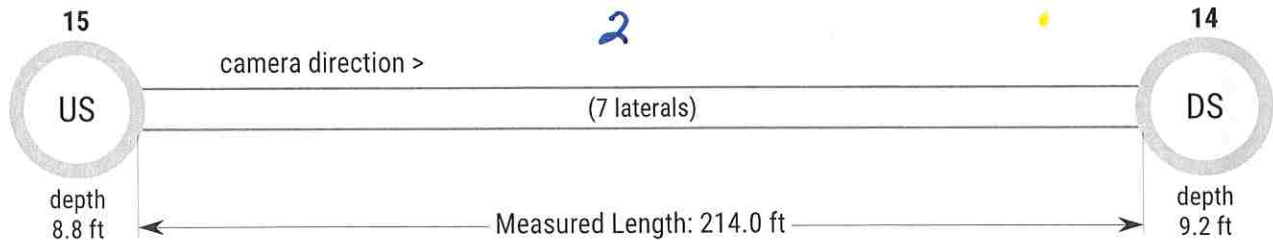

### Asset


Street: HAROLD ST  
City: CASSVILLE MO  
Pipe Use: Sanitary Sewage Pipe  
Pipe Geometry: 8 in (Circular)  
Material: Vitrified Clay Pipe  
Map #/Plan File: 15  
Drainage Area:  
Flow Direction: ✓ Southwest  
Surface: Asphalt

### Inspection

Customer: ROSETTA CONSTRUCTION  
Project:  
Job #: 23010MO-11  
Media Date/Time: 2023/05/04 09:13  
Surveyed By: TYLER (P0038607-072022)  
Supervisor: DOUG B  
Pre-Cleaning: Heavy Cleaning  
Truck: 211MO  
Weather: Dry - No Precipitation During Survey  
Additional Info:


7895 St. Claire Ave, East St. Louis, IL 62207

## Observations

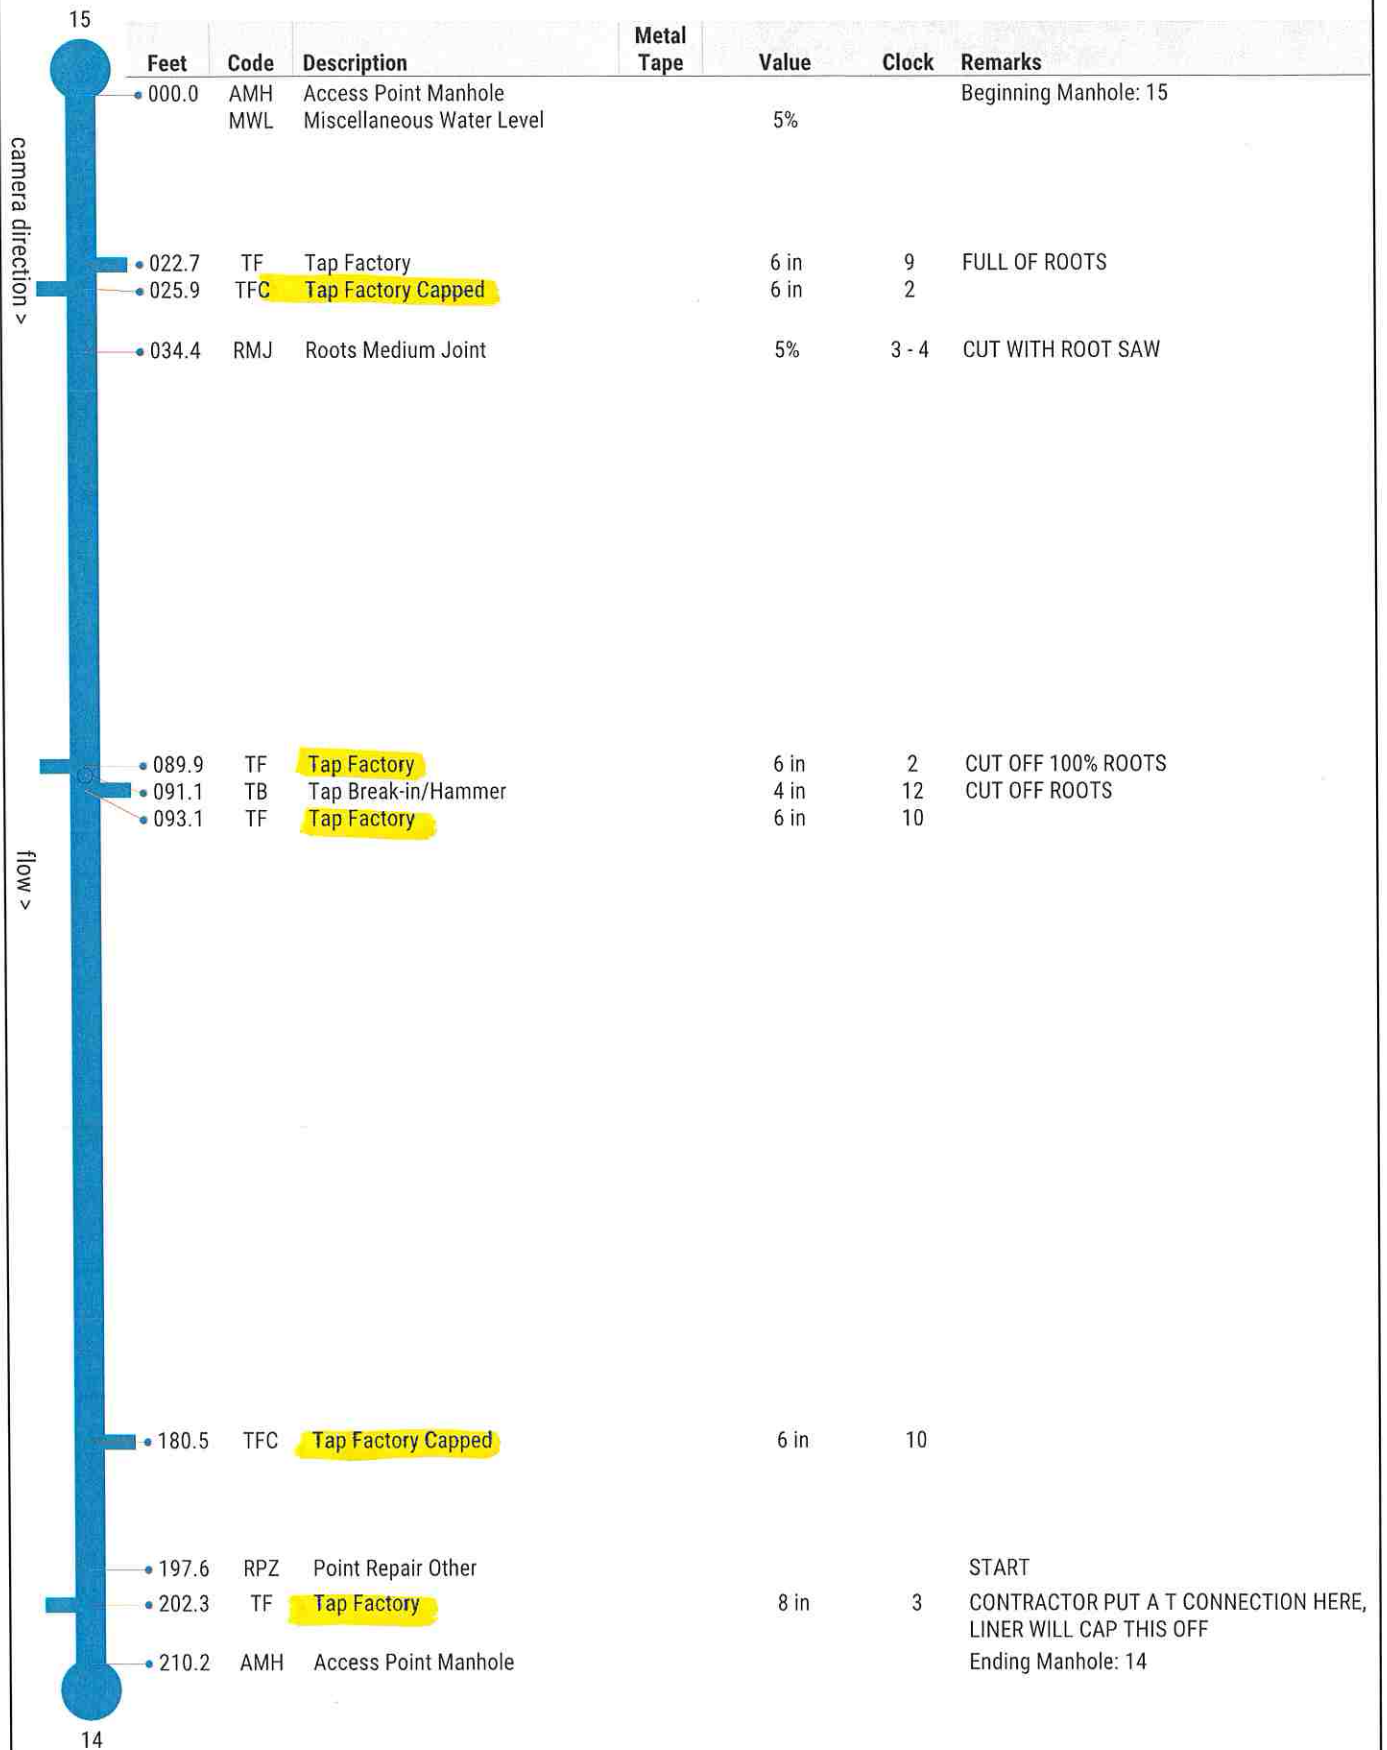

## Inspection Report

### Overview

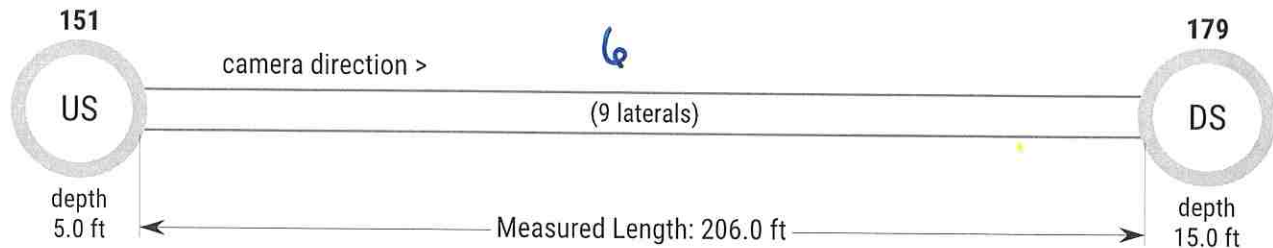

### Asset

Street: EAST ST  
City: CASSVILLE MO  
Pipe Use: Sanitary Sewage Pipe  
Pipe Geometry: 8 in (Circular)  
Material: Vitrified Clay Pipe  
Map #/Plan File: 17  
Drainage Area:  
Flow Direction: ↑ North  
Surface: Asphalt


### Inspection

Customer: ROSETTA CONSTRUCTION  
Project:  
Job #: 23010MO-11  
Media Date/Time: 2023/04/19 04:30  
Surveyed By: TYLER (P0038607-072022)  
Supervisor: DOUG B  
Pre-Cleaning: Light Cleaning  
Truck: 211MO  
Weather: Dry - No Precipitation During Survey  
Additional Info: WILL NEED TO HAVE A LATERAL CUT WITH CUT TRUCK, LOOK AT VIDEO

7895 St. Claire Ave, East St. Louis, IL 62207




## Observations

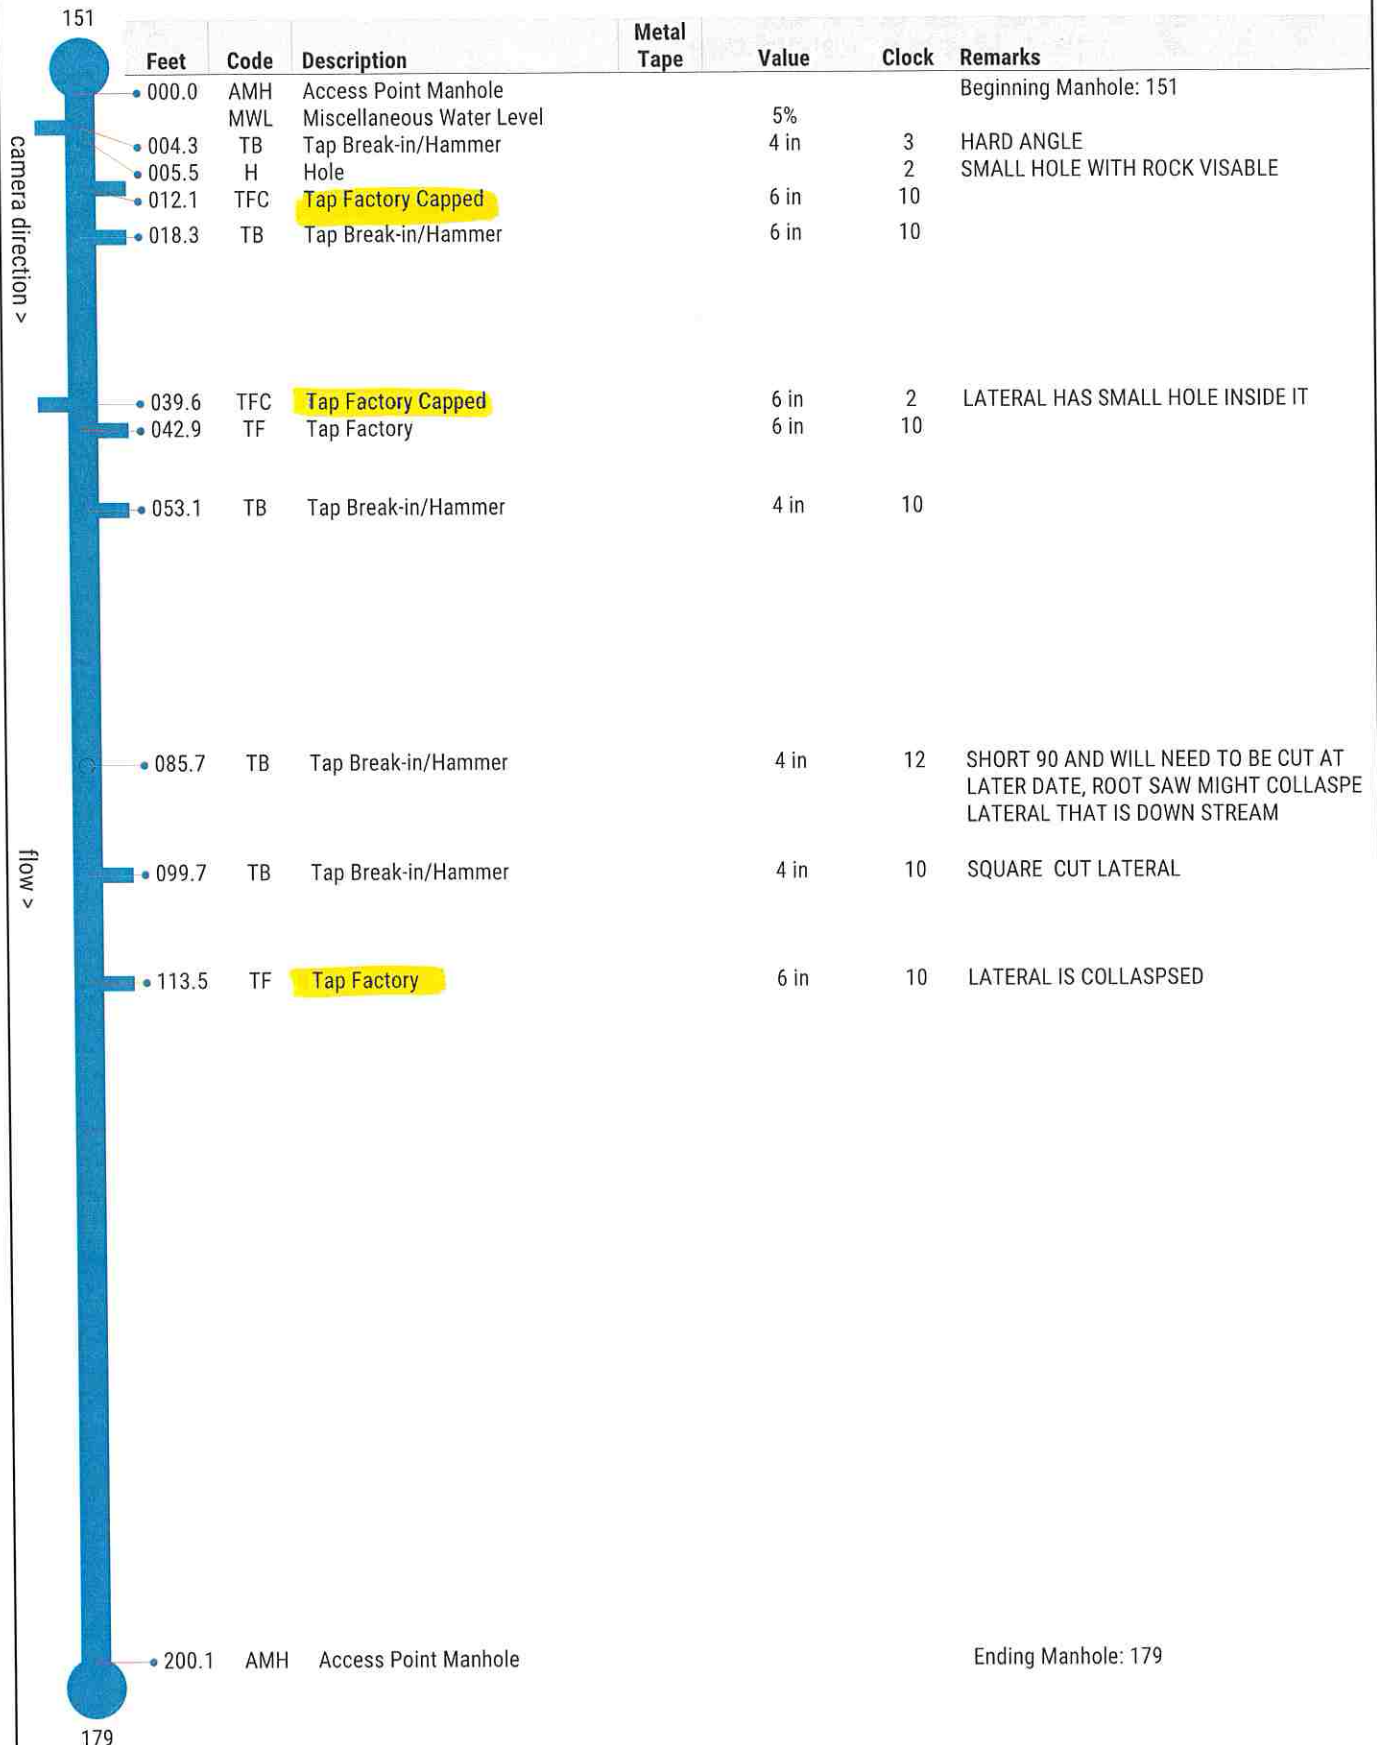

## Inspection Report

### Overview

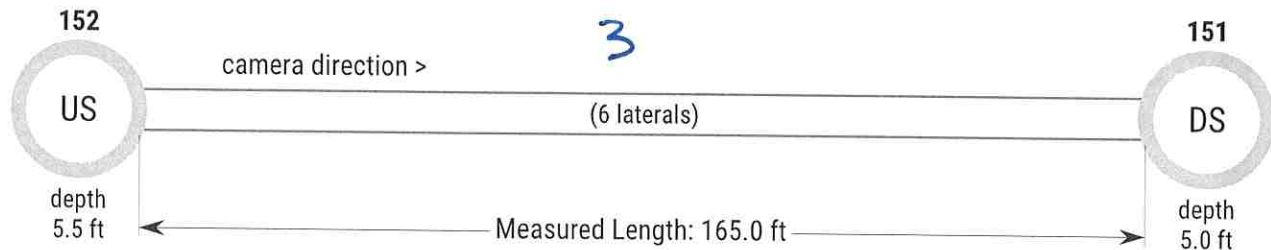

### Asset


Street: EAST ST  
City: CASSVILLE MO  
Pipe Use: Sanitary Sewage Pipe  
Pipe Geometry: 8 in (Circular)  
Material: Vitrified Clay Pipe  
Map #/Plan File: 17  
Drainage Area:  
Flow Direction: ↑ North  
Surface: Asphalt

### Inspection

Customer: ROSETTA CONSTRUCTION  
Project:  
Job #: 23010MO-11  
Media Date/Time: 2023/04/19 04:15  
Surveyed By: TYLER (P0038607-072022)  
Supervisor: DOUG B  
Pre-Cleaning: Light Cleaning  
Truck: 211MO  
Weather: Dry - No Precipitation During Survey  
Additional Info:

7895 St. Claire Ave, East St. Louis, IL 62207


## Observations

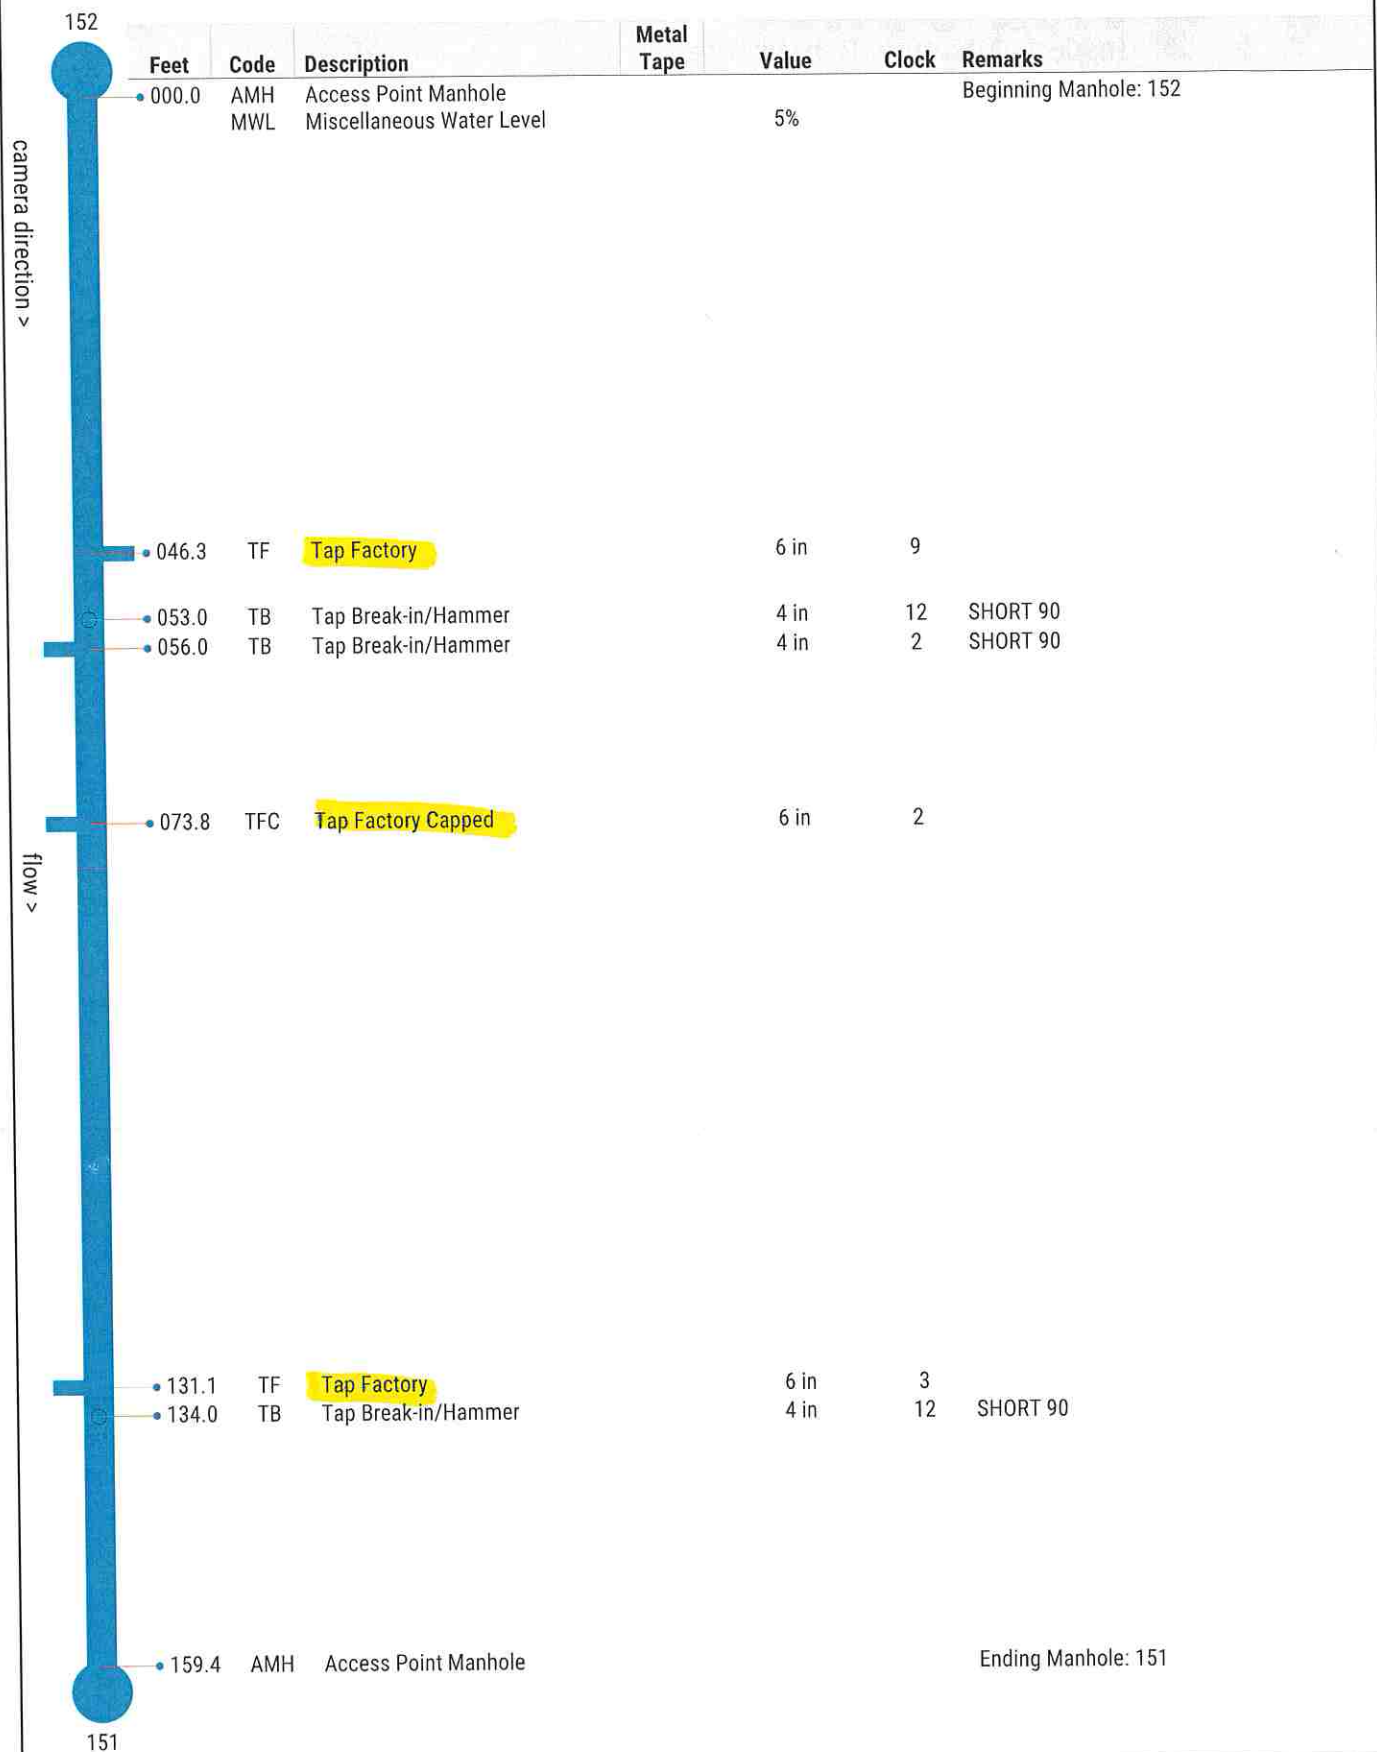



## Inspection Report

### Overview

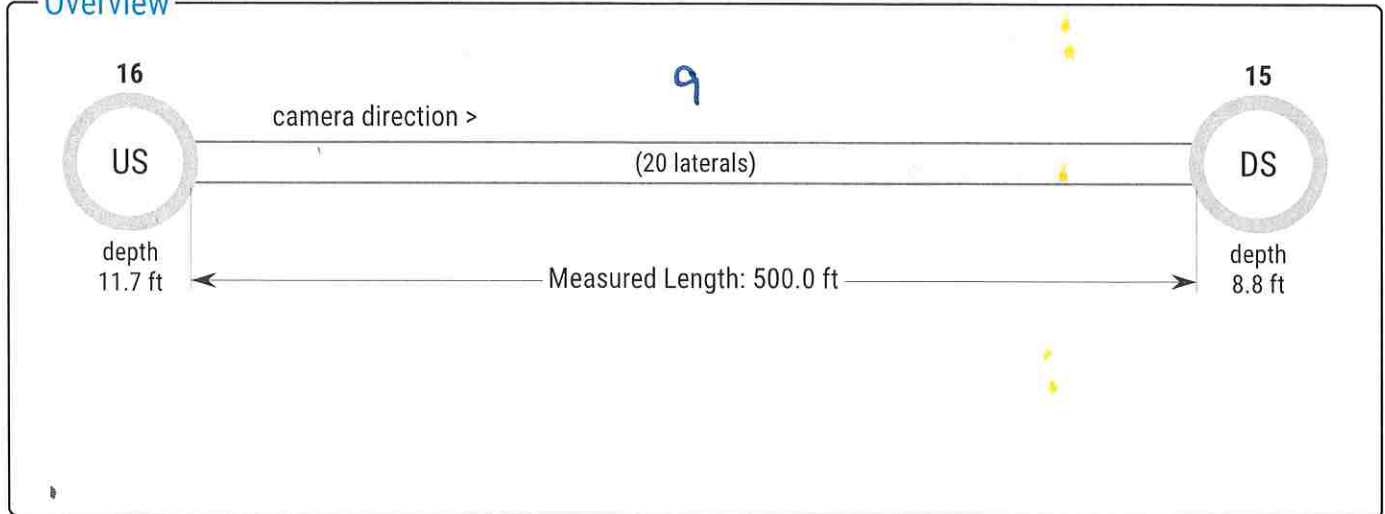

### Asset

Street: HAROLD ST  
City: CASSVILLE MO  
Pipe Use: Sanitary Sewage Pipe  
Pipe Geometry: 8 in (Circular)  
Material: Vitrified Clay Pipe  
Map #/Plan File: 15  
Drainage Area:  
Flow Direction: ✓ Southwest  
Surface: Asphalt

### Inspection

Customer: ROSETTA CONSTRUCTION  
Project:  
Job #: 23010MO-11  
Media Date/Time: 2023/05/04 08:10  
Surveyed By: TYLER (P0038607-072022)  
Supervisor: DOUG B  
Pre-Cleaning: Light Cleaning  
Truck: 211MO  
Weather: Dry - No Precipitation During Survey  
Additional Info:

7895 St. Claire Ave, East St. Louis, IL 62207


## Observations

	Feet	Code	Description	Metal Tape	Value	Clock	Remarks
16	000.0	AMH	Access Point Manhole				Beginning Manhole: 16
		MWL	Miscellaneous Water Level		5%		
	011.5	TB	Tap Break-in/Hammer		4 in	12	
	016.8	TF	Tap Factory		6 in	2	OFFSET INSIDE
	044.2	TFC	Tap Factory Capped		6 in	10	
	047.4	TFC	Tap Factory Capped		6 in	2	
	054.7	H	Hole			11 - 3	APPEARS TO BE CAPPED?
	058.6	TB	Tap Break-in/Hammer		4 in	12	
	093.0	TFC	Tap Factory Capped		6 in	10	
	095.2	JOM	Joint Offset Medium				
	106.5	TB	Tap Break-in/Hammer		4 in	12	
	114.4	TF	Tap Factory		6 in	2	
	147.9	TFC	Tap Factory Capped		6 in	10	
	157.0	TFC	Tap Factory Capped		6 in	2	
	265.6	TFC	Tap Factory Capped		6 in	10	
	282.2	TB	Tap Break-in/Hammer		4 in	12	
	286.7	TF	Tap Factory		6 in	2	
	319.9	TFC	Tap Factory Capped		6 in	2	
	332.0	TFC	Tap Factory Capped		4 in	2	
	332.8	TB	Tap Break-in/Hammer		4 in	12	
	364.9	TFC	Tap Factory Capped		6 in	10	
	392.1	TFC	Tap Factory Capped		6 in	2	
	425.6	TF	Tap Factory		6 in	12	SHORT 90
	439.4	RTJ	Roots Tap Joint		5%	8 - 9	
	440.3	TFC	Tap Factory Capped		6 in	2	ROOTS INSIDE LATERAL
	487.9	RTJ	Roots Tap Joint		5%	8 - 10	ROOTS CUT OFF WITH WARTHOG
15	494.0	AMH	Access Point Manhole				Ending Manhole: 15



## Inspection Report

### Overview

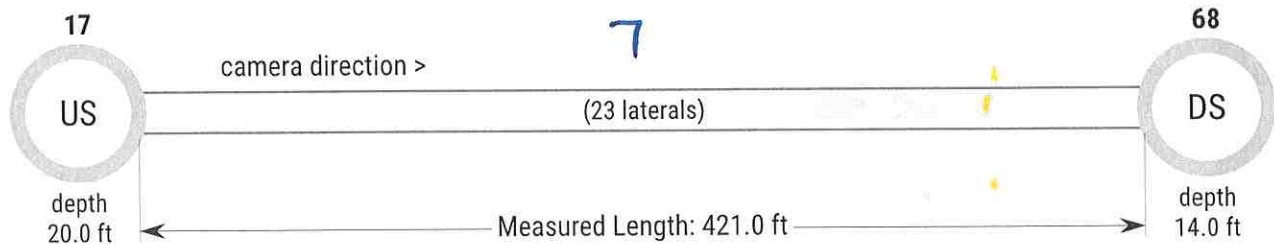

### Asset

Street: FAIR ST  
City: CASSVILLE MO  
Pipe Use: Sanitary Sewage Pipe  
Pipe Geometry: 10 in (Circular)  
Material: Vitrified Clay Pipe  
Map #/Plan File: 16  
Drainage Area:  
Flow Direction: ↗Northeast  
Surface: Asphalt

### Inspection

Customer: ROSETTA CONSTRUCTION  
Project:  
Job #: 23010MO-11  
Media Date/Time: 2023/05/23 08:10  
Surveyed By: TYLER (P0038607-072022)  
Supervisor: JAMES  
Pre-Cleaning: Heavy Cleaning  
Truck: 211MO  
Weather: Dry - No Precipitation During Survey  
Additional Info: RAN ROOT SAW


7895 St. Claire Ave, East St. Louis, IL 62207

## Observations

camera direction >	Feet	Code	Description	Metal Tape	Value	Clock	Remarks
17	000.0	AMH	Access Point Manhole				Beginning Manhole: 17
		MWL	Miscellaneous Water Level		10%		
	010.7	TF	Tap Factory		6 in	10	SHORT 90
	065.7	TFC	Tap Factory Capped		6 in	2	
	071.7	TFC	Tap Factory Capped		6 in	10	
	084.7	TB	Tap Break-in/Hammer		6 in	12	
	096.5	TFC	Tap Factory Capped		6 in	3	
	129.7	TF	Tap Factory		6 in	9	LATERAL COLLAPSE
	148.0	TFC	Tap Factory Capped		6 in	2	
	152.7	TB	Tap Break-in/Hammer		6 in	2	100% FULL OF ROOTS
	163.0	TF	Tap Factory		6 in	11	100% FULL OF ROOTS
	164.3	TB	Tap Break-in/Hammer		4 in	12	CUT ROOTS AND TAP OFF
	166.1	TB	Tap Break-in/Hammer		4 in	12	CUT ROOTS AND TAP OFF
	175.7	TFC	Tap Factory Capped		6 in	2	
	186.3	TB	Tap Break-in/Hammer		4 in	12	
flow >	211.8	TFC	Tap Factory Capped		6 in	10	
	230.2	TFC	Tap Factory Capped		6 in	2	
	260.7	TFC	Tap Factory Capped		6 in	11	
	279.2	TFC	Tap Factory Capped		6 in	2	
	285.4	TB	Tap Break-in/Hammer		4 in	12	100 % FULL OF GREASE
	313.3	TB	Tap Break-in/Hammer		4 in	12	
	315.2	TFC	Tap Factory Capped		6 in	10	
	318.6	TB	Tap Break-in/Hammer		4 in	12	
	345.9	TFC	Tap Factory Capped		6 in	2	
	363.5	TFC	Tap Factory Capped		6 in	10	
68	415.2	AMH	Access Point Manhole				Ending Manhole: 68

## Inspection Report

### Overview

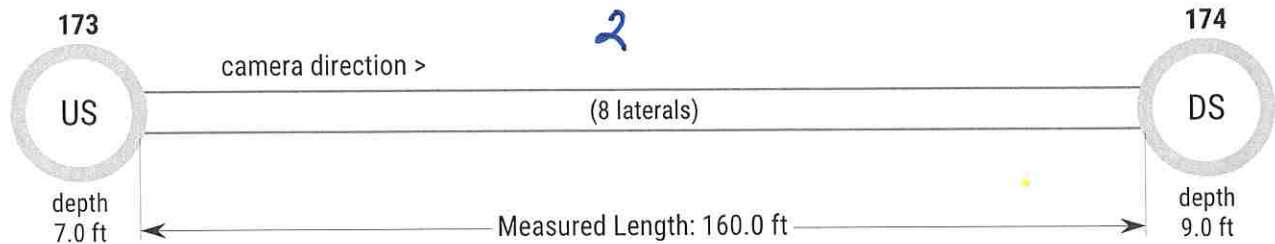

### Asset


Street: 7TH ST  
City: CASSVILLE MO  
Pipe Use: Sanitary Sewage Pipe  
Pipe Geometry: 8 in (Circular)  
Material: Vitrified Clay Pipe  
Map #/Plan File: 17  
Drainage Area:  
Flow Direction: ↑ North  
Surface: Asphalt

### Inspection

Customer: ROSETTA CONSTRUCTION  
Project:  
Job #: 23010MO-11  
Media Date/Time: 2023/05/02 05:27  
Surveyed By: TYLER (P0038607-072022)  
Supervisor: DOUG B  
Pre-Cleaning: Heavy Cleaning  
Truck: 211MO  
Weather: Dry - No Precipitation During Survey  
Additional Info: RAN ROOT SAW TO CUT TAP


7895 St. Claire Ave, East St. Louis, IL 62207

## Observations

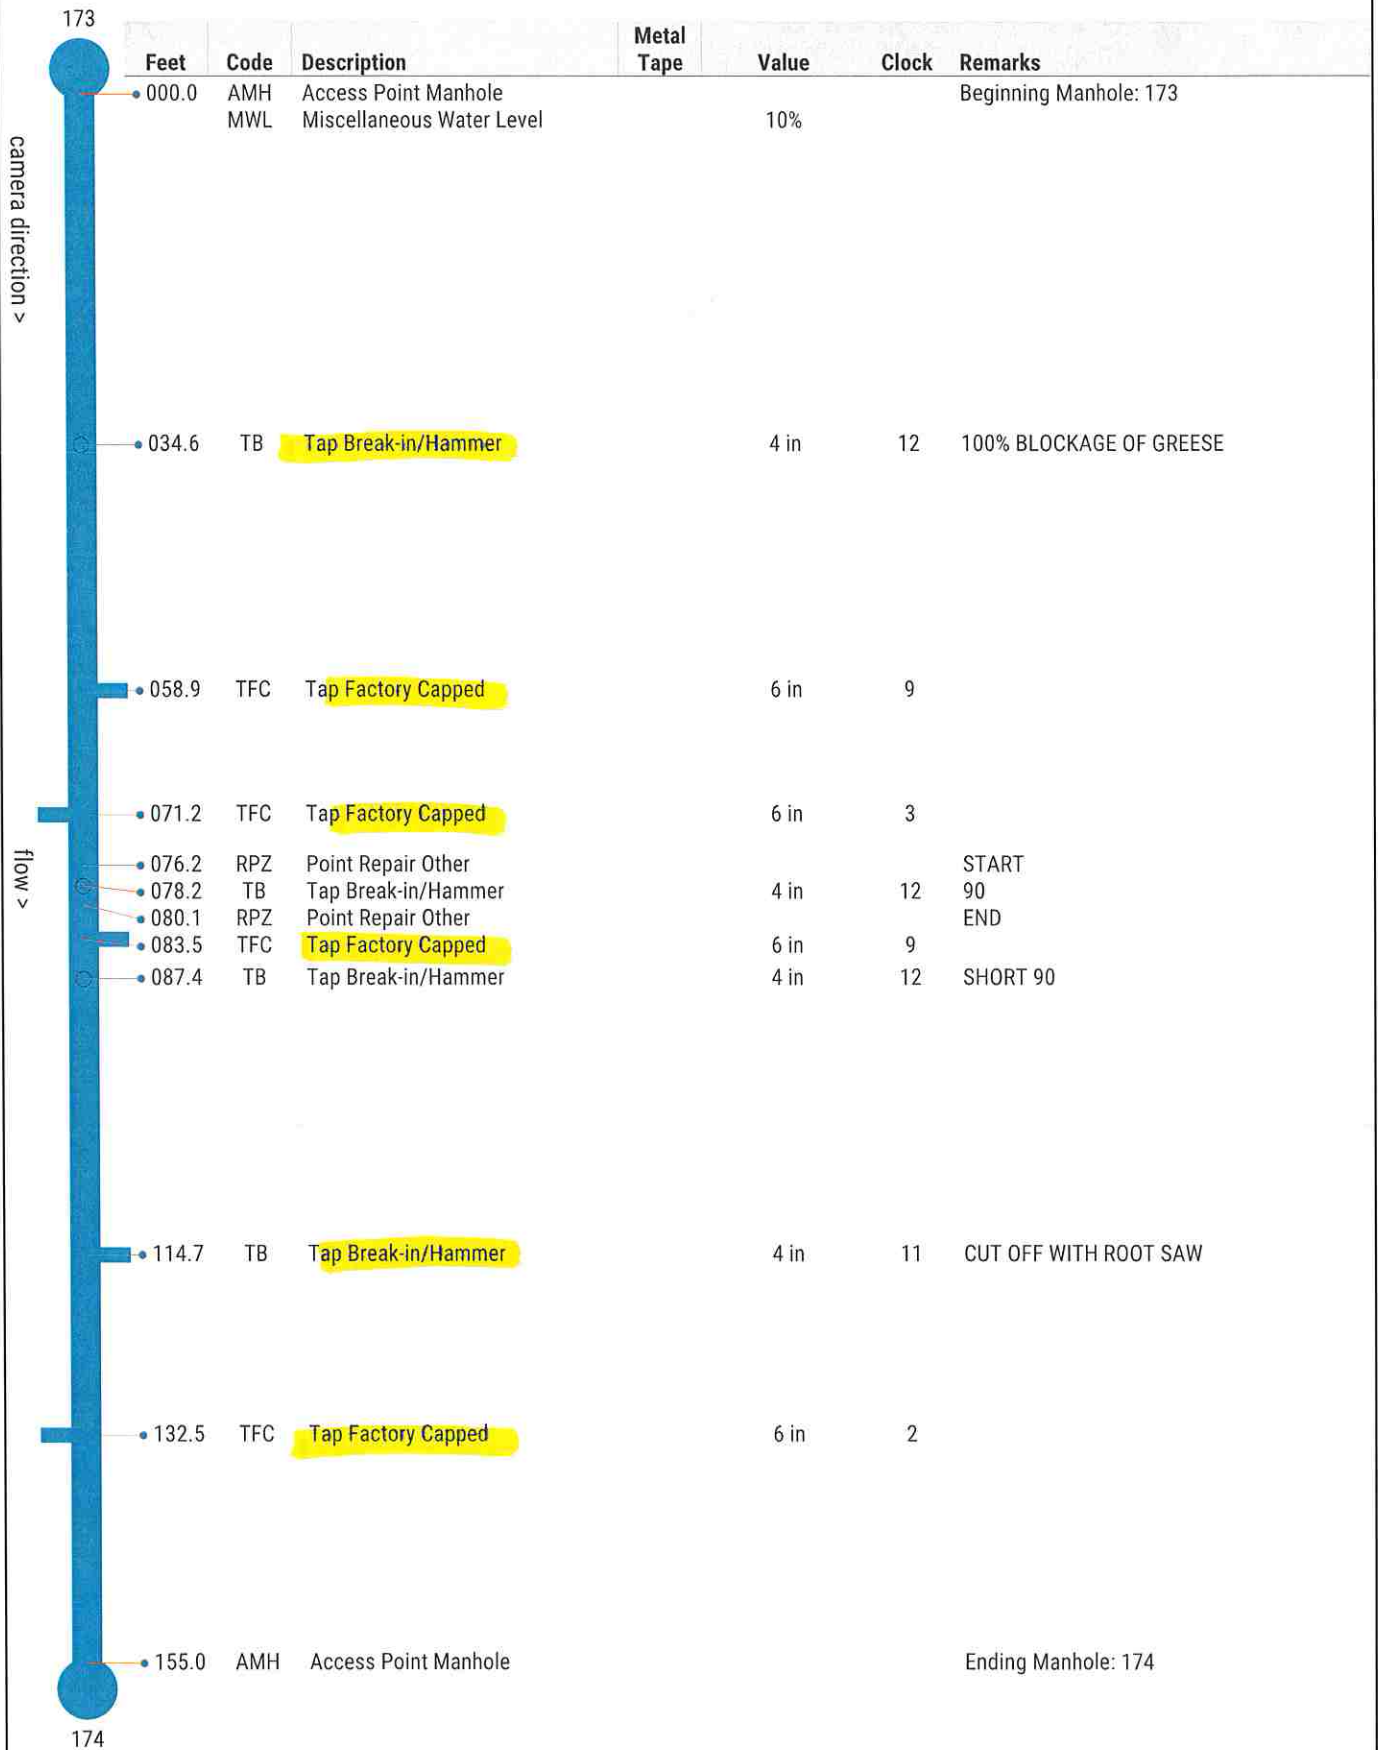

## Inspection Report

### Overview

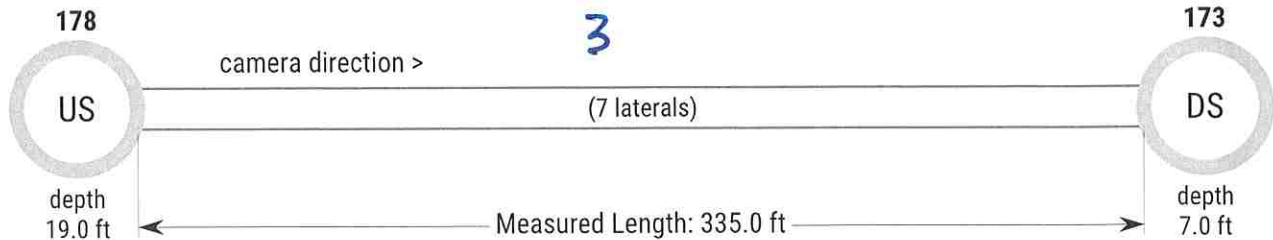

### Asset

Street: 7TH ST  
City: CASSVILLE MO  
Pipe Use: Sanitary Sewage Pipe  
Pipe Geometry: 8 in (Circular)  
Material: Vitrified Clay Pipe  
Map #/Plan File: 17  
Drainage Area:  
Flow Direction: →East  
Surface: Asphalt


### Inspection

Customer: ROSETTA CONSTRUCTION  
Project:  
Job #: 23010MO-11  
Media Date/Time: 2023/05/02 04:24  
Surveyed By: TYLER (P0038607-072022)  
Supervisor: DOUG B  
Pre-Cleaning: Light Cleaning  
Truck: 211MO  
Weather: Dry - No Precipitation During Survey  
Additional Info:

7895 St. Claire Ave, East St. Louis, IL 62207




## Observations

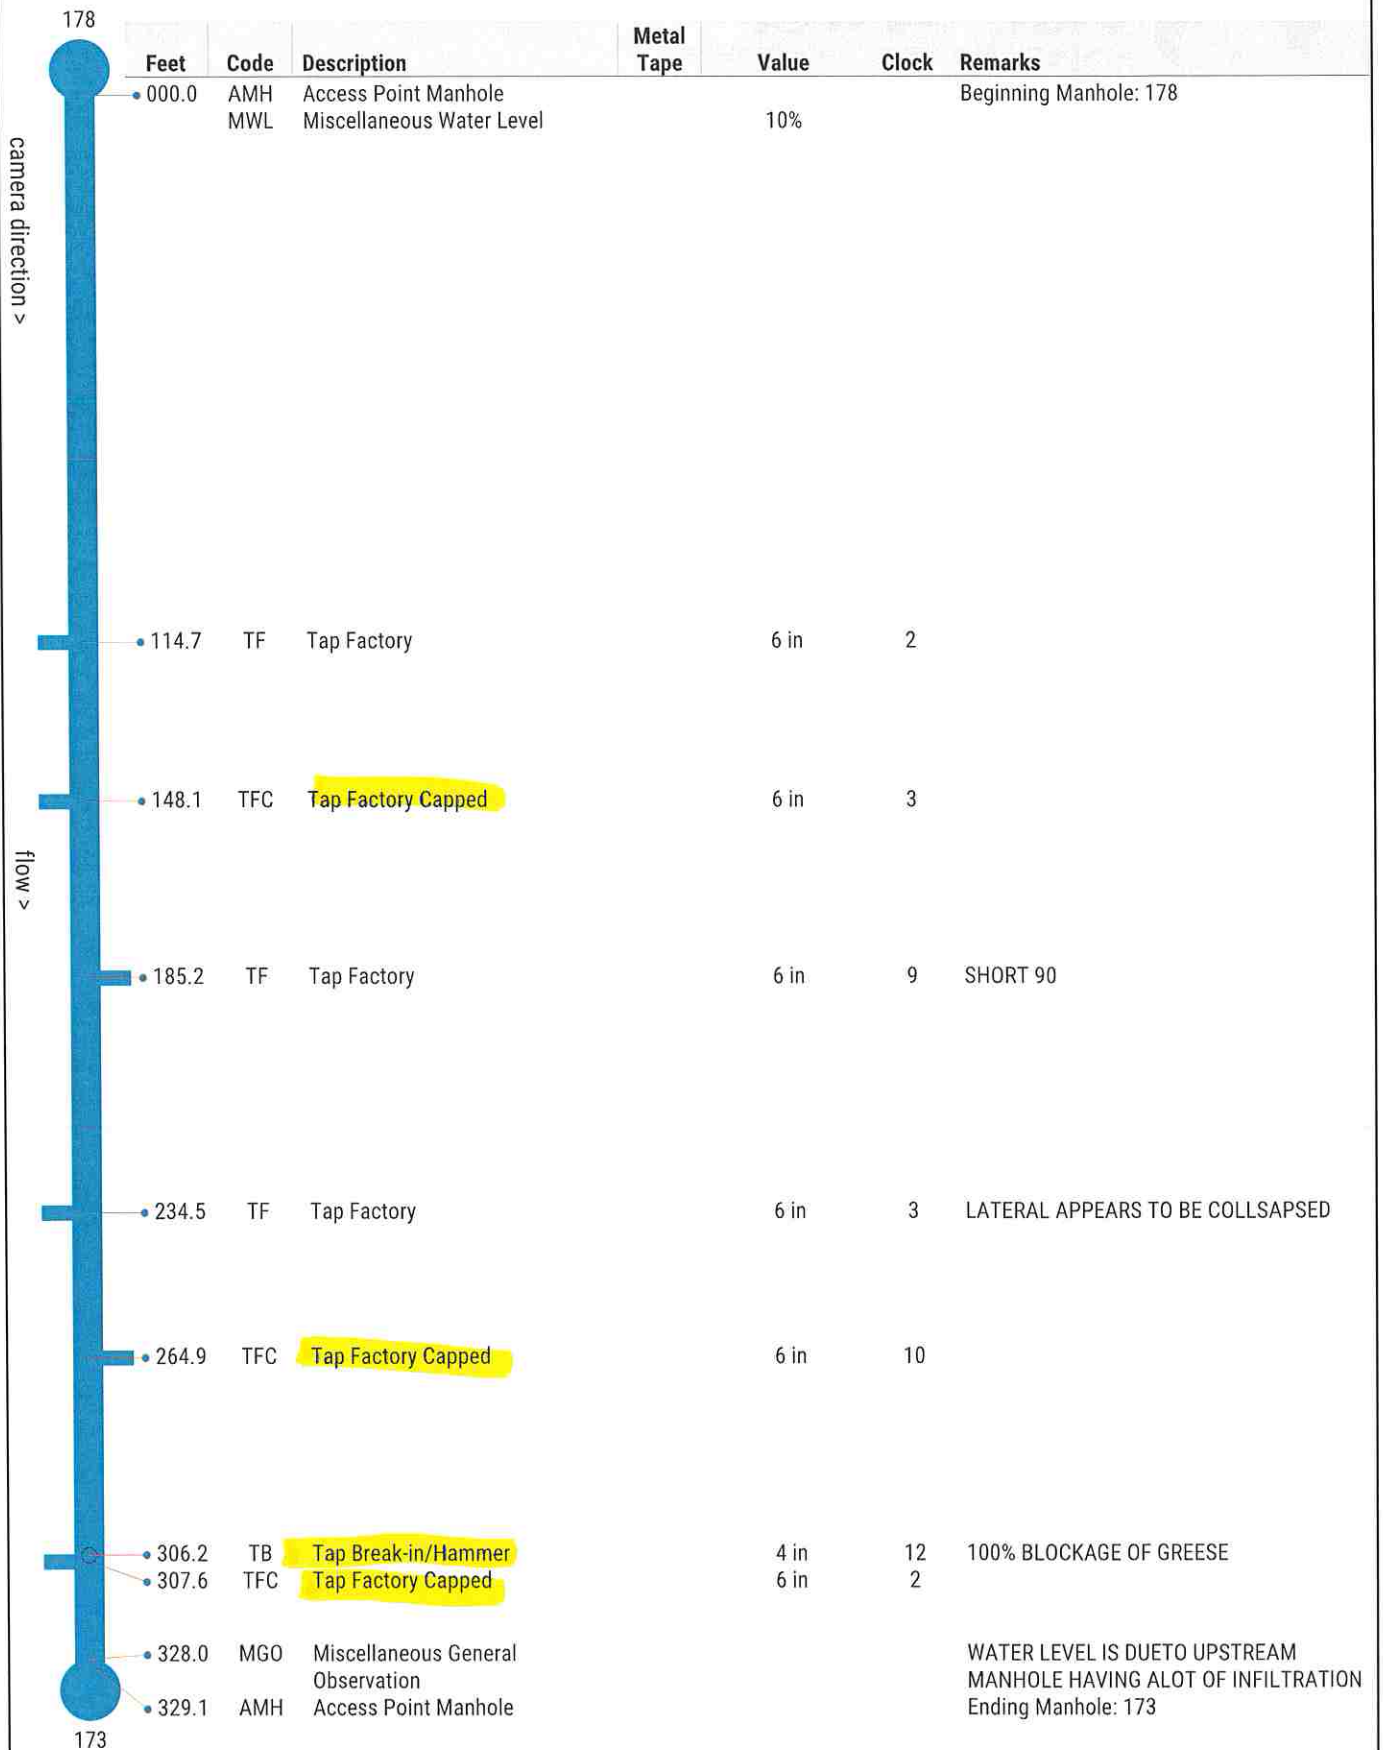

## Inspection Report

### Overview

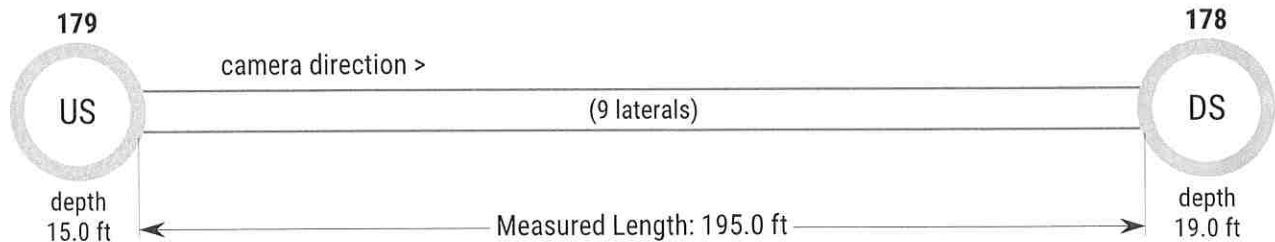

### Asset


Street: EAST ST  
City: CASSVILLE MO  
Pipe Use: Sanitary Sewage Pipe  
Pipe Geometry: 8 in (Circular)  
Material: Vitrified Clay Pipe  
Map #/Plan File: 17  
Drainage Area:  
Flow Direction: ↑ North  
Surface: Asphalt

### Inspection

Customer: ROSETTA CONSTRUCTION  
Project:  
Job #: 23010MO-11  
Media Date/Time: 2023/04/19 05:10  
Surveyed By: TYLER (P0038607-072022)  
Supervisor: DOUG B  
Pre-Cleaning: Light Cleaning  
Truck: 211MO  
Weather: Dry - No Precipitation During Survey  
Additional Info: DOWN STREAM MANHOLE DEEP AND A DROP


7895 St. Claire Ave, East St. Louis, IL 62207

## Observations

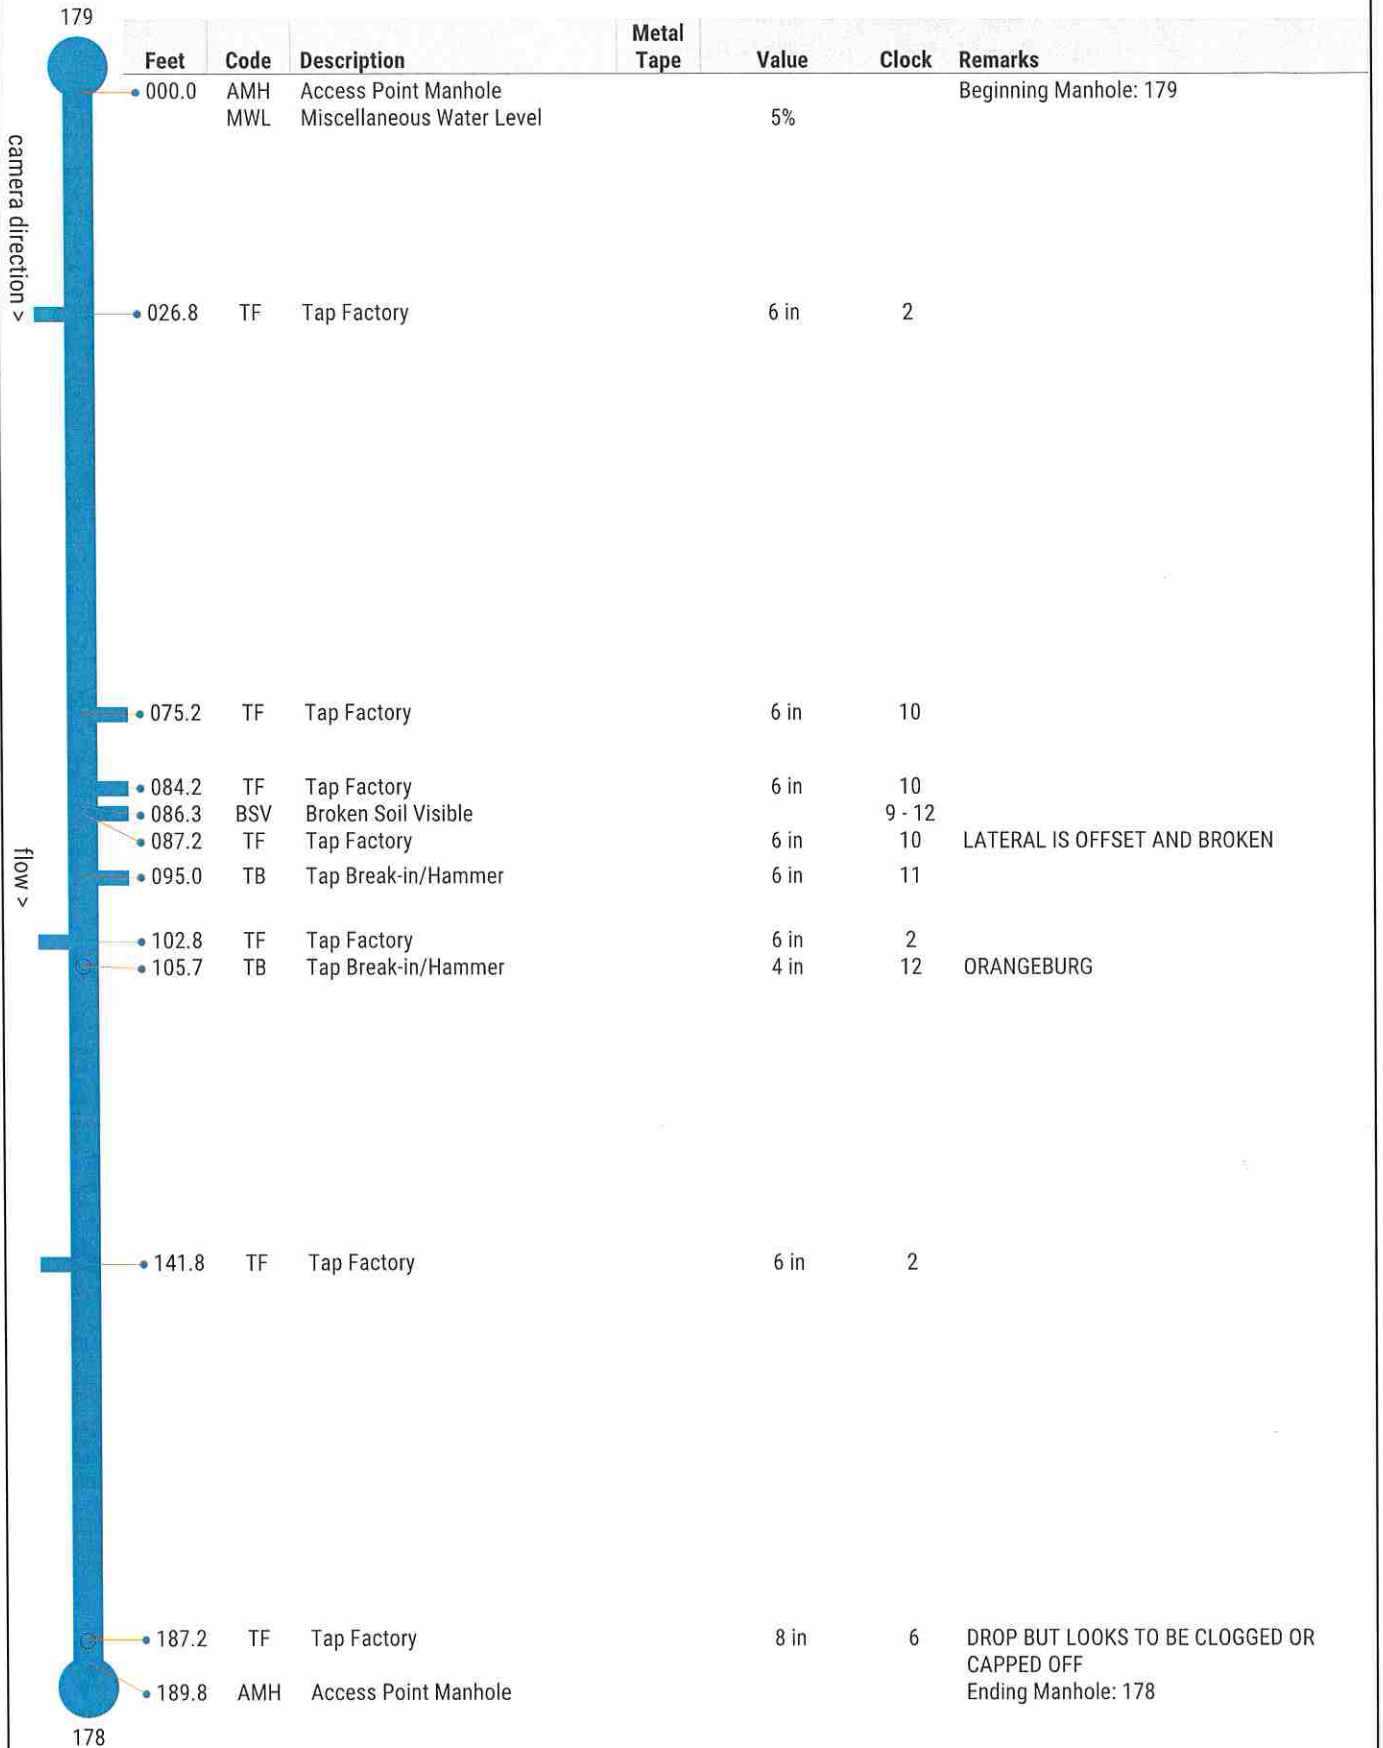

## Inspection Report

### Overview

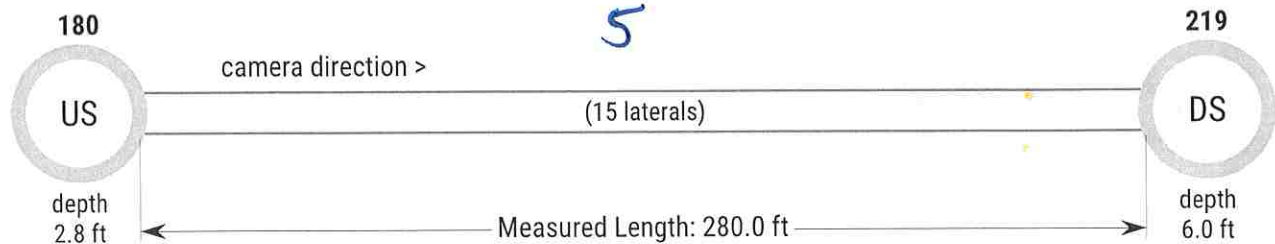

### Asset

Street: WEST ST  
City: CASSVILLE MO  
Pipe Use: Sanitary Sewage Pipe  
Pipe Geometry: 8 in (Circular)  
Material: Vitrified Clay Pipe  
Map #/Plan File: 17  
Drainage Area:  
Flow Direction: ↑ North  
Surface: Asphalt

### Inspection

Customer: ROSETTA CONSTRUCTION  
Project:  
Job #: 23010MO-11  
Media Date/Time: 2023/04/19 10:27  
Surveyed By: TYLER (P0038607-072022)  
Supervisor: DOUG B  
Pre-Cleaning: Heavy Cleaning  
Truck: 211MO  
Weather: Dry - No Precipitation During Survey  
Additional Info: RAN ROOT SAW TO CUT 5 TAPS

7895 St. Claire Ave, East St. Louis, IL 62207


## Observations

	Feet	Code	Description	Metal Tape	Value	Clock	Remarks
180	000.0	AMH	Access Point Manhole				Beginning Manhole: 180
	004.5	MWL	Miscellaneous Water Level		5%		
	004.5	TF	Tap Factory		6 in	3	ORANGEBURG?
camera direction >	046.0	TF	Tap Factory		6 in	9	
	055.1	TF	Tap Factory		6 in	2	CUT OFF
	097.3	TB	Tap Break-in/Hammer		4 in	2	CUT OFF
flow >	136.6	TF	Tap Factory		6 in	10	OFFSET INSIDE LATERAL AND REDUCES TO 4 IN
	155.4	TB	Tap Break-in/Hammer		4 in	12	ORANGEBURG? SHORT 90
	175.7	TFC	Tap Factory Capped		6 in	9	
	179.0	TBC	Tap Break-in Capped		4 in	12	PVC CAP
	183.1	TB	Tap Break-in/Hammer		4 in	12	SHORT 90
	208.8	TF	Tap Factory		6 in	2	POSSIBLY CAPPED
	224.6	TB	Tap Break-in/Hammer		4 in	12	CUT OFF CAST IRON TAP AND APPEARS TO BE ORANGEBURG
	232.1	TB	Tap Break-in/Hammer		6 in	1	CUT OFF AND CAST IRON
	247.0	JOM	Joint Offset Medium				
	248.1	TF	Tap Factory		4 in	9	OFFSET
	253.7	TB	Tap Break-in/Hammer		4 in	12	SHORT 90
	255.8	FM	Fracture Multiple			10 - 2	
	270.5	TB	Tap Break-in/Hammer		4 in	12	CUT OFF AND SHORT 90 PVC
219	276.6	AMH	Access Point Manhole				Ending Manhole: 219



## Inspection Report

### Overview

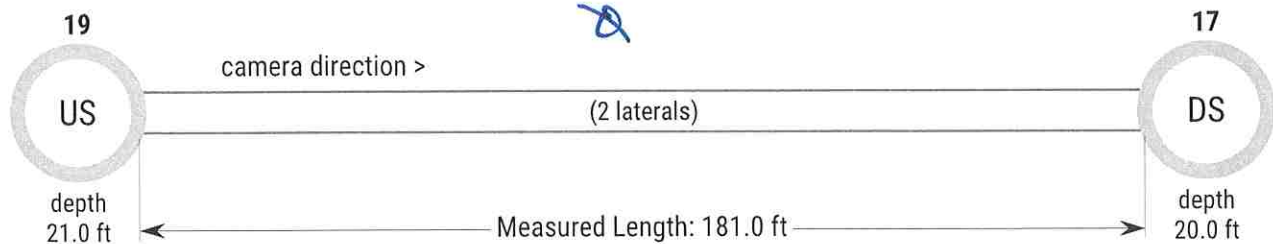

### Asset


Street: FAIR ST  
City: CASSVILLE MO  
Pipe Use: Sanitary Sewage Pipe  
Pipe Geometry: 10 in (Circular)  
Material: Vitrified Clay Pipe  
Map #/Plan File: 16  
Drainage Area:  
Flow Direction: ↗Northeast  
Surface: Asphalt

### Inspection

Customer: ROSETTA CONSTRUCTION  
Project:  
Job #: 23010MO-11  
Media Date/Time: 2023/05/22 03:25  
Surveyed By: TYLER (P0038607-072022)  
Supervisor: JAMES  
Pre-Cleaning: Light Cleaning  
Truck: 211MO  
Weather: Dry - No Precipitation During Survey  
Additional Info:


7895 St. Claire Ave, East St. Louis, IL 62207

## Observations

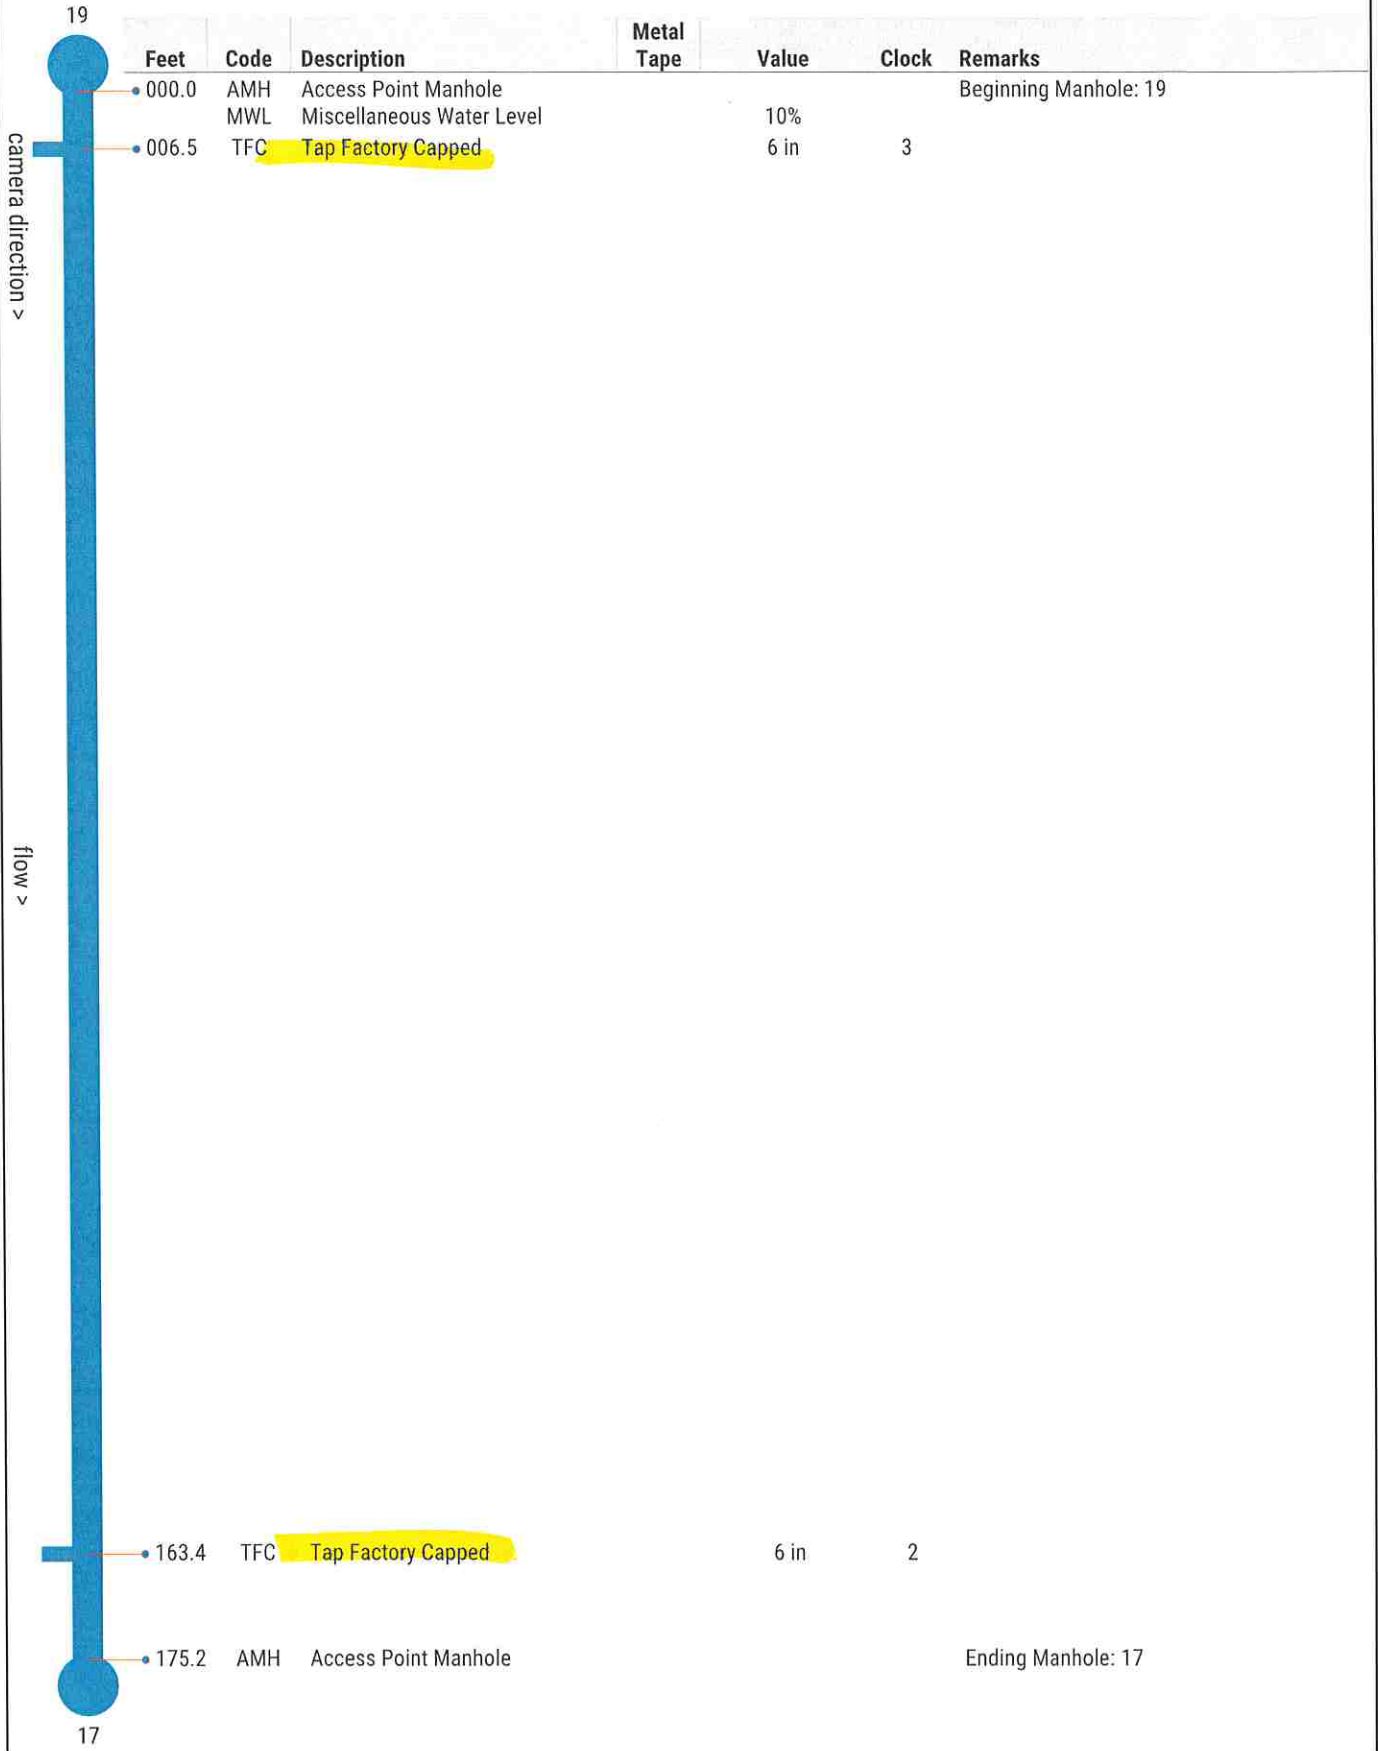

## Inspection Report

### Overview

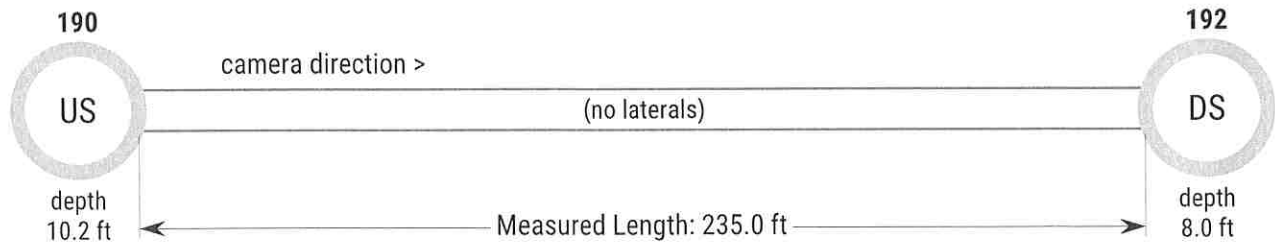

### Asset


Street: HIGHWAY 86  
City: CASSVILLE MO  
Pipe Use: Sanitary Sewage Pipe  
Pipe Geometry: 8 in (Circular)  
Material: Vitrified Clay Pipe  
Map #/Plan File: 17  
Drainage Area:  
Flow Direction: ↖ Northwest  
Surface: Grass

### Inspection

Customer: ROSETTA CONSTRUCTION  
Project:  
Job #: 23010MO-11  
Media Date/Time: 2023/05/02 03:39  
Surveyed By: TYLER (P0038607-072022)  
Supervisor: DOUG B  
Pre-Cleaning: Light Cleaning  
Truck: 211MO  
Weather: Dry - No Precipitation During Survey  
Additional Info:


7895 St. Claire Ave, East St. Louis, IL 62207

## Observations

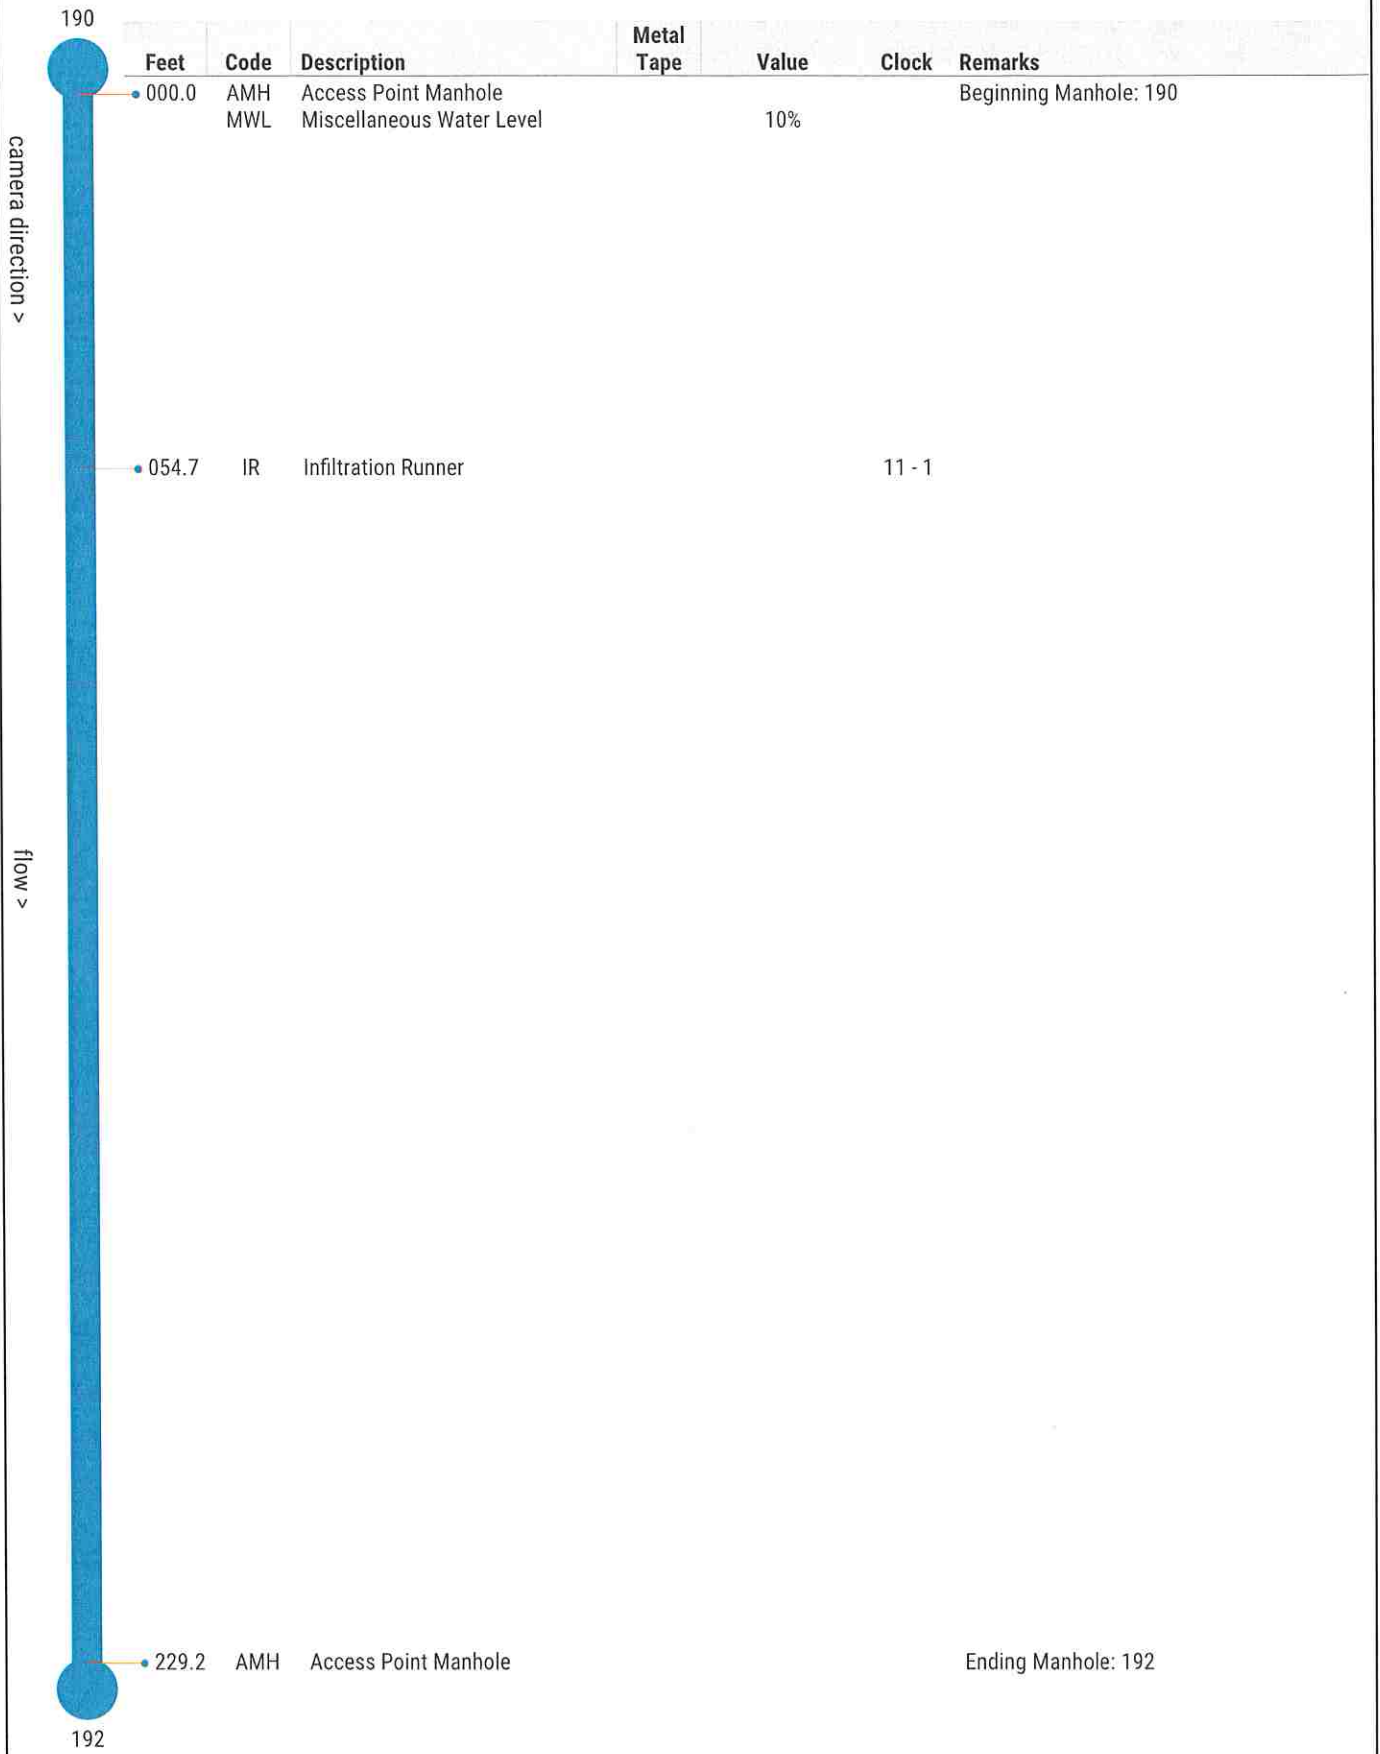

## Inspection Report

### Overview

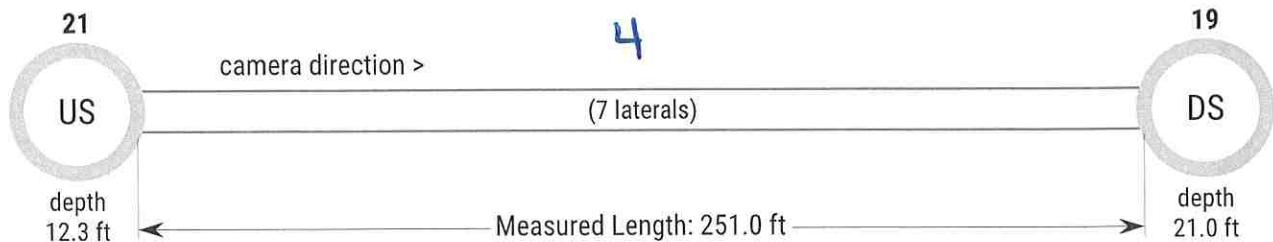

### Asset


Street: FAIR ST  
City: CASSVILLE MO  
Pipe Use: Sanitary Sewage Pipe  
Pipe Geometry: 10 in (Circular)  
Material: Vitrified Clay Pipe  
Map #/Plan File: 16  
Drainage Area:  
Flow Direction: ↗Northeast  
Surface: Asphalt

### Inspection

Customer: ROSETTA CONSTRUCTION  
Project:  
Job #: 23010MO-11  
Media Date/Time: 2023/05/22 01:37  
Surveyed By: TYLER (P0038607-072022)  
Supervisor: JAMES  
Pre-Cleaning: Light Cleaning  
Truck: 211MO  
Weather: Dry - No Precipitation During Survey  
Additional Info: DOWN STREAM MANHOLE TROUGH IS 1.5FT WIDE

7895 St. Claire Ave, East St. Louis, IL 62207


## Observations

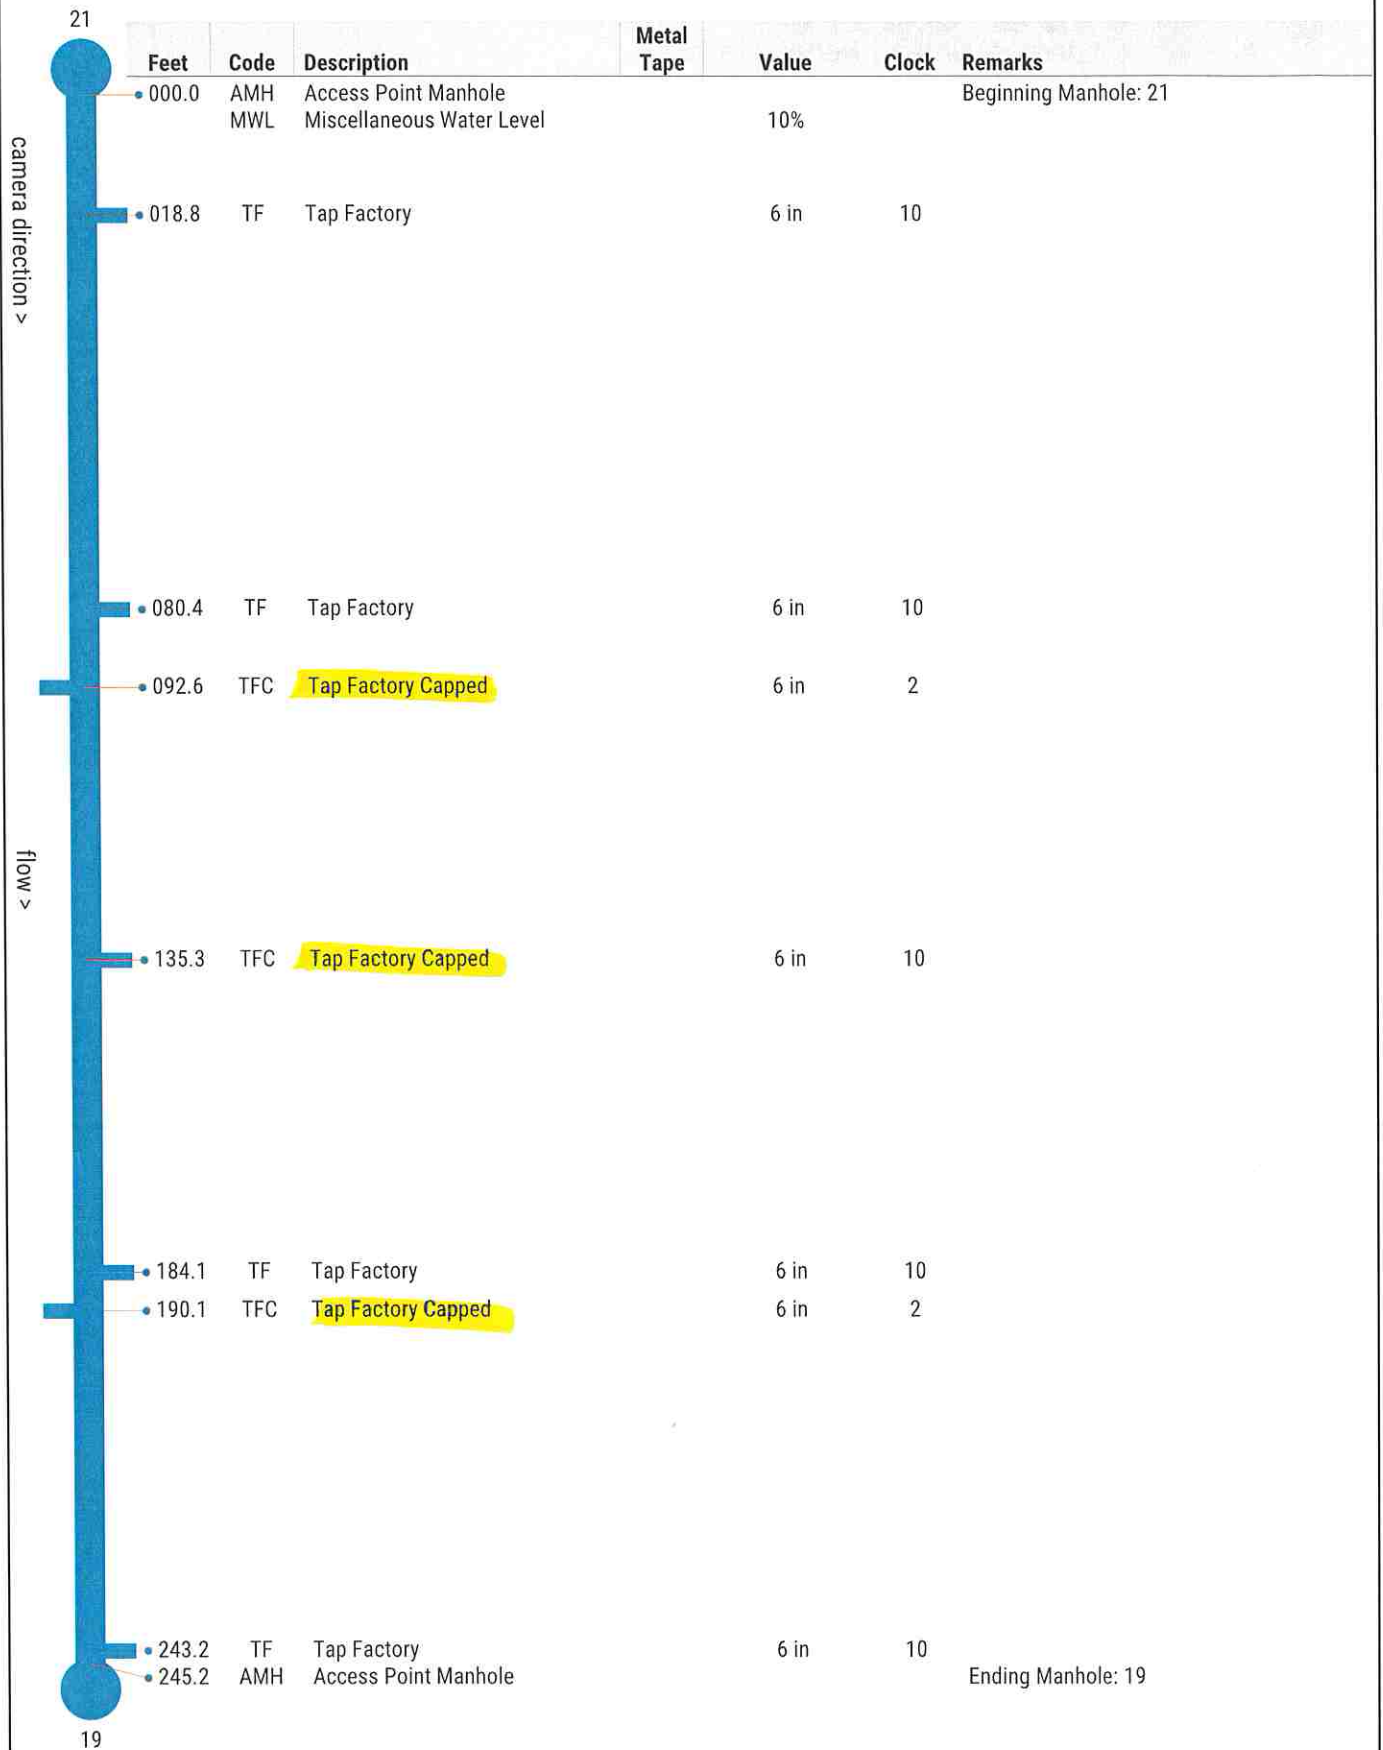



## Inspection Report

### Overview

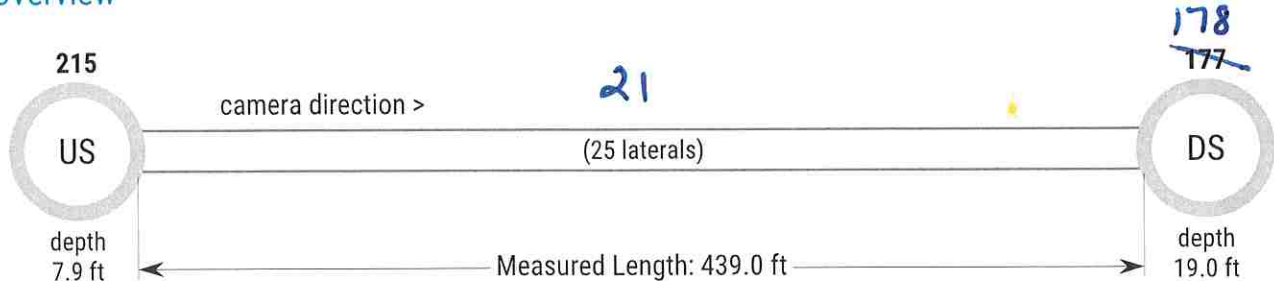

### Asset

Street: EAST ST  
City: CASSVILLE MO  
Pipe Use: Sanitary Sewage Pipe  
Pipe Geometry: 8 in (Circular)  
Material: Vitrified Clay Pipe  
Map #/Plan File: 17  
Drainage Area:  
Flow Direction: ↓ South  
Surface: Asphalt

### Inspection

Customer: ROSETTA CONSTRUCTION  
Project:  
Job #: 23010MO-11  
Media Date/Time: 2023/04/19 07:26  
Surveyed By: TYLER (P0038607-072022)  
Supervisor: DOUG B  
Pre-Cleaning: Light Cleaning  
Truck: 211MO  
Weather: Dry - No Precipitation During Survey  
Additional Info: NO MIDDLE MANHOLE LIKE MAP SAYS


7895 St. Claire Ave, East St. Louis, IL 62207

## Observations

	Feet	Code	Description	Metal Tape	Value	Clock	Remarks
215	000.0	AMH	Access Point Manhole				Beginning Manhole: 215
		MWL	Miscellaneous Water Level		5%		
	001.6	TB	Tap Break-in/Hammer		4 in	12	
	046.6	TB	Tap Break-in/Hammer		4 in	12	SEAL HANGING FROM LATERAL
	058.5	TB	Tap Break-in/Hammer		4 in	12	2 LATERALS IN 1
	060.9	TFC	Tap Factory Capped		6 in	10	
	073.1	TF	Tap Factory		6 in	2	
	091.5	TF	Tap Factory		6 in	2	
	107.2	TB	Tap Break-in/Hammer		4 in	12	SHORT 90
	131.2	TF	Tap Factory		8 in	12	SHORT 90 AND POSSIBLY A LAMPHOLE?
	135.7	TB	Tap Break-in/Hammer		4 in	12	SHORT 90
	212.2	TF	Tap Factory		8 in	12	SHORT 90 AND POSSIBLY A LAMPHOLE?
	215.1	TF	Tap Factory		8 in	12	SHORT 90 AND POSSIBLY A LAMPHOLE?
	238.4	TF	Tap Factory		6 in	3	
	253.4	TF	Tap Factory		6 in	9	
	265.7	TF	Tap Factory		6 in	2	
	284.1	TF	Tap Factory		6 in	3	SHORT 90
	299.1	TFC	Tap Factory Capped		6 in	9	
	311.4	TF	Tap Factory		6 in	3	
	323.3	TB	Tap Break-in/Hammer		4 in	12	ORANGEBURG
	332.7	TF	Tap Factory		6 in	3	
	342.0	TF	Tap Factory		6 in	9	SHORT 90
	354.2	TF	Tap Factory		6 in	2	OFFSET AND SOIL VISABLE
	363.3	TF	Tap Factory		6 in	3	SHORT 90
	388.8	TB	Tap Break-in/Hammer		4 in	11	
	412.4	TF	Tap Factory		6 in	3	SHORT 90
	430.6	TF	Tap Factory		8 in	6	DROP THAT IS CLOGGED OR CAPPED
	433.3	AMH	Access Point Manhole				Ending Manhole: 177
177							

## Inspection Report

### Overview

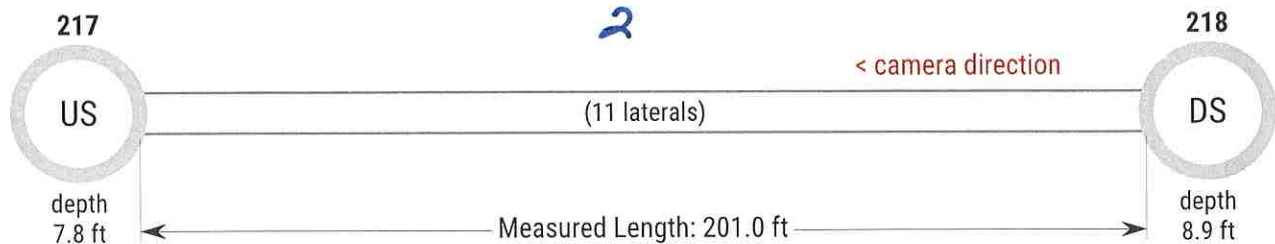

### Asset


Street: WEST ST  
City: CASSVILLE MO  
Pipe Use: Sanitary Sewage Pipe  
Pipe Geometry: 8 in (Circular)  
Material: Vitrified Clay Pipe  
Map #/Plan File: 17  
Drainage Area:  
Flow Direction: ↓ South  
Surface: Asphalt

### Inspection

Customer: ROSETTA CONSTRUCTION  
Project:  
Job #: 23010MO-11  
Media Date/Time: 2023/04/19 11:28  
Surveyed By: TYLER (P0038607-072022)  
Supervisor: DOUG B  
Pre-Cleaning: Light Cleaning  
Truck: 211MO  
Weather: Dry - No Precipitation During Survey  
Additional Info:


7895 St. Claire Ave, East St. Louis, IL 62207

## Observations

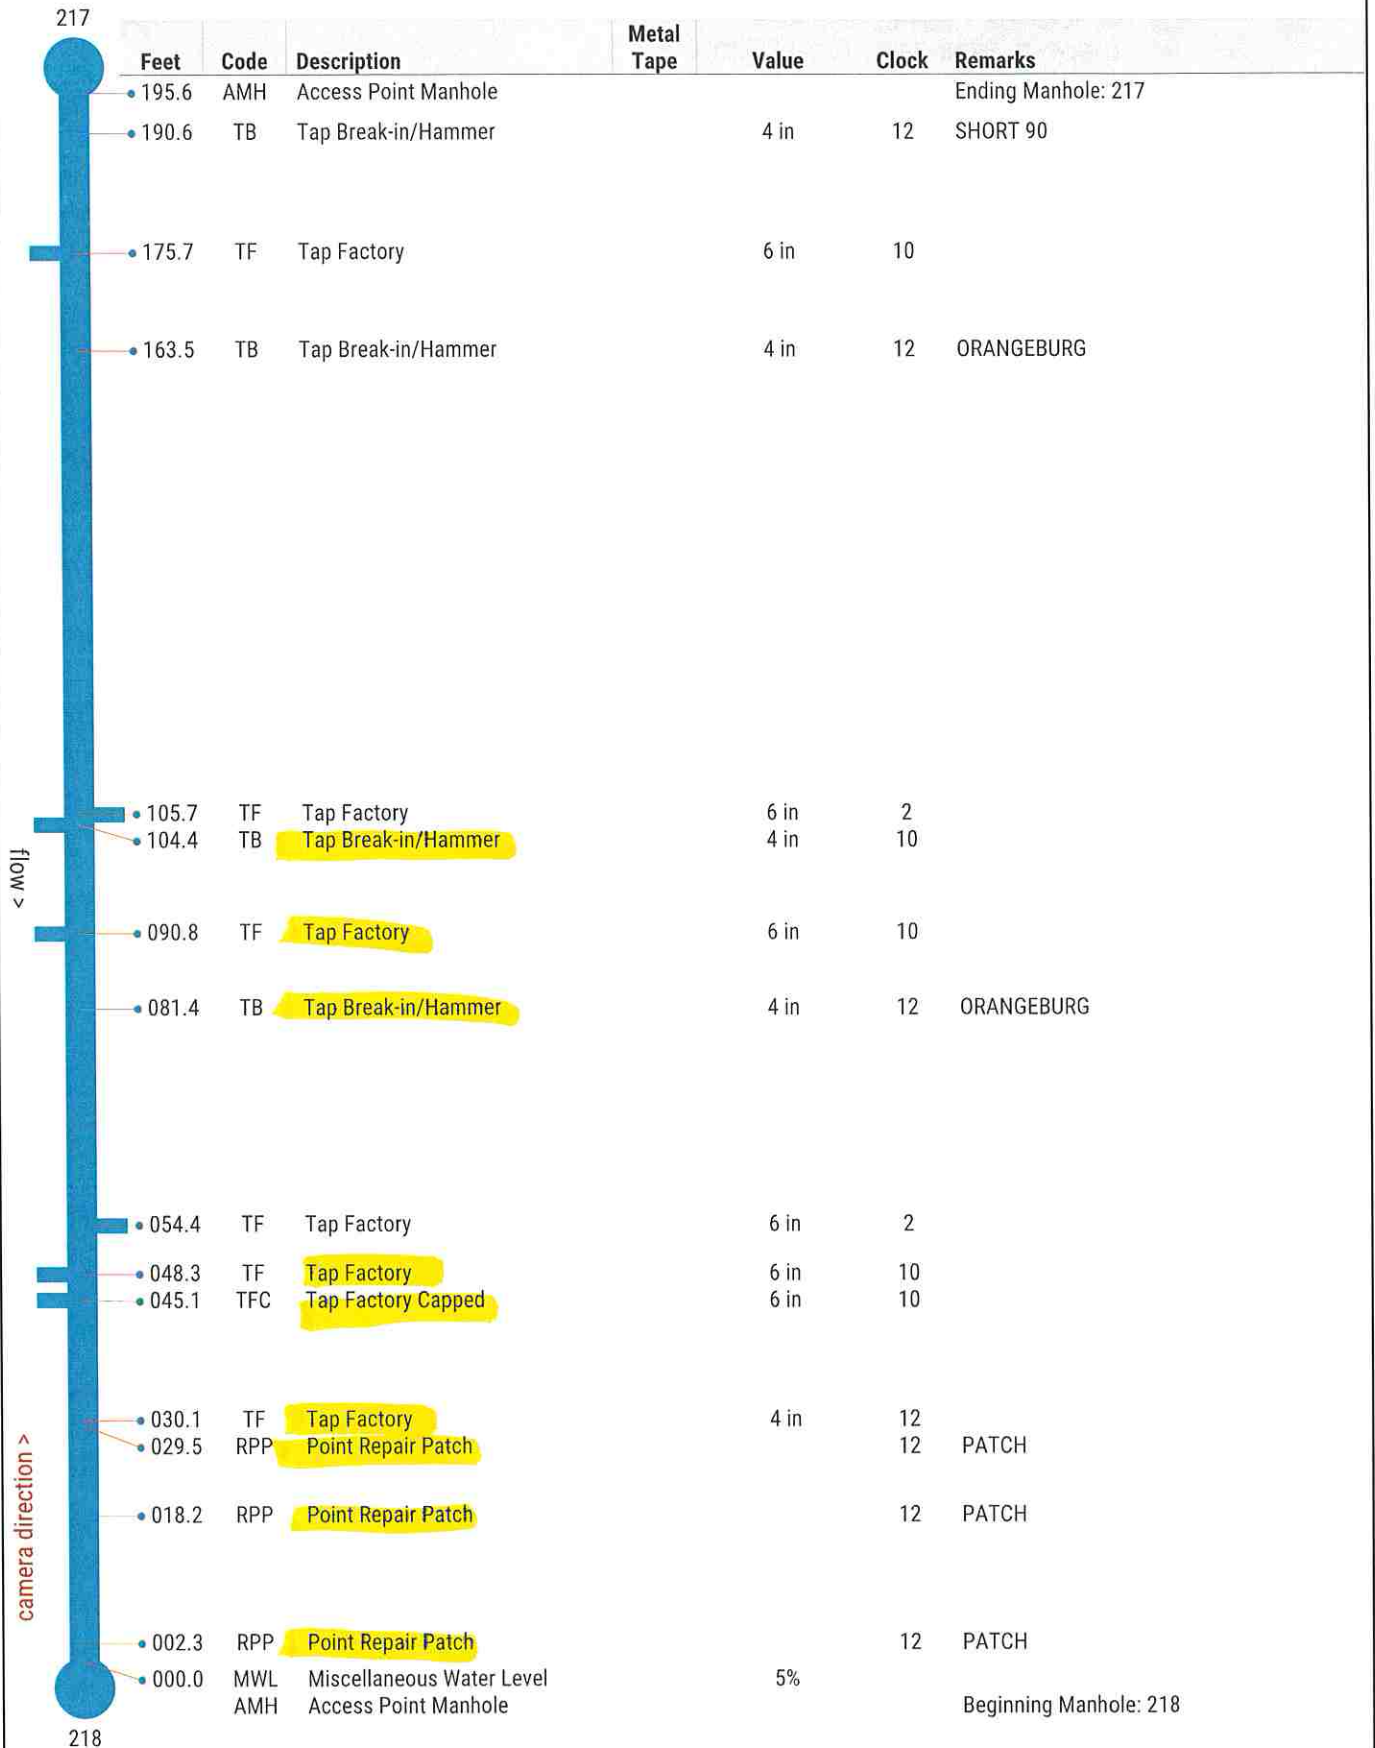

## Inspection Report

### Overview

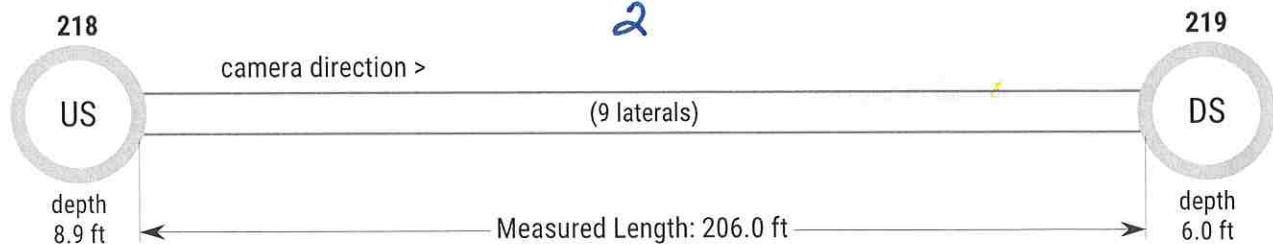

### Asset


Street: WEST ST  
City: CASSVILLE MO  
Pipe Use: Sanitary Sewage Pipe  
Pipe Geometry: 8 in (Circular)  
Material: Vitrified Clay Pipe  
Map #/Plan File: 17  
Drainage Area:  
Flow Direction: ↓ South  
Surface: Asphalt

### Inspection

Customer: ROSETTA CONSTRUCTION  
Project:  
Job #: 23010MO-11  
Media Date/Time: 2023/04/19 12:04  
Surveyed By: TYLER (P0038607-072022)  
Supervisor: DOUG B  
Pre-Cleaning: Heavy Cleaning  
Truck: 211MO  
Weather: Dry - No Precipitation During Survey  
Additional Info: RAN ROOT SAW TO CUT TAP, BLADE BROKE OFF AND WE RETRIEVED IT

7895 St. Claire Ave, East St. Louis, IL 62207


## Observations

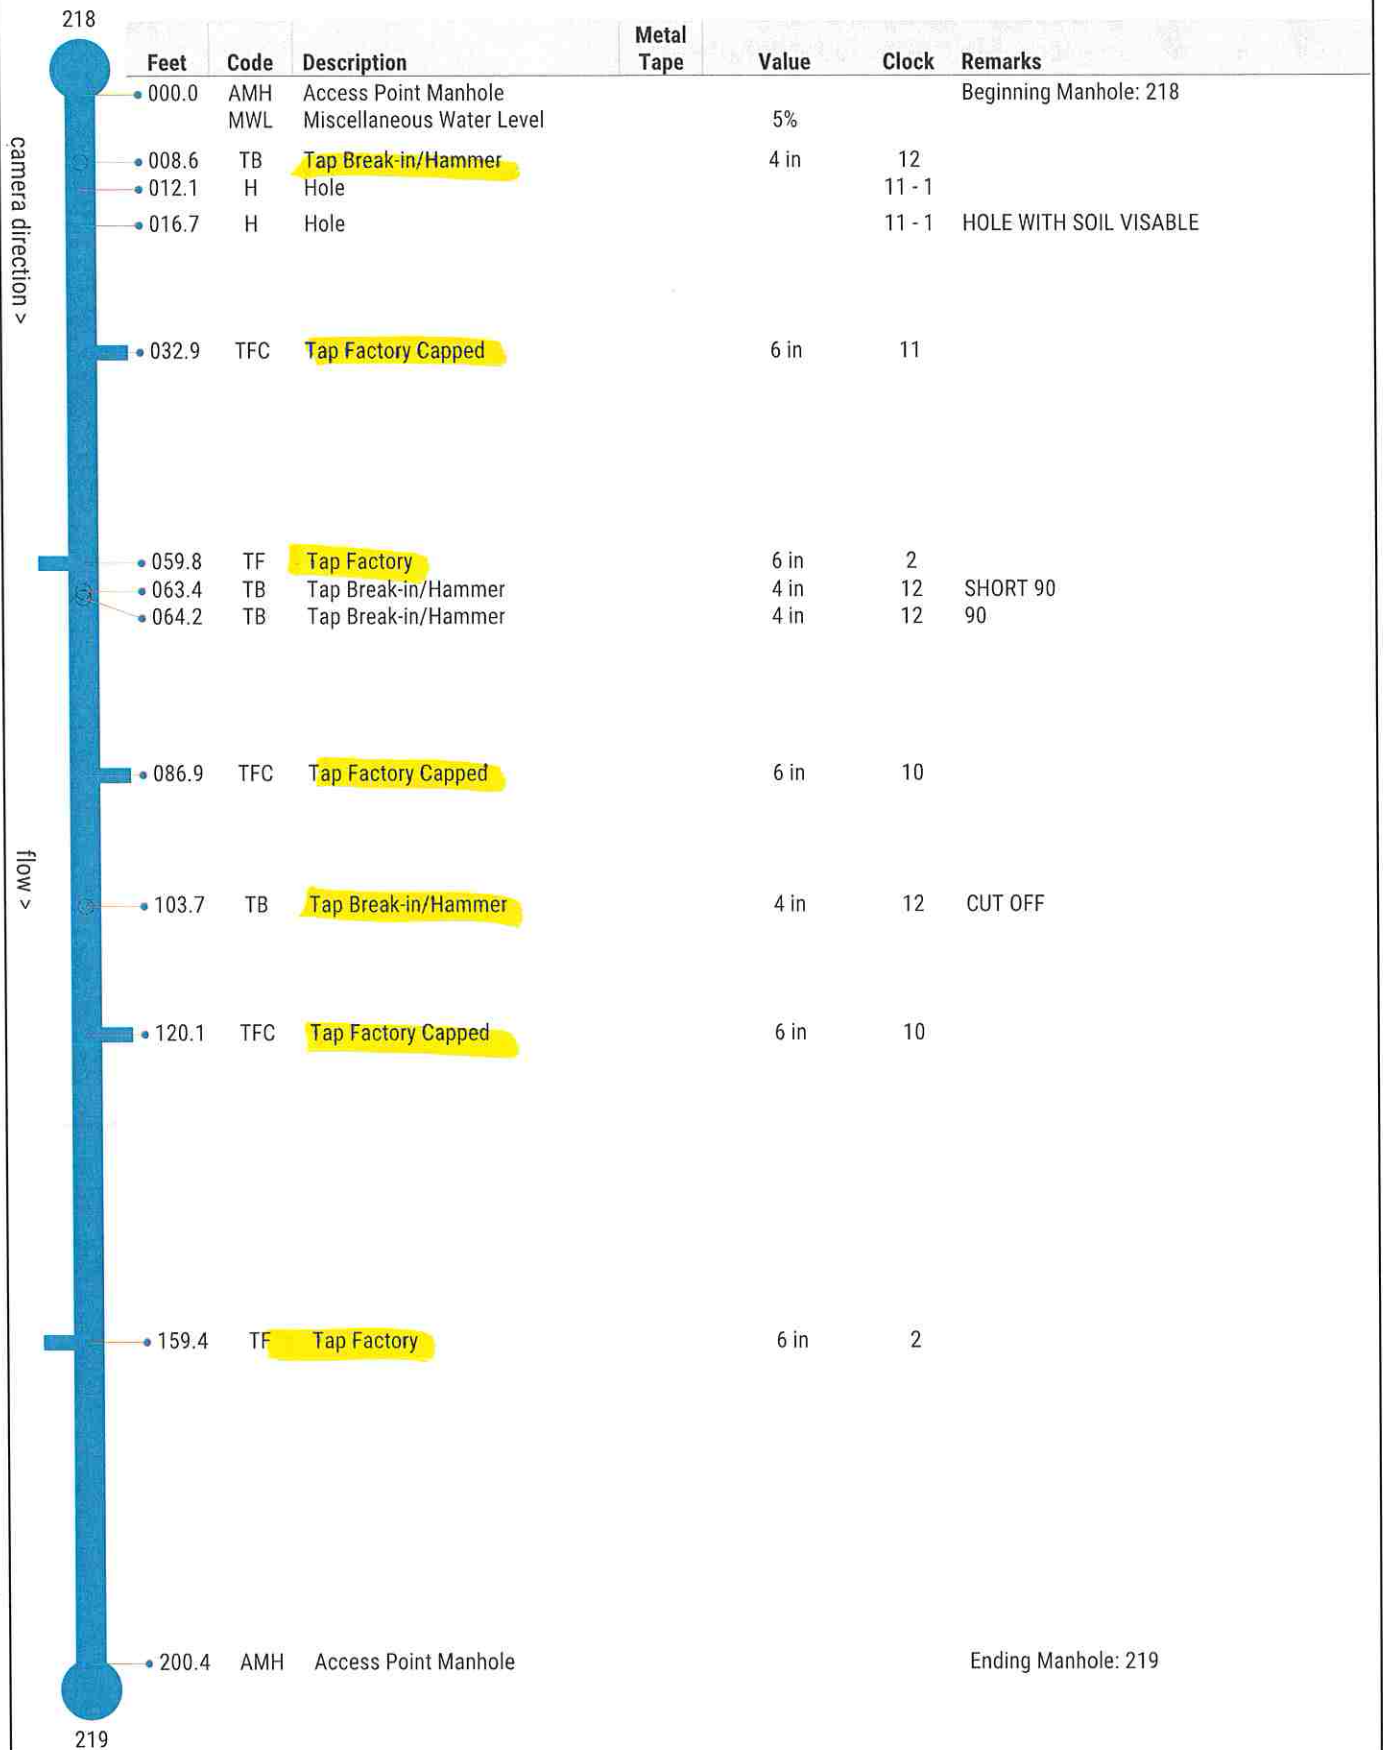



## Inspection Report

### Overview

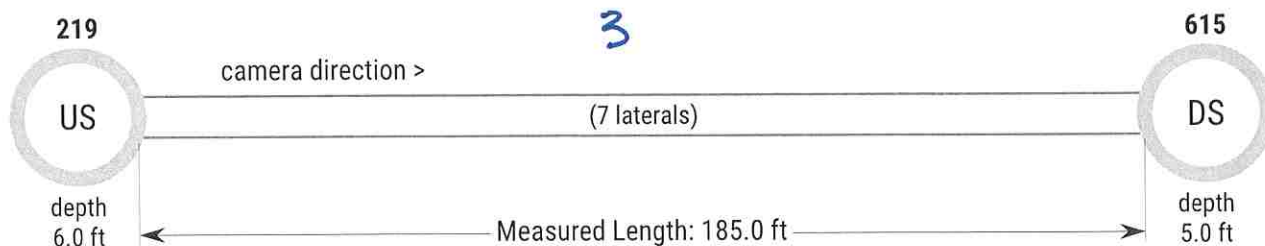

### Asset


Street: 4TH ST  
City: CASSVILLE MO  
Pipe Use: Sanitary Sewage Pipe  
Pipe Geometry: 8 in (Circular)  
Material: Vitrified Clay Pipe  
Map #/Plan File: 17  
Drainage Area:  
Flow Direction: →East  
Surface: Asphalt

### Inspection

Customer: ROSETTA CONSTRUCTION  
Project:  
Job #: 23010MO-11  
Media Date/Time: 2023/04/19 02:39  
Surveyed By: TYLER (P0038607-072022)  
Supervisor: DOUG B  
Pre-Cleaning: Light Cleaning  
Truck: 211MO  
Weather: Dry - No Precipitation During Survey  
Additional Info:


7895 St. Claire Ave, East St. Louis, IL 62207

## Observations

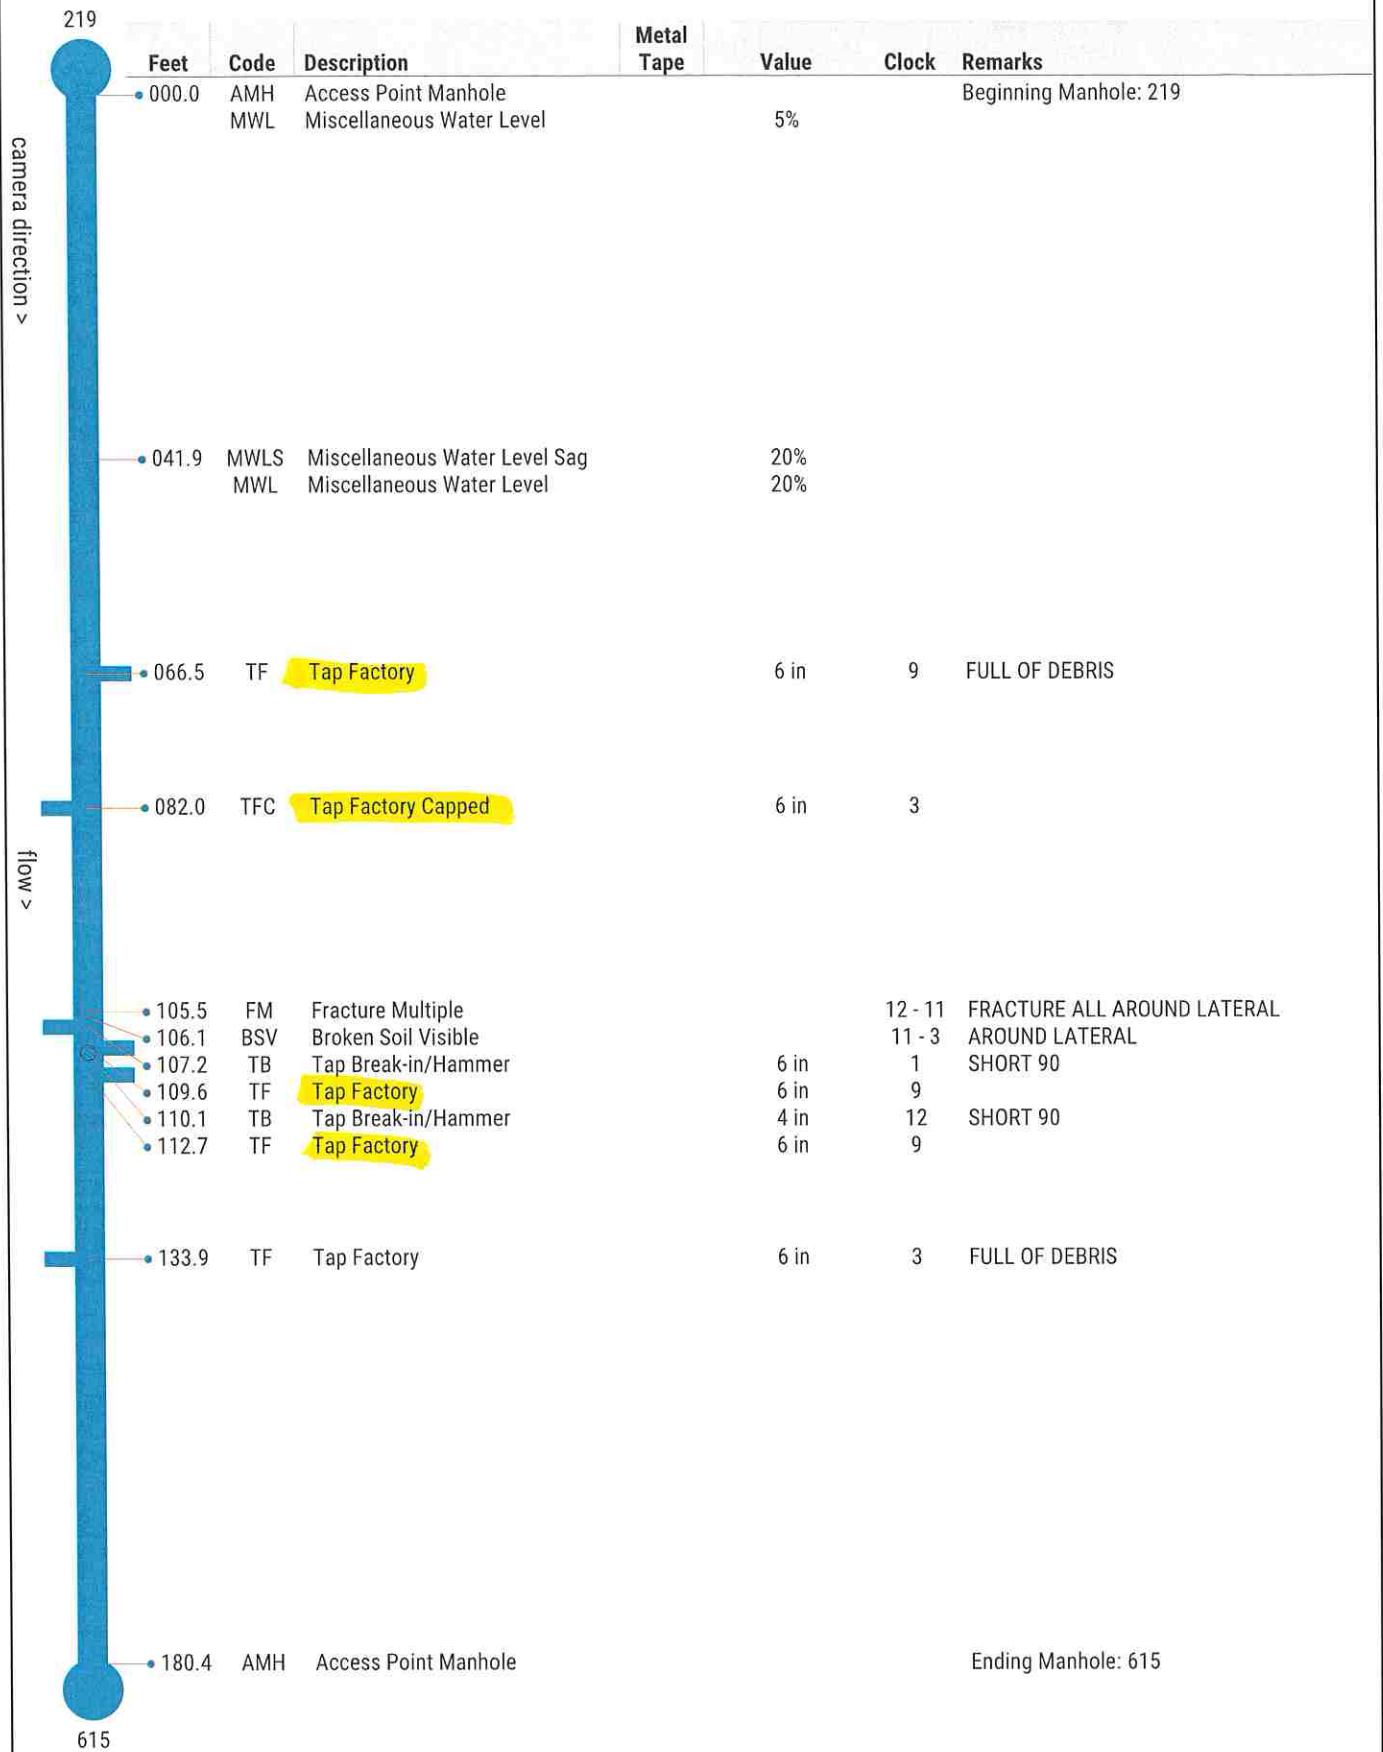

## Inspection Report

### Overview

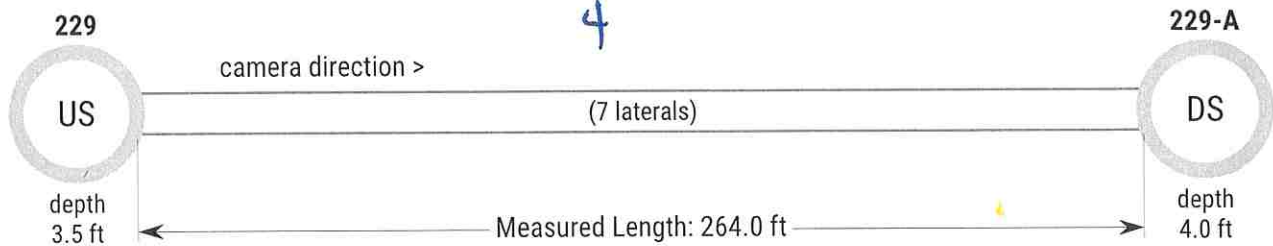

### Asset


Street: HIGHWAY 86  
City: CASSVILLE MO  
Pipe Use: Sanitary Sewage Pipe  
Pipe Geometry: 8 in (Circular)  
Material: Vitrified Clay Pipe  
Map #/Plan File: 17  
Drainage Area:  
Flow Direction: ↑ North  
Surface: Gravel

### Inspection

Customer: ROSETTA CONSTRUCTION  
Project:  
Job #: 23010MO-11  
Media Date/Time: 2023/05/02 11:04  
Surveyed By: TYLER (P0038607-072022)  
Supervisor: DOUG B  
Pre-Cleaning: Light Cleaning  
Truck: 211MO  
Weather: Dry - No Precipitation During Survey  
Additional Info:


7895 St. Claire Ave, East St. Louis, IL 62207

## Observations

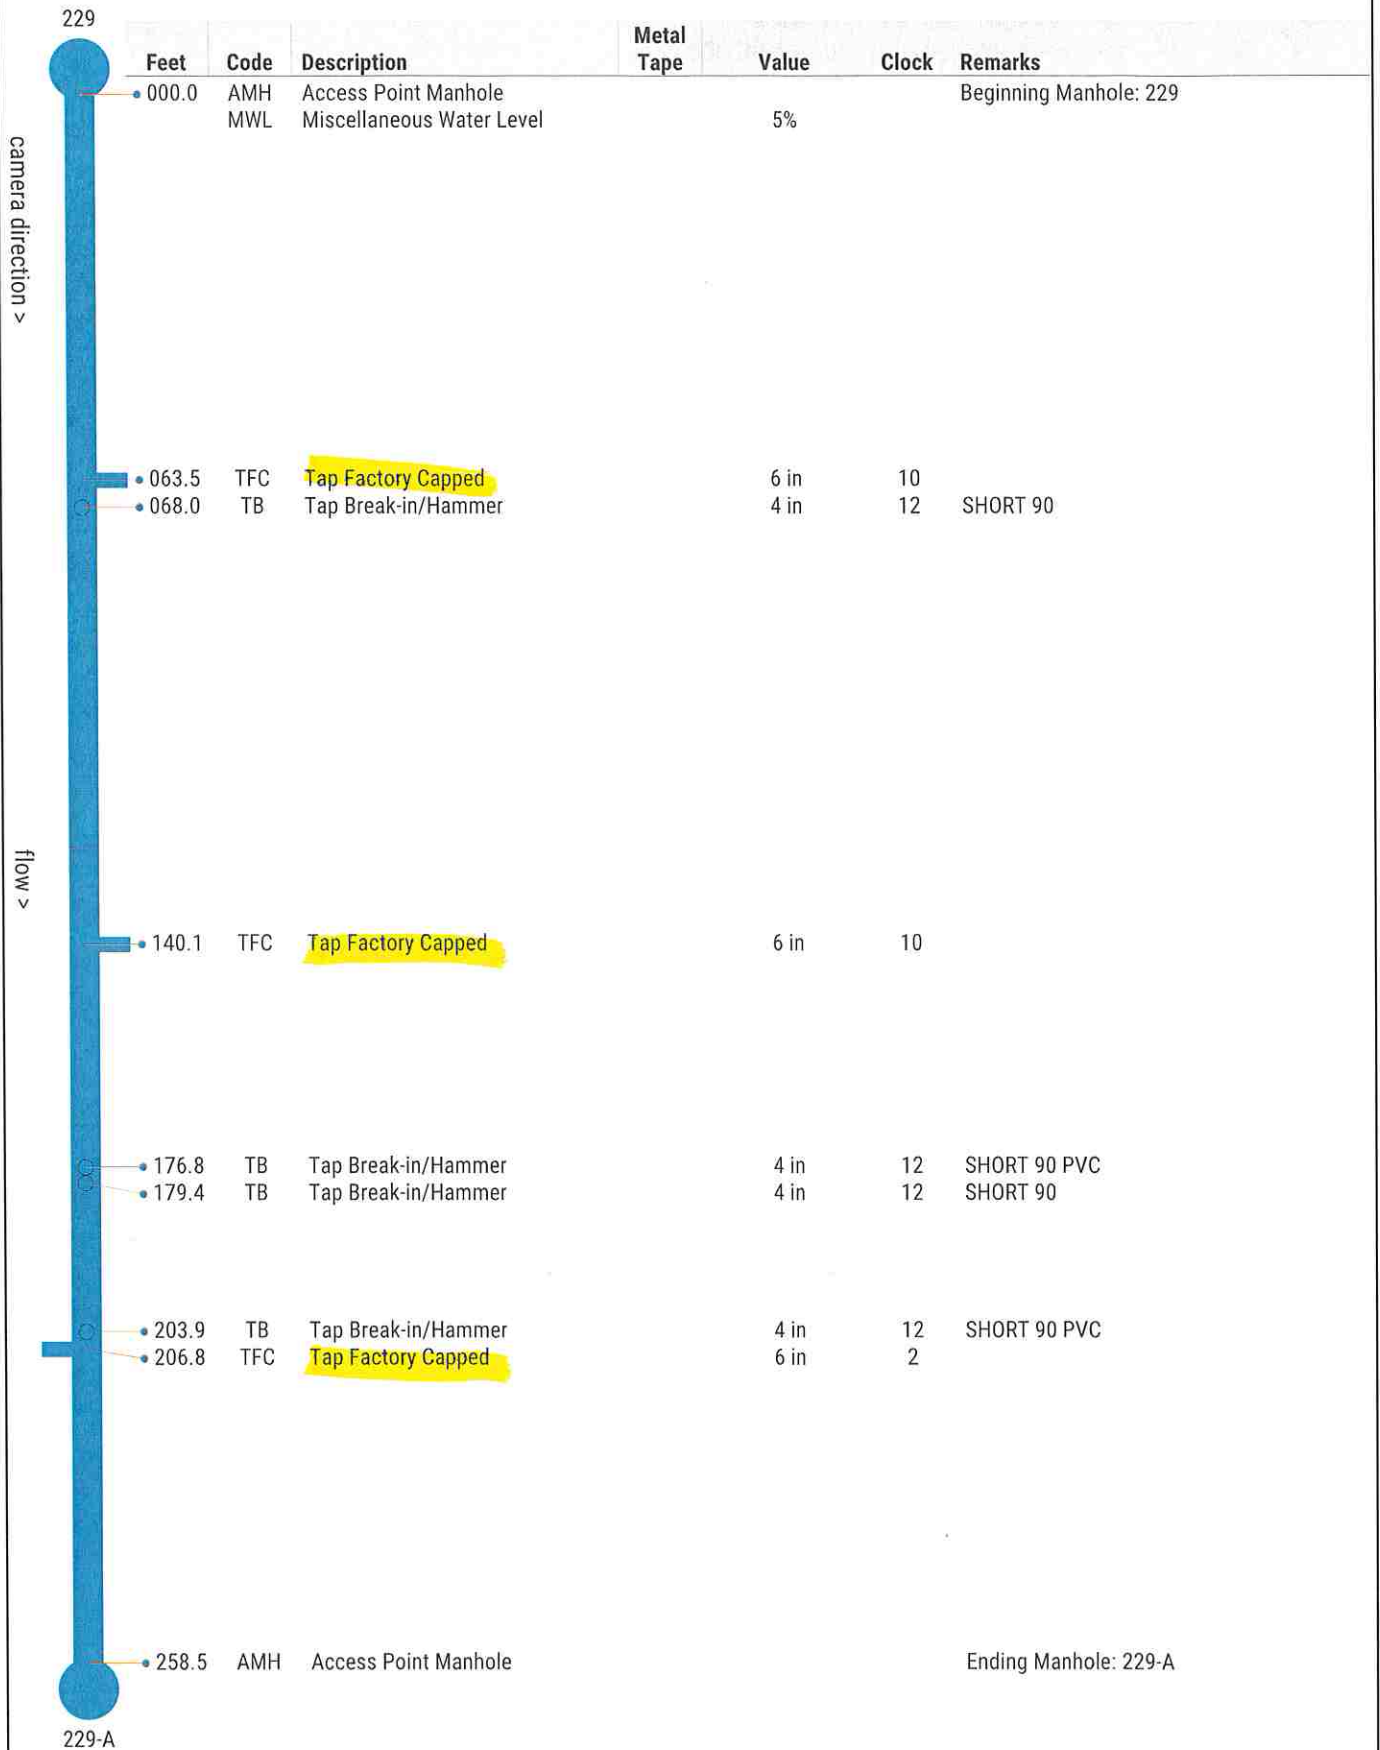

## Inspection Report

### Overview

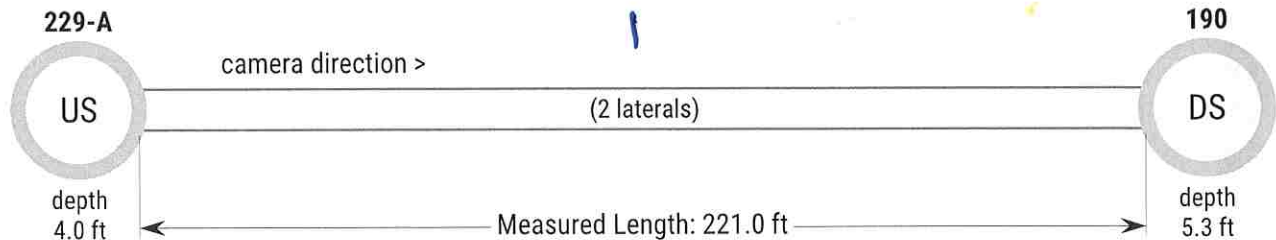

### Asset


Street: HIGHWAY 86  
City: CASSVILLE MO  
Pipe Use: Sanitary Sewage Pipe  
Pipe Geometry: 8 in (Circular)  
Material: Vitrified Clay Pipe  
Map #/Plan File: 17  
Drainage Area:  
Flow Direction: ↑ North  
Surface: Gravel

### Inspection

Customer: ROSETTA CONSTRUCTION  
Project:  
Job #: 23010MO-11  
Media Date/Time: 2023/05/02 11:21  
Surveyed By: TYLER (P0038607-072022)  
Supervisor: DOUG B  
Pre-Cleaning: Heavy Cleaning  
Truck: 211MO  
Weather: Dry - No Precipitation During Survey  
Additional Info: RAN ROOT SAW

7895 St. Claire Ave, East St. Louis, IL 62207


## Observations

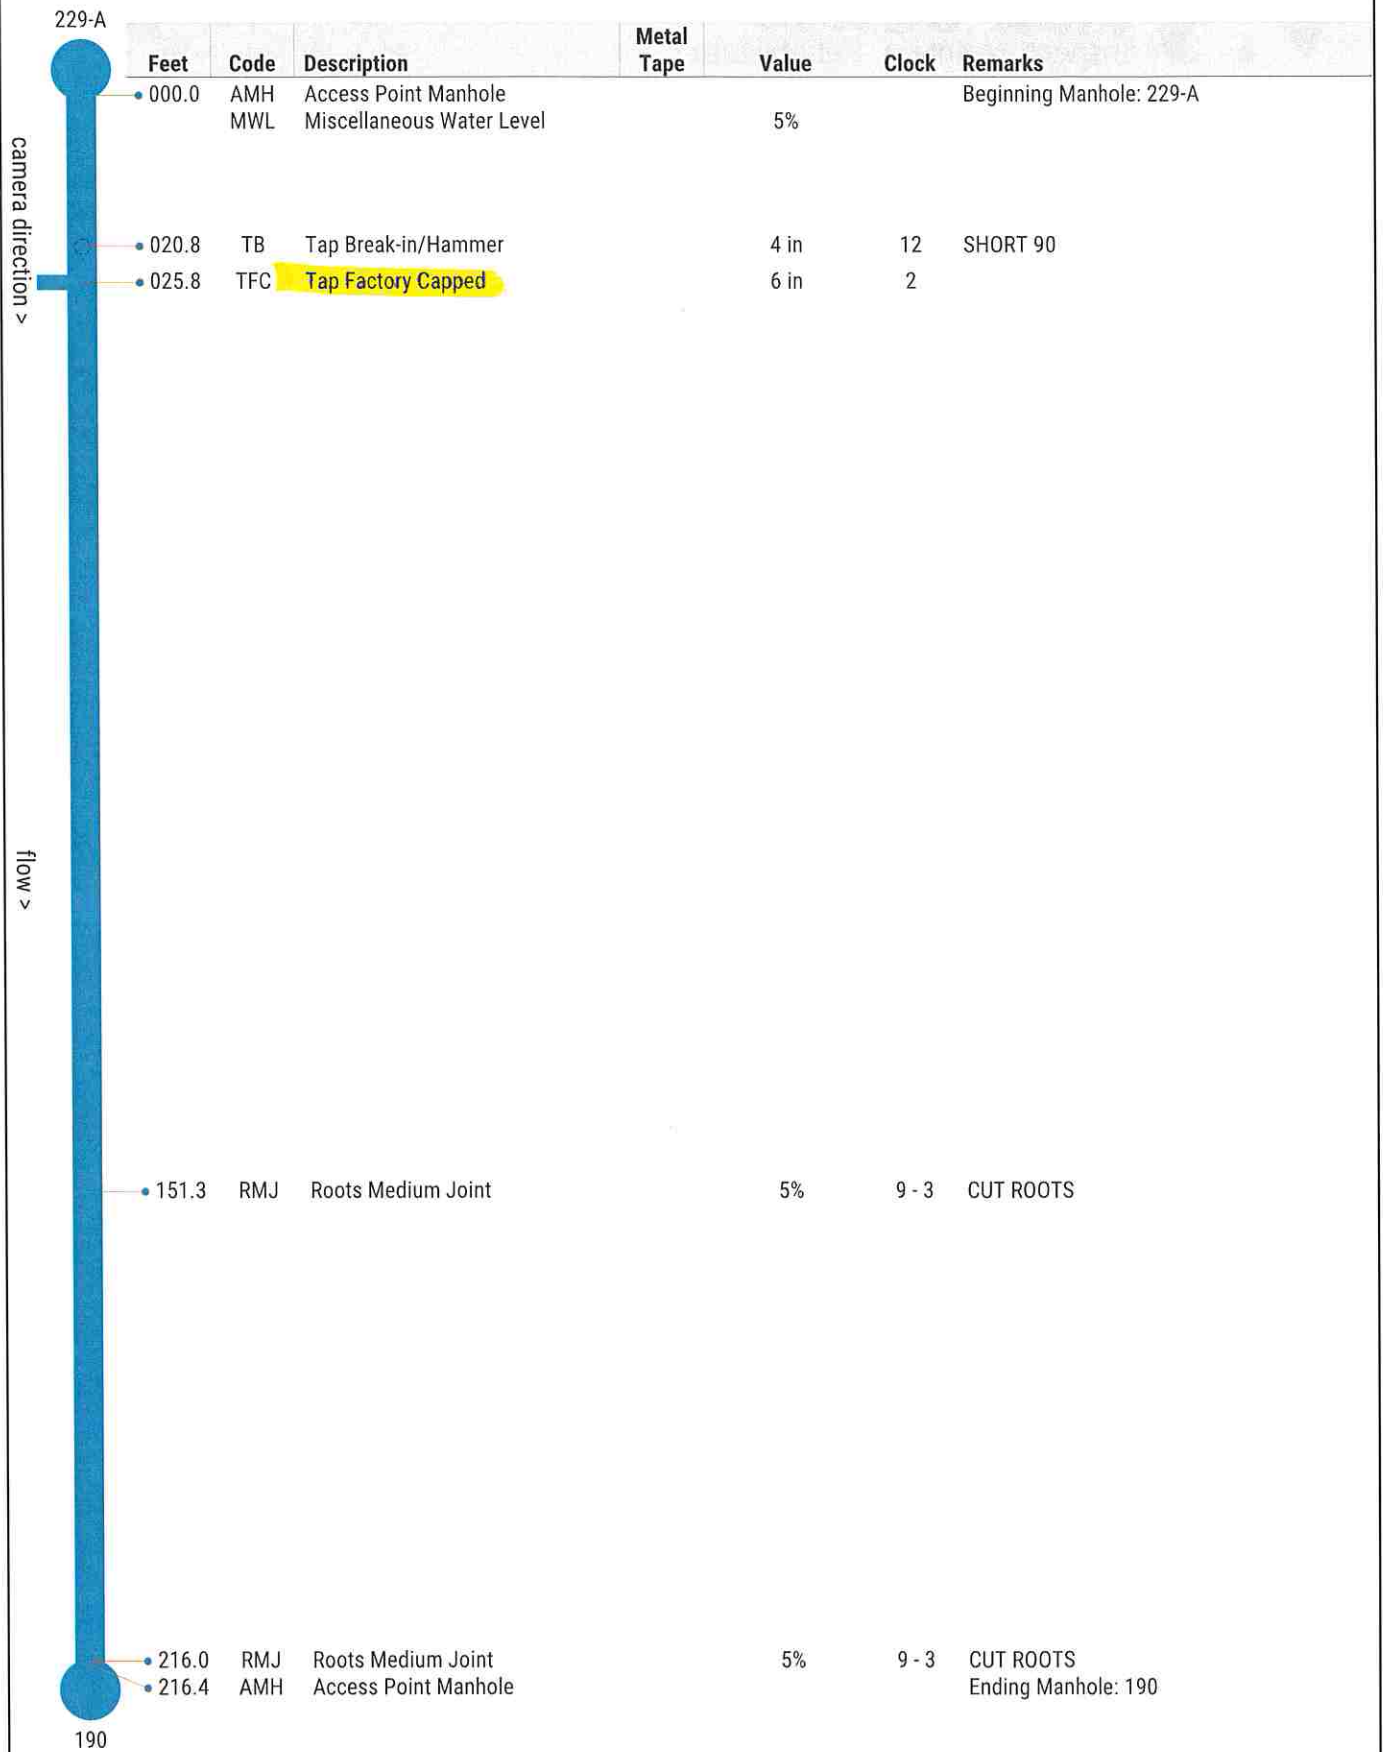



## Inspection Report

### Overview

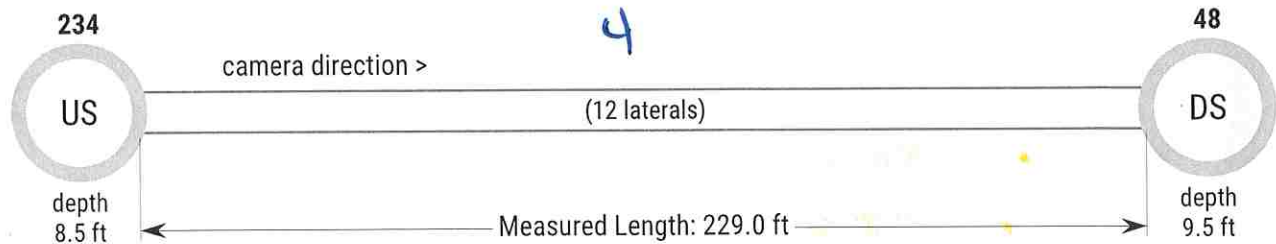

### Asset


Street: TOWNSEND ST  
City: CASSVILLE MO  
Pipe Use: Sanitary Sewage Pipe  
Pipe Geometry: 8 in (Circular)  
Material: Vitrified Clay Pipe  
Map #/Plan File: 15  
Drainage Area:  
Flow Direction: ✓ Southwest  
Surface: Asphalt

### Inspection

Customer: ROSETTA CONSTRUCTION  
Project:  
Job #: 23010MO-11  
Media Date/Time: 2023/04/20 05:27  
Surveyed By: TYLER (P0038607-072022)  
Supervisor: DOUG B  
Pre-Cleaning: Light Cleaning  
Truck: 211MO  
Weather: Dry - No Precipitation During Survey  
Additional Info: VERY GREESEY LINE


7895 St. Claire Ave, East St. Louis, IL 62207

## Observations

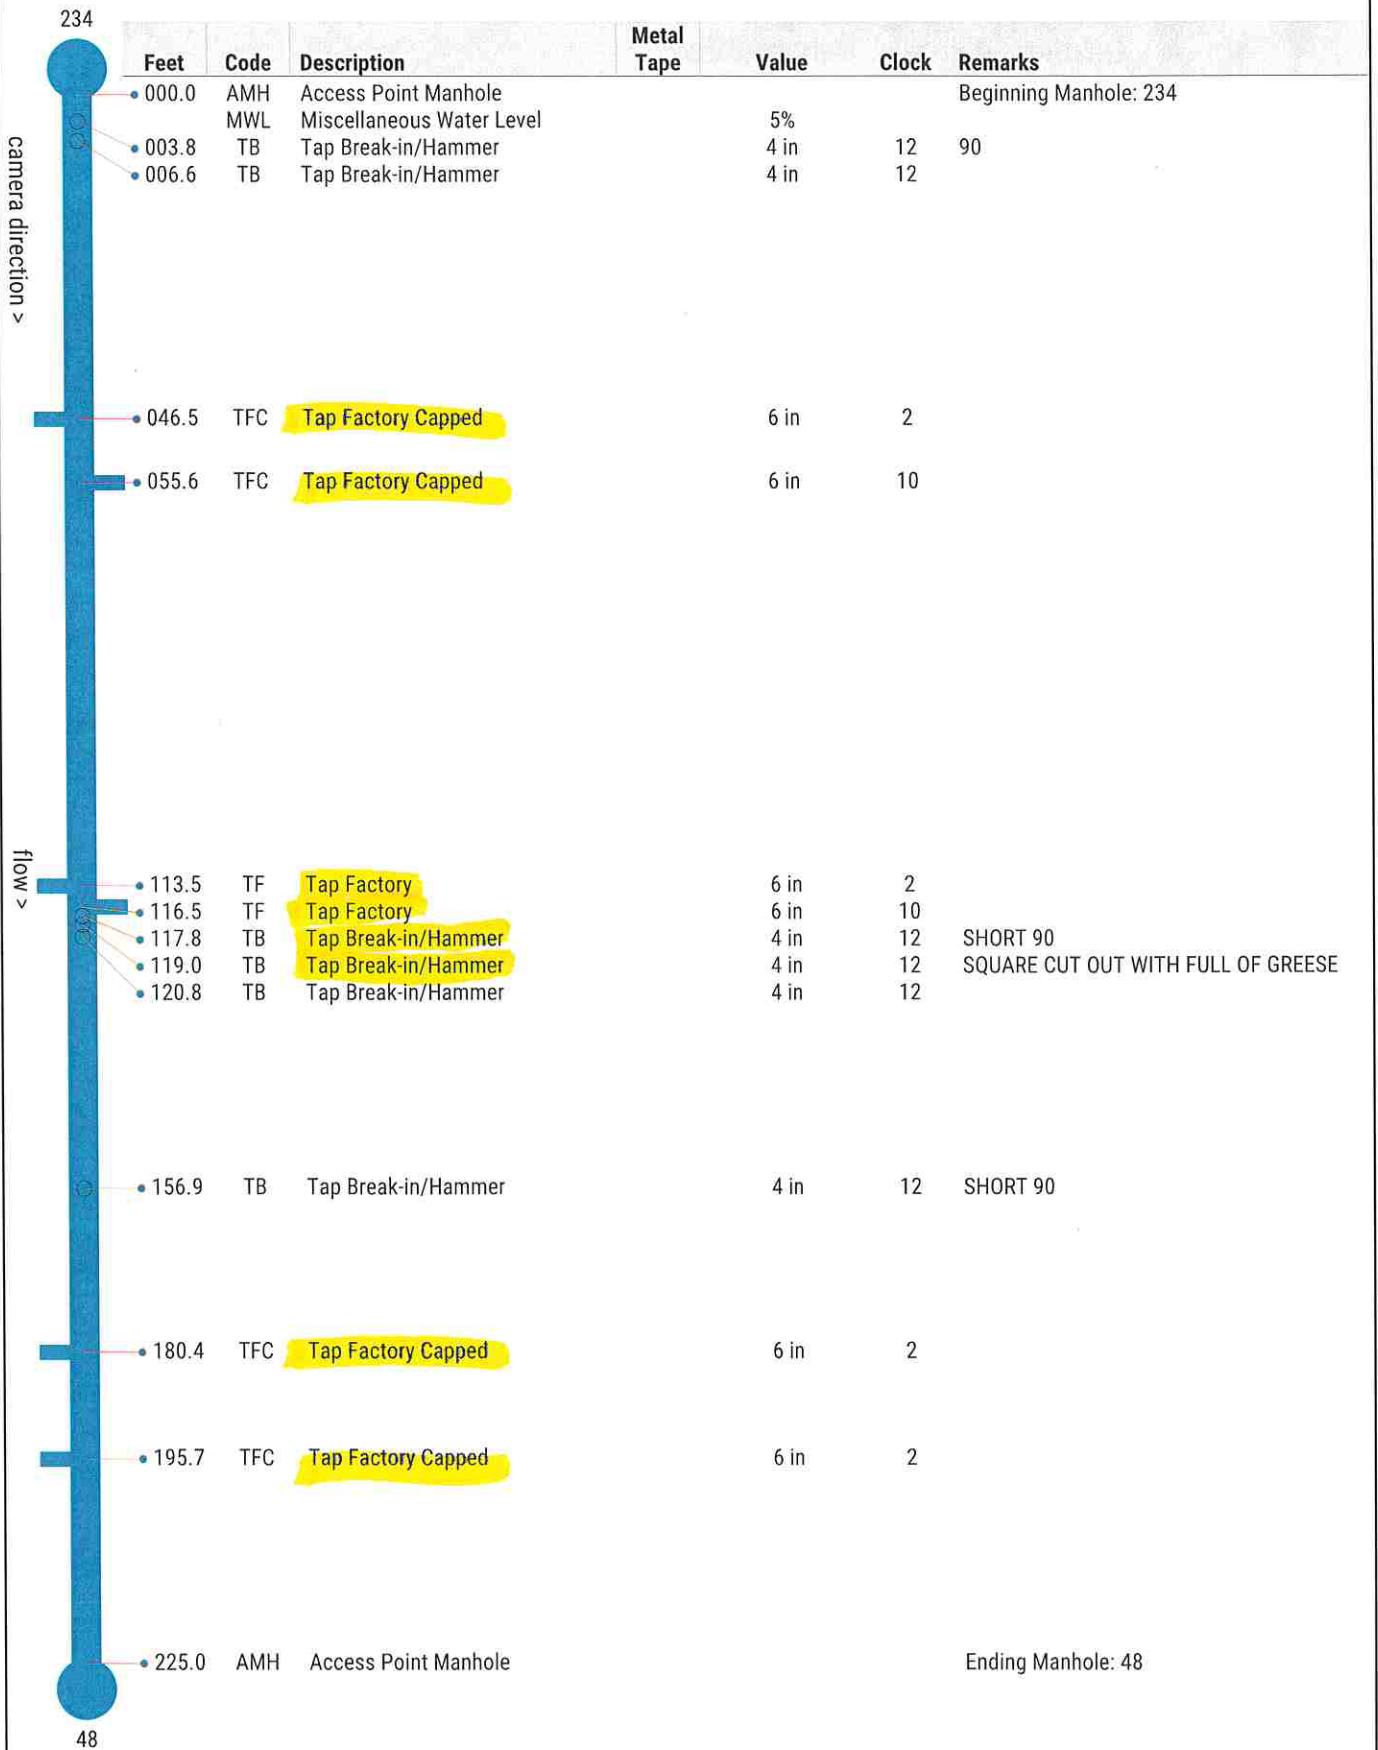

## Inspection Report

### Overview

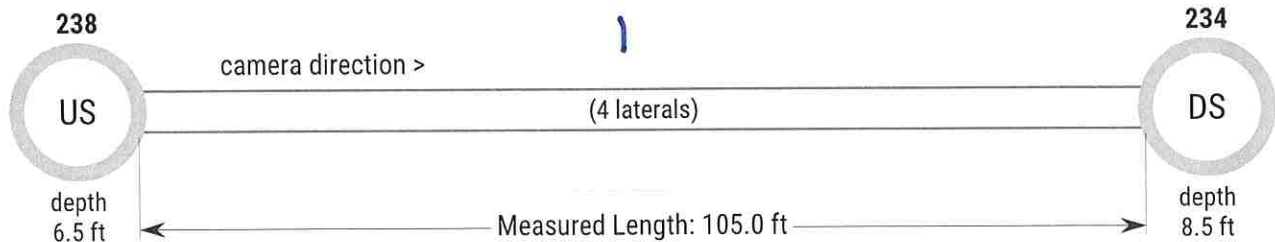

### Asset


Street: TOWNSEND ST  
City: CASSVILLE MO  
Pipe Use: Sanitary Sewage Pipe  
Pipe Geometry: 8 in (Circular)  
Material: Vitrified Clay Pipe  
Map #/Plan File: 15  
Drainage Area:  
Flow Direction: ✓ Southwest  
Surface: Asphalt

### Inspection

Customer: ROSETTA CONSTRUCTION  
Project:  
Job #: 23010MO-11  
Media Date/Time: 2023/04/20 05:15  
Surveyed By: TYLER (P0038607-072022)  
Supervisor: DOUG B  
Pre-Cleaning: Light Cleaning  
Truck: 211MO  
Weather: Dry - No Precipitation During Survey  
Additional Info:


7895 St. Claire Ave, East St. Louis, IL 62207

## Observations

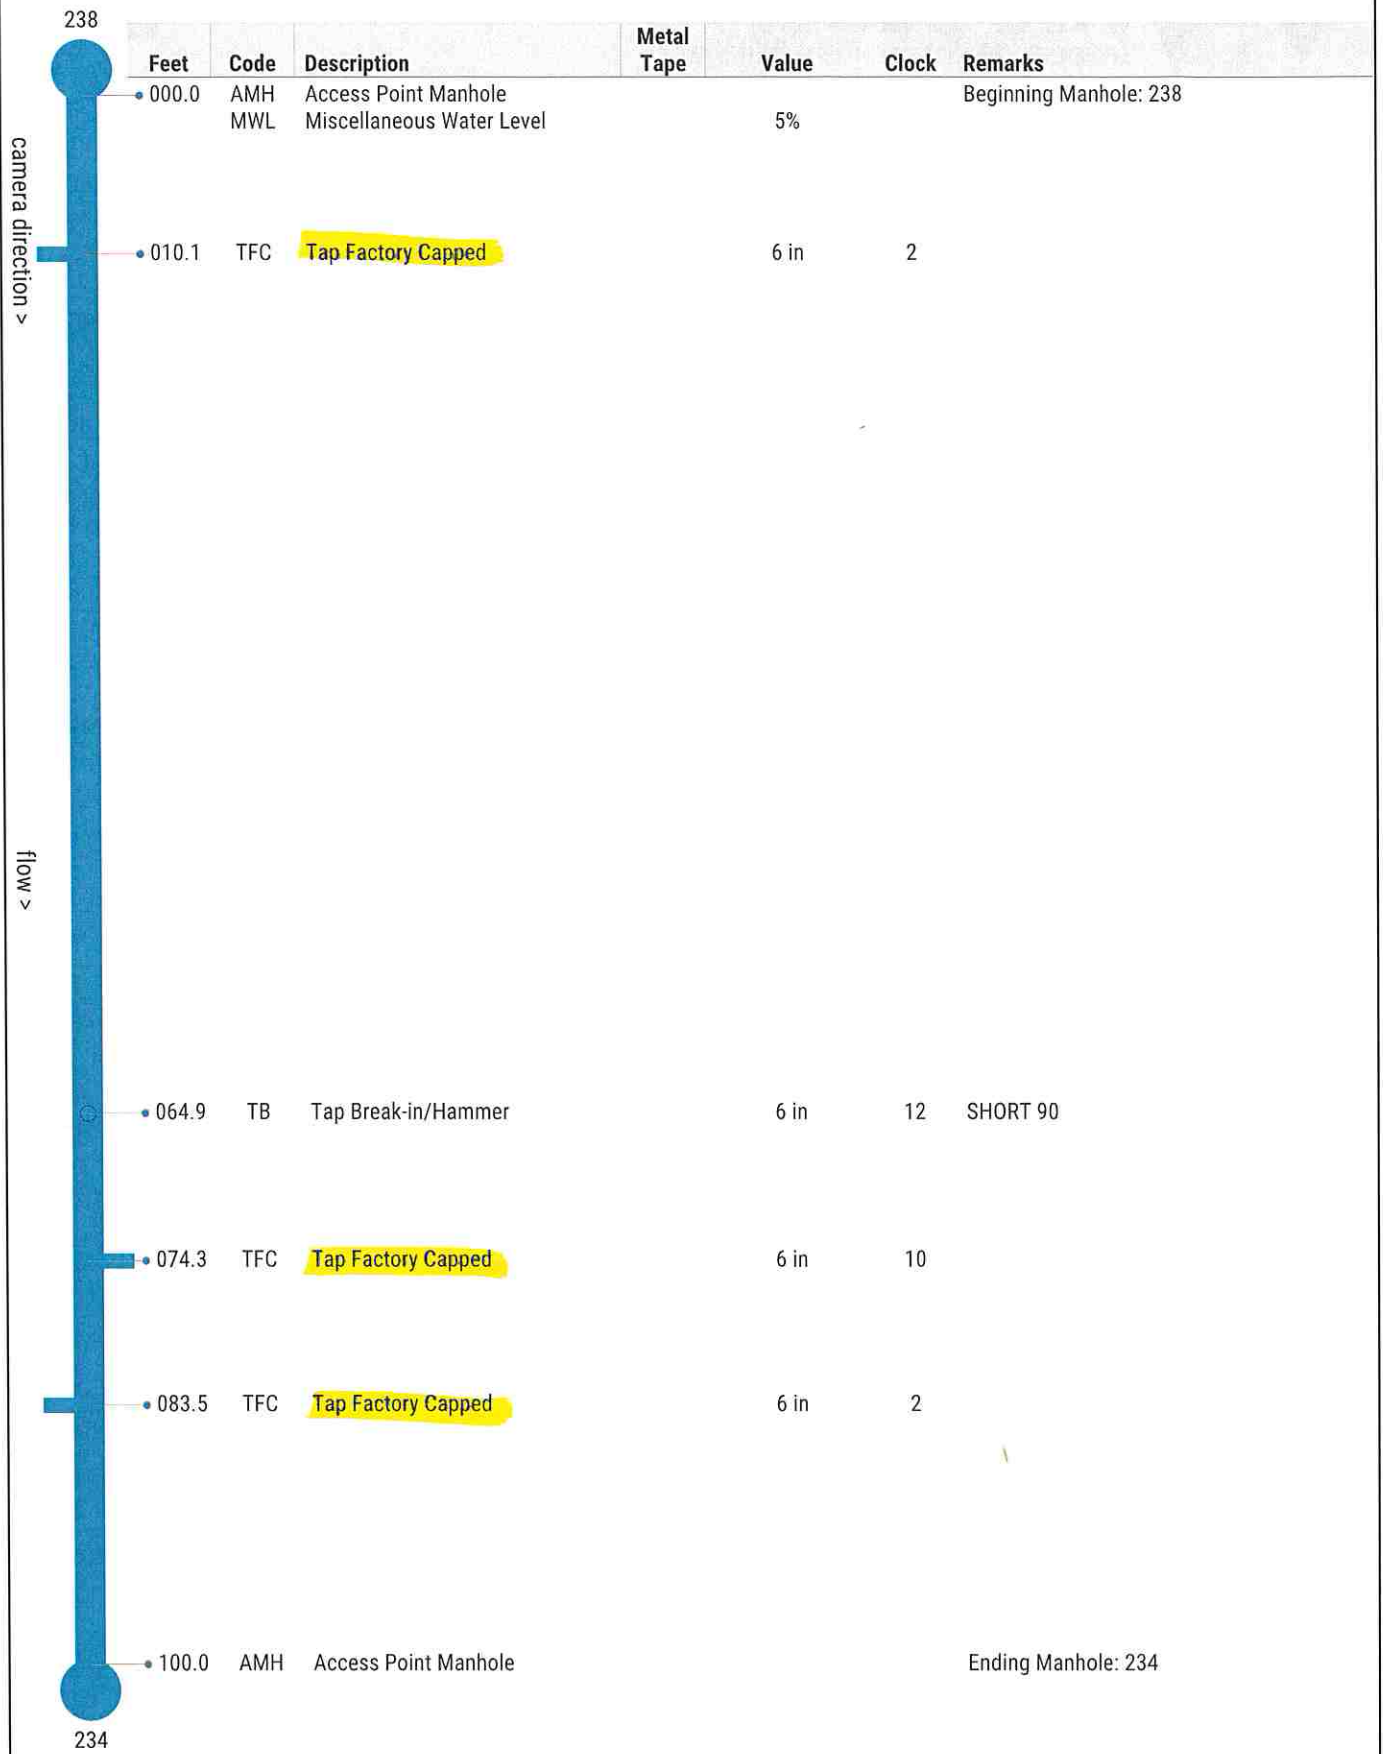

## Inspection Report

### Overview

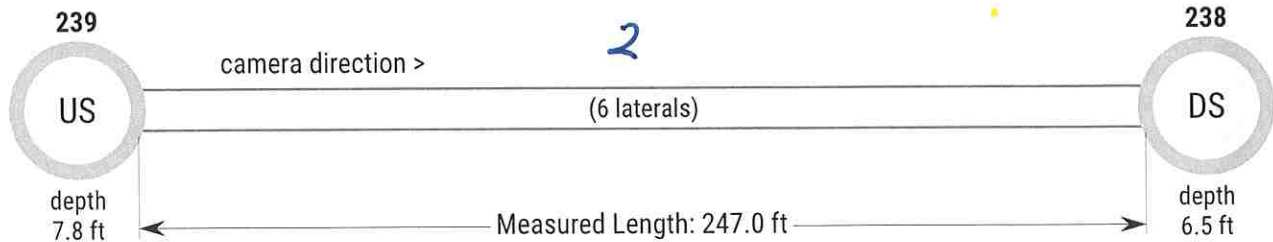

### Asset


Street: TOWNSEND ST  
City: CASSVILLE MO  
Pipe Use: Sanitary Sewage Pipe  
Pipe Geometry: 8 in (Circular)  
Material: Vitrified Clay Pipe  
Map #/Plan File: 15  
Drainage Area:  
Flow Direction: ✓ Southwest  
Surface: Asphalt

### Inspection

Customer: ROSETTA CONSTRUCTION  
Project:  
Job #: 23010MO-11  
Media Date/Time: 2023/04/20 03:22  
Surveyed By: TYLER (P0038607-072022)  
Supervisor: DOUG B  
Pre-Cleaning: Heavy Cleaning  
Truck: 211MO  
Weather: Dry - No Precipitation During Survey  
Additional Info: RAN ROOT SAW TO CUT PVC TAP

7895 St. Claire Ave, East St. Louis, IL 62207


## Observations

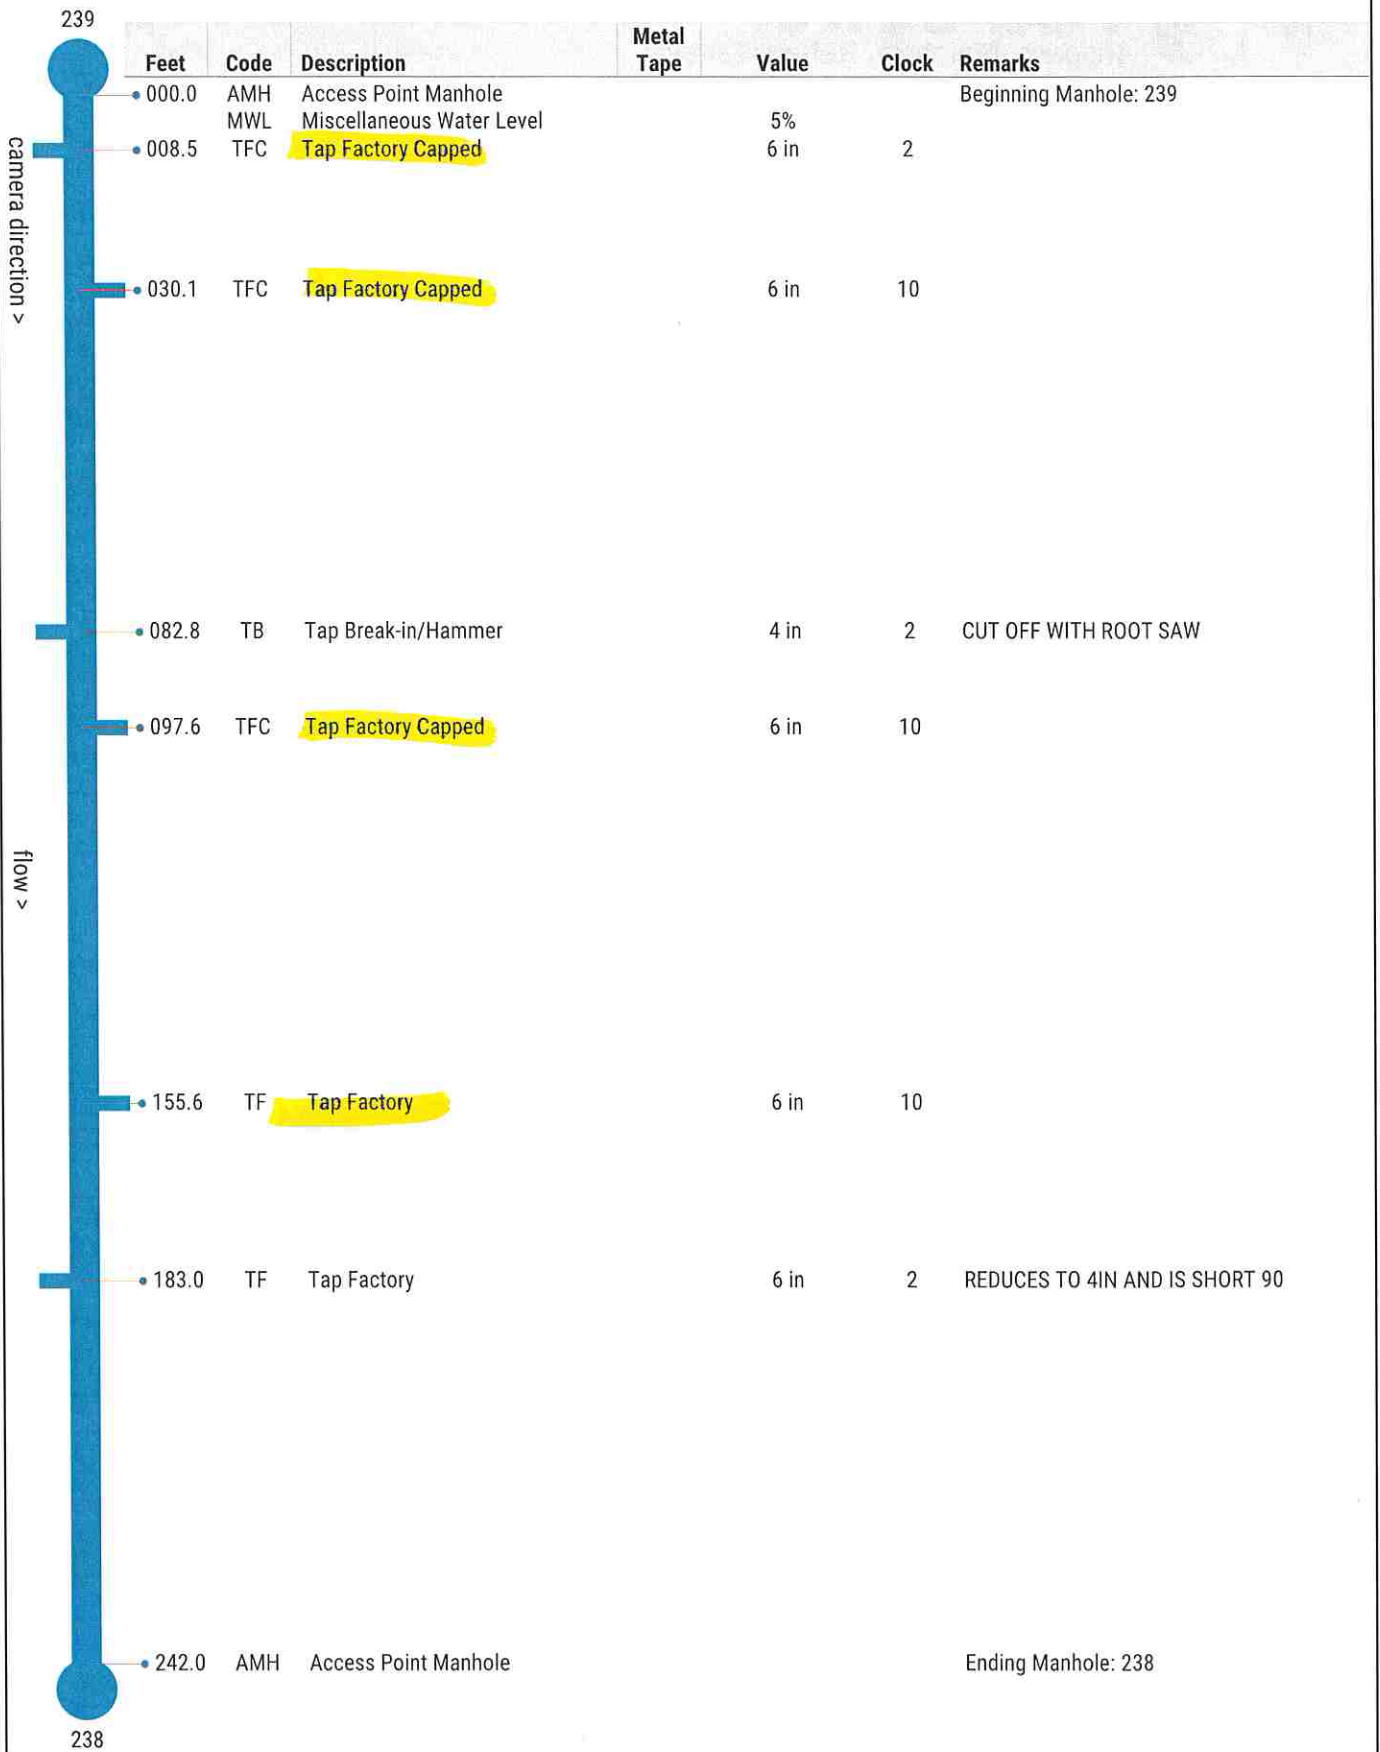



## Inspection Report

### Overview

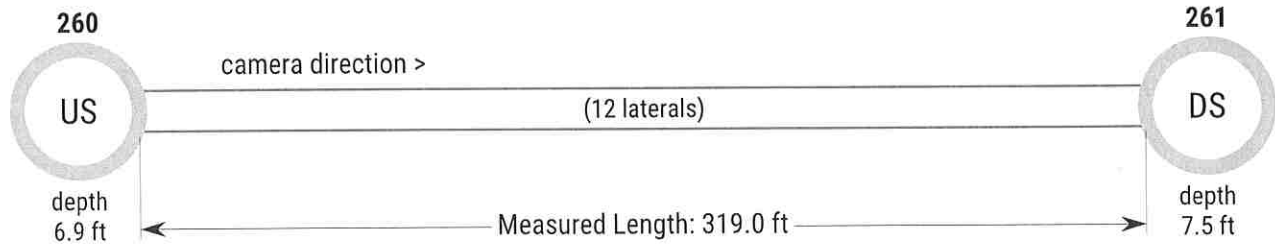

### Asset


Street: IVEY ST  
City: CASSVILLE MO  
Pipe Use: Sanitary Sewage Pipe  
Pipe Geometry: 8 in (Circular)  
Material: Vitrified Clay Pipe  
Map #/Plan File: 14  
Drainage Area:  
Flow Direction: ↓ South  
Surface: Asphalt

### Inspection

Customer: ROSETTA CONSTRUCTION  
Project:  
Job #: 23010MO-11  
Media Date/Time: 2023/04/13 08:16  
Surveyed By: TYLER (P0038607-072022)  
Supervisor: DOUG B  
Pre-Cleaning: Light Cleaning  
Truck: 211MO  
Weather: Dry - No Precipitation During Survey  
Additional Info:


7895 St. Claire Ave, East St. Louis, IL 62207

## Observations

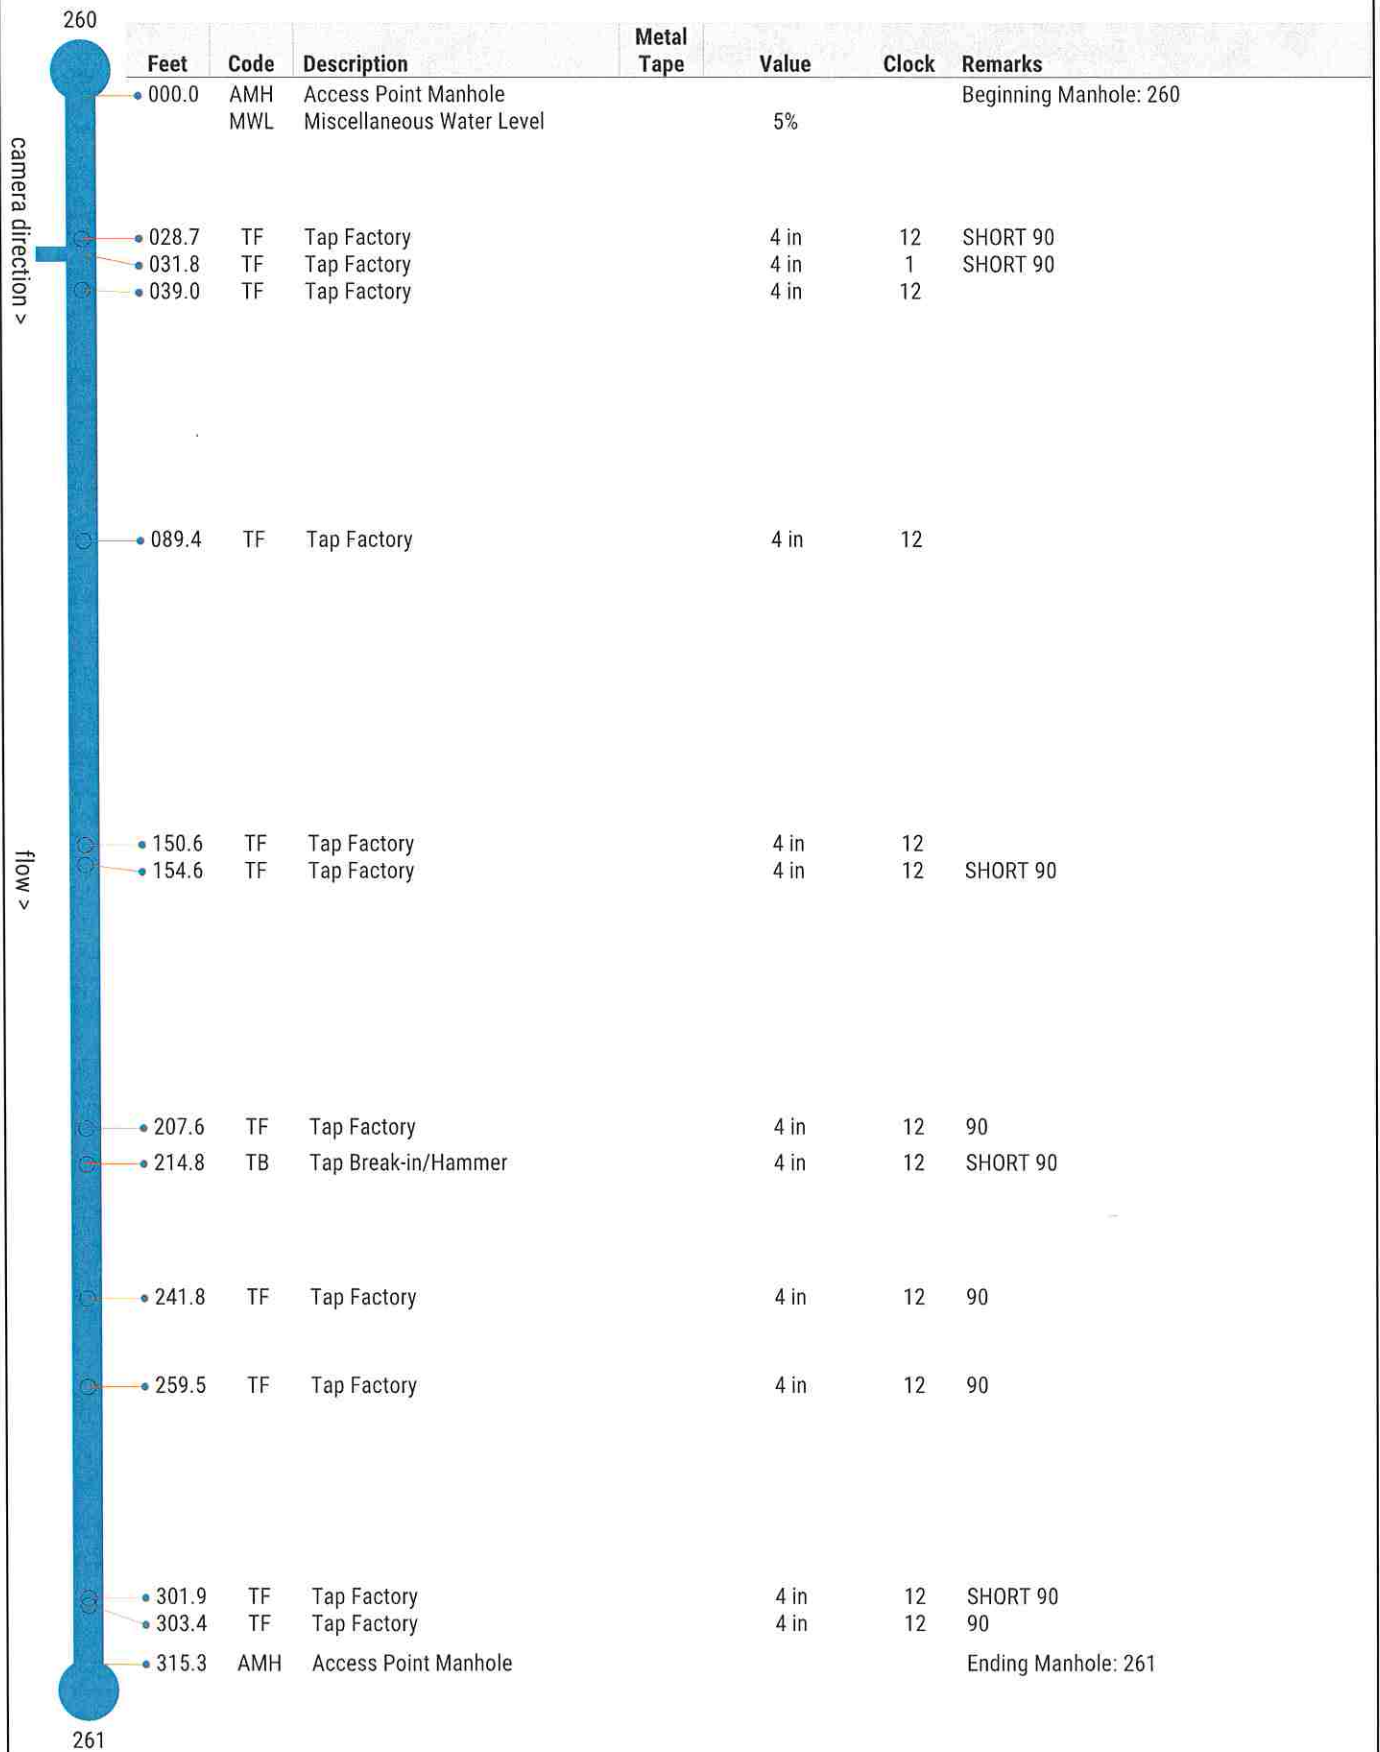

## Inspection Report

### Overview

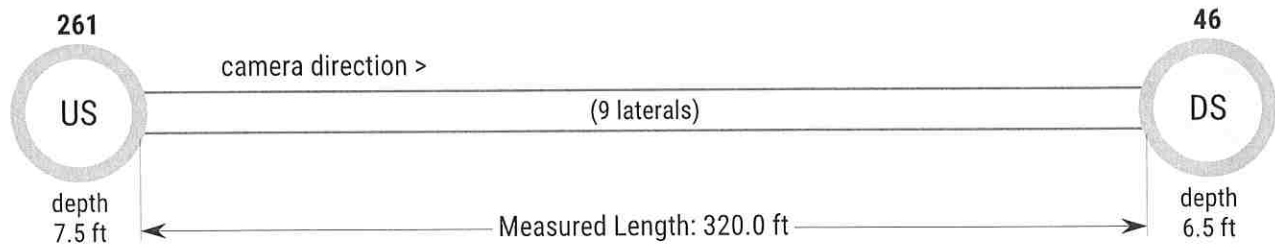

### Asset


Street: IVEY ST  
City: CASSVILLE MO  
Pipe Use: Sanitary Sewage Pipe  
Pipe Geometry: 8 in (Circular)  
Material: Vitrified Clay Pipe  
Map #/Plan File: 14  
Drainage Area:  
Flow Direction: ↓ South  
Surface: Asphalt

### Inspection

Customer: ROSETTA CONSTRUCTION  
Project:  
Job #: 23010MO-11  
Media Date/Time: 2023/04/13 09:02  
Surveyed By: TYLER (P0038607-072022)  
Supervisor: DOUG B  
Pre-Cleaning: Light Cleaning  
Truck: 211MO  
Weather: Dry - No Precipitation During Survey  
Additional Info:


7895 St. Claire Ave, East St. Louis, IL 62207

## Observations

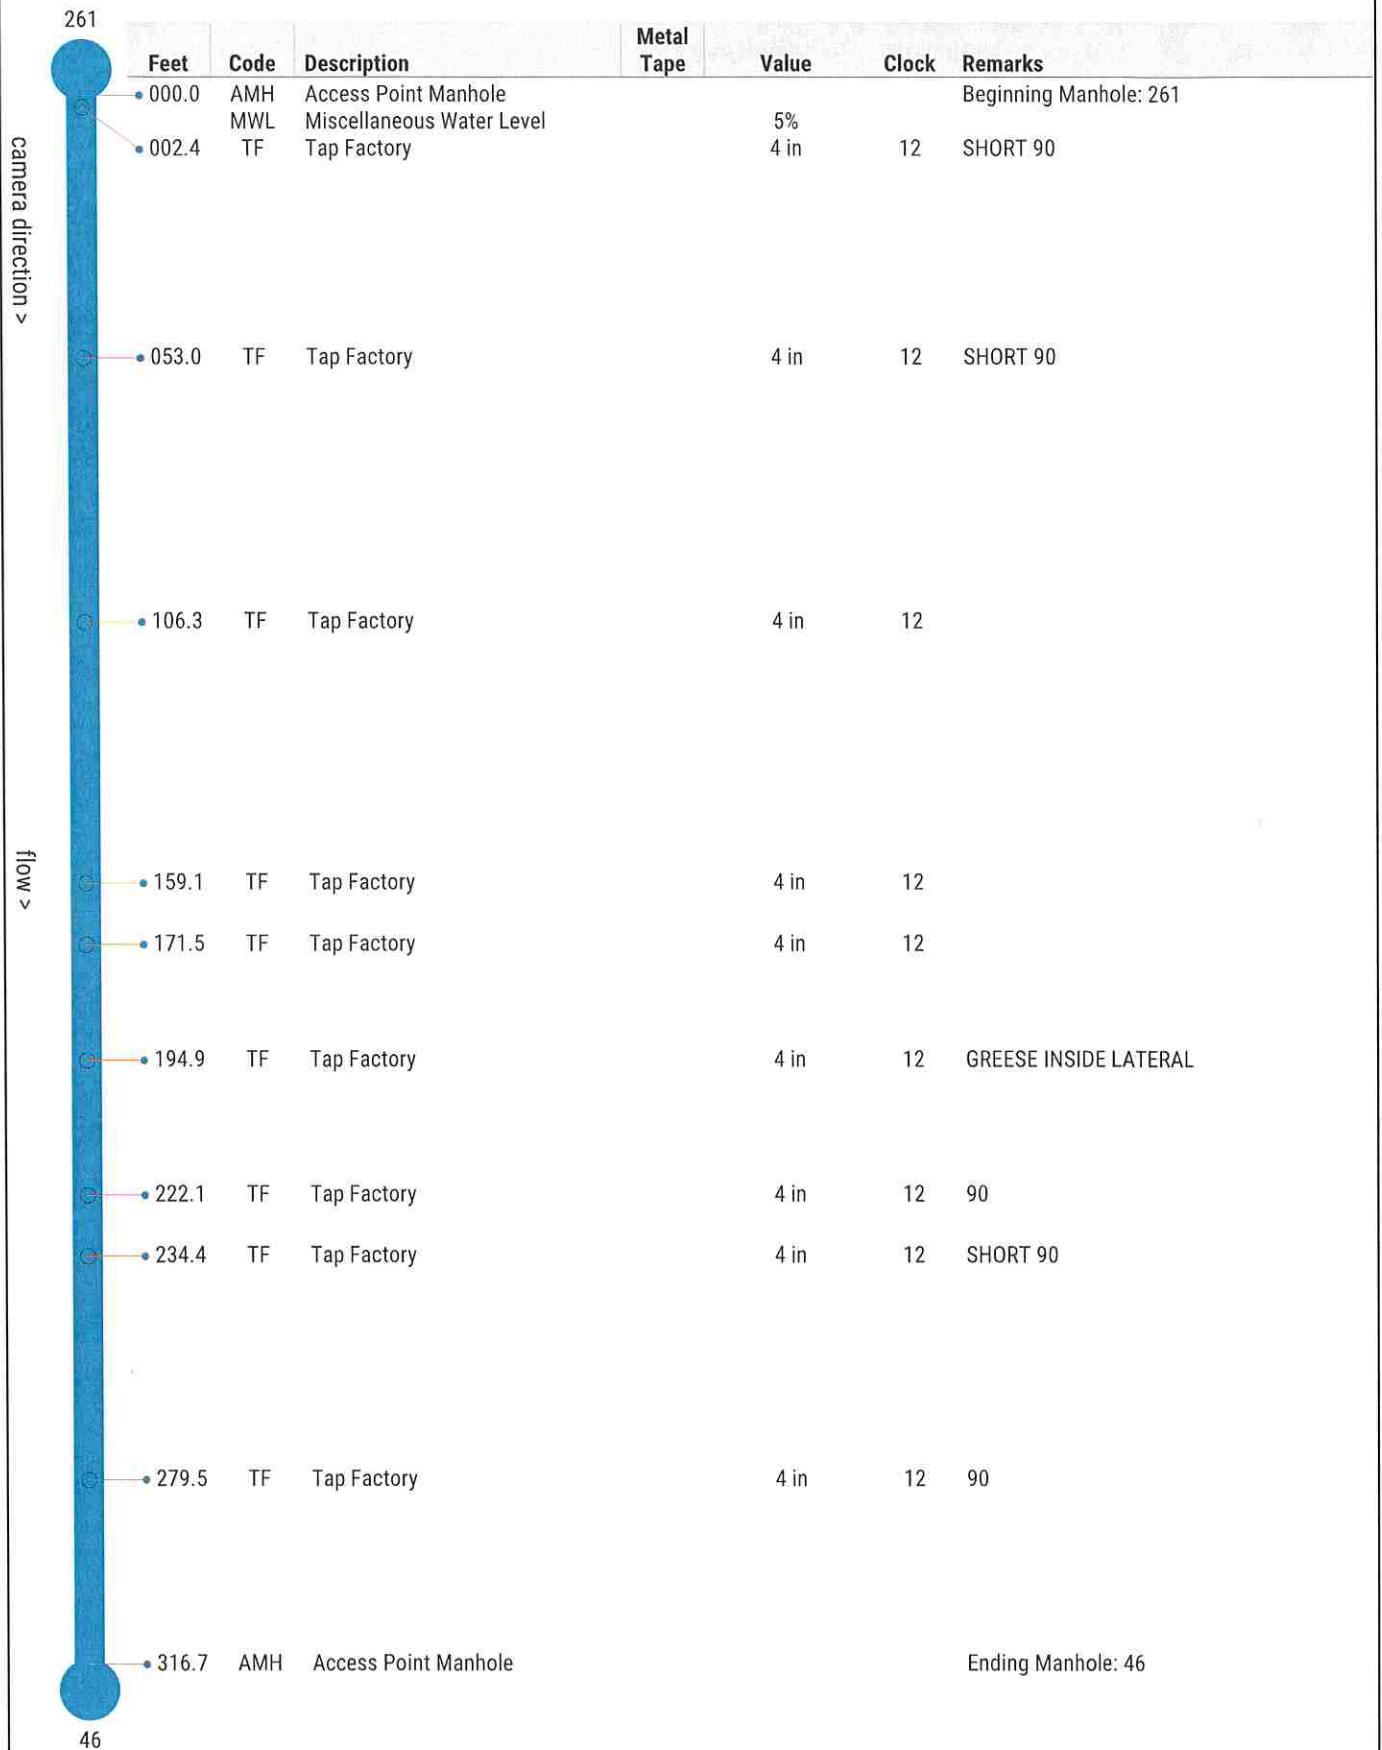

## Inspection Report

### Overview

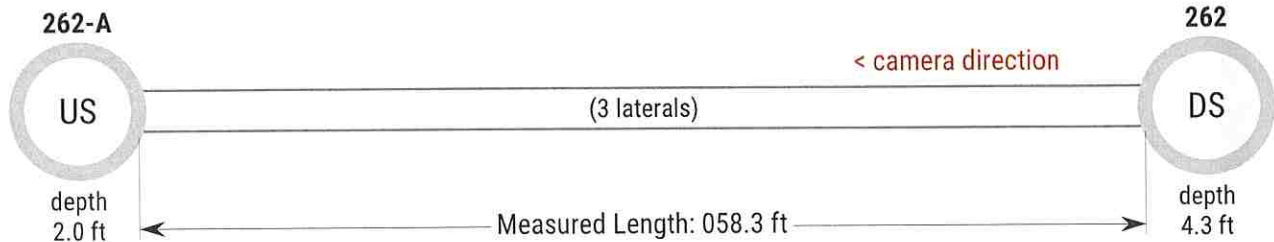

### Asset

Street: 13TH ST  
City: CASSVILLE MO  
Pipe Use: Sanitary Sewage Pipe  
Pipe Geometry: 8 in (Circular)  
Material: Vitrified Clay Pipe  
Map #/Plan File: 15  
Drainage Area:  
Flow Direction: →East  
Surface: Asphalt


### Inspection

Customer: ROSETTA CONSTRUCTION  
Project:  
Job #: 23010MO-11  
Media Date/Time: 2023/04/18 06:24  
Surveyed By: TYLER (P0038607-072022)  
Supervisor: DOUG B  
Pre-Cleaning: Light Cleaning  
Truck: 211MO  
Weather: Dry - No Precipitation During Survey  
Additional Info: SEE DAMAGE REPORT BEFORE JETTING  
THIS LINE AGAIN. UPSTREAM IS A  
LAMPHOLE INSIDE A MANHOLE. WILL

7895 St. Claire Ave, East St. Louis, IL 62207

## Observations


262-A

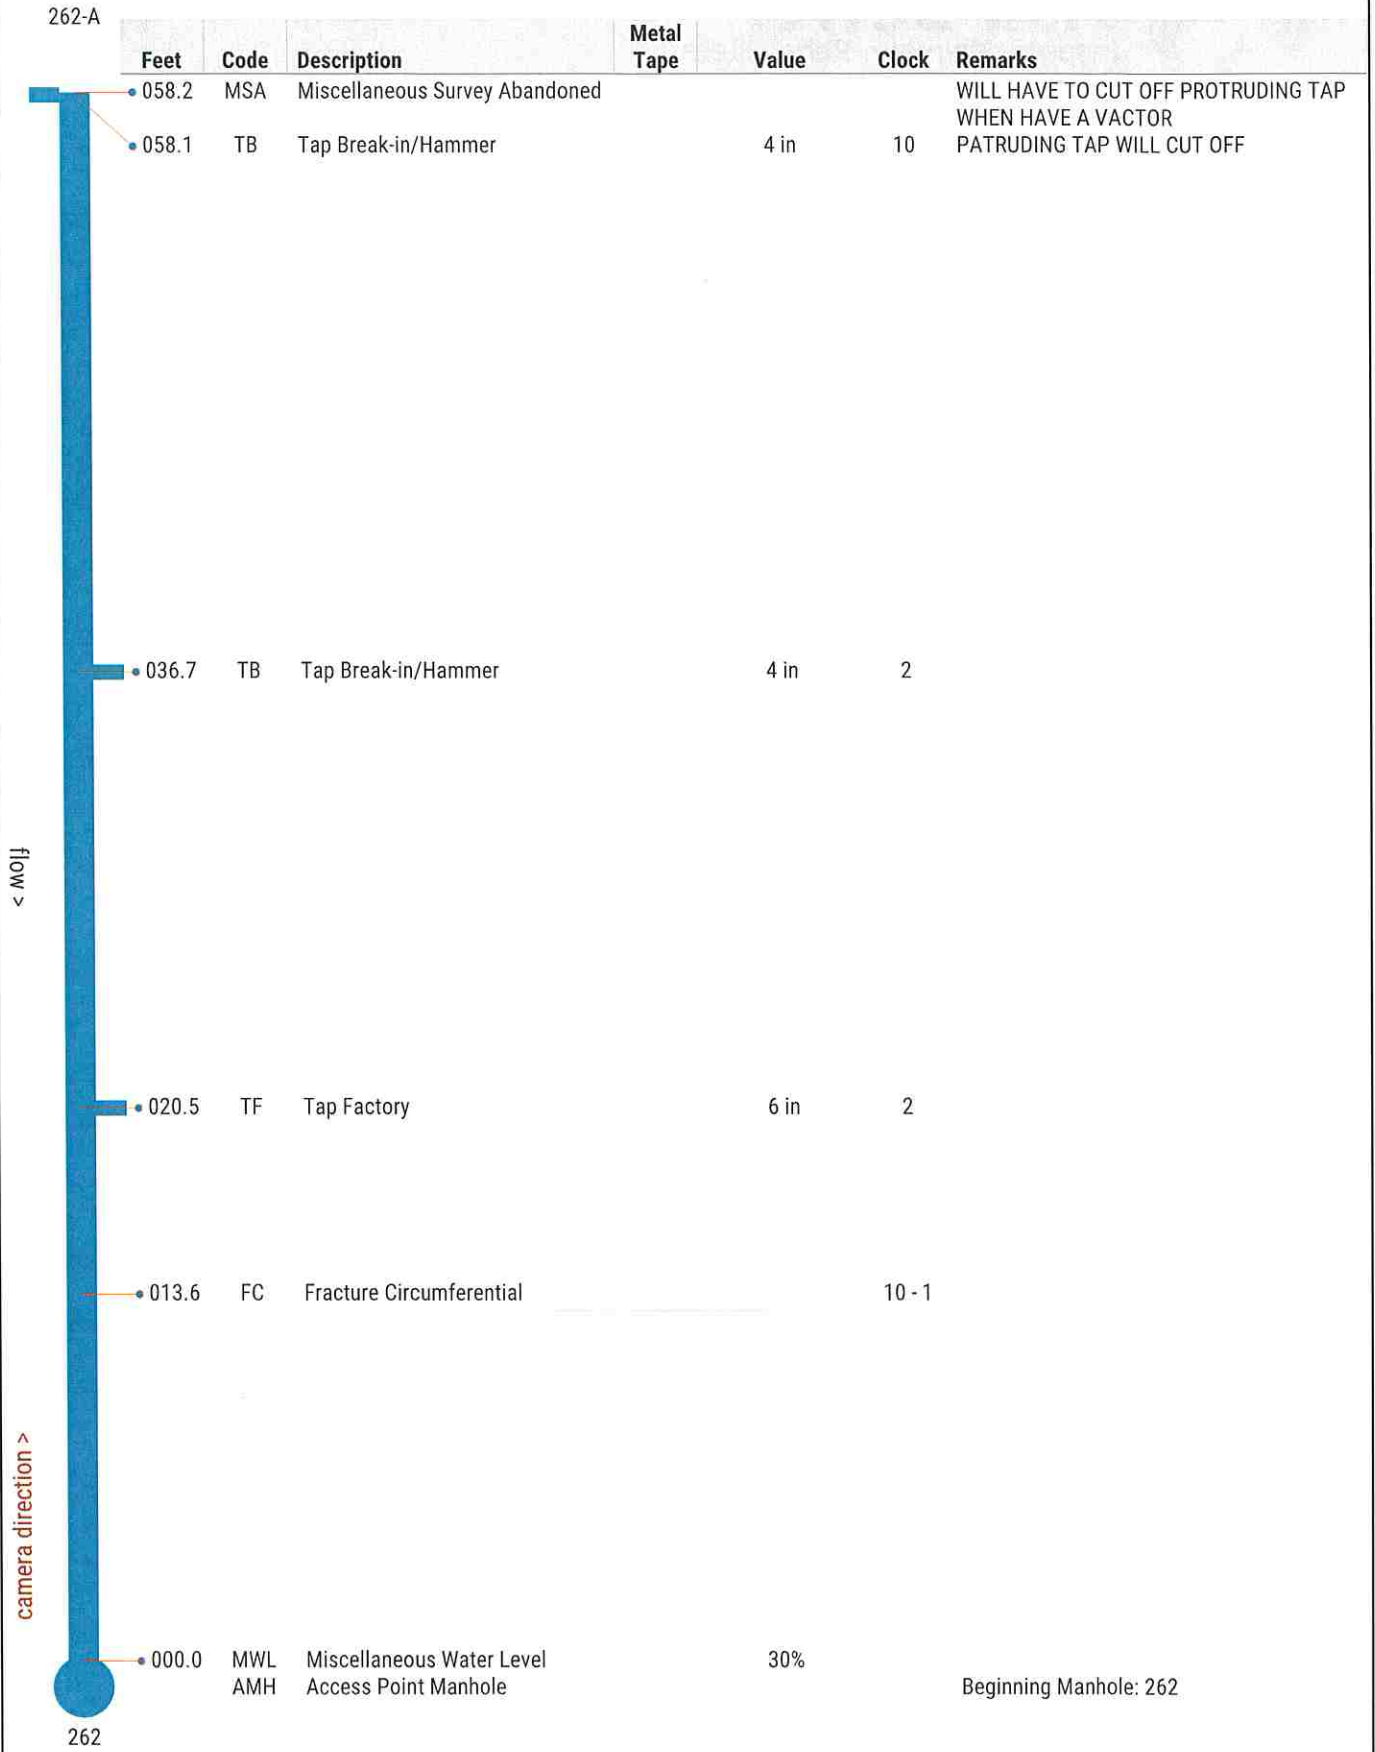



## Inspection Report

### Overview

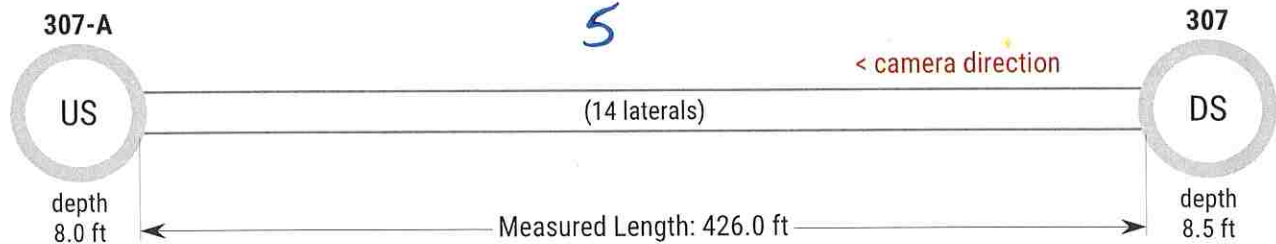

### Asset

Street: 11TH ST  
City: CASSVILLE MO  
Pipe Use: Sanitary Sewage Pipe  
Pipe Geometry: 8 in (Circular)  
Material: Vitrified Clay Pipe  
Map #/Plan File: 15  
Drainage Area:  
Flow Direction: ↗Northeast  
Surface: Grass

### Inspection

Customer: ROSETTA CONSTRUCTION  
Project:  
Job #: 23010MO-11  
Media Date/Time: 2023/04/20 12:30  
Surveyed By: TYLER (P0038607-072022)  
Supervisor: DOUG B  
Pre-Cleaning: Heavy Cleaning  
Truck: 211MO  
Weather: Dry - No Precipitation During Survey  
Additional Info: RAN ROOT SAW TO CUT TAP AND ROOTS


7895 St. Claire Ave, East St. Louis, IL 62207

## Observations

307-A		Feet	Code	Description	Metal Tape	Value	Clock	Remarks
	• 422.3	AMH	Access Point Manhole					Ending Manhole: 307-A
	• 418.1	TF	Tap Factory			6 in	10	FULL OF DEBRIS
	• 410.3	TB	Tap Break-in/Hammer			4 in	12	SHORT 90
	• 365.9	TF	Tap Factory			6 in	10	FULL OF ROOTS
	• 289.7	TF	Tap Factory			6 in	10	
	• 268.2	TF	Tap Factory			6 in	2	
	• 215.3		Tap Factory			6 in	3	
	• 178.0	TB	Tap Break-in/Hammer			4 in	12	CUT WITH ROOT SAW, CANNOT GET ANY BETTER CUT
	• 172.8	TB	Tap Break-in/Hammer			4 in	12	
	• 169.4	TF	Tap Factory			6 in	10	
	• 114.2	TF	Tap Factory			6 in	2	
	• 098.6	TF	Tap Factory			6 in	10	FULL OF ROOTS
	• 049.8	TB	Tap Break-in/Hammer			6 in	10	OFFSET AND REDUCES TO 4IN
	• 043.5	TF	Tap Factory			6 in	2	
	• 040.2	TB	Tap Break-in/Hammer			4 in	12	ORANGEBURG
	• 021.0	TF	Tap Factory			6 in	2	
307		• 000.0	MWL AMH	Miscellaneous Water Level Access Point Manhole		5%		Beginning Manhole: 307

## Inspection Report

### Overview

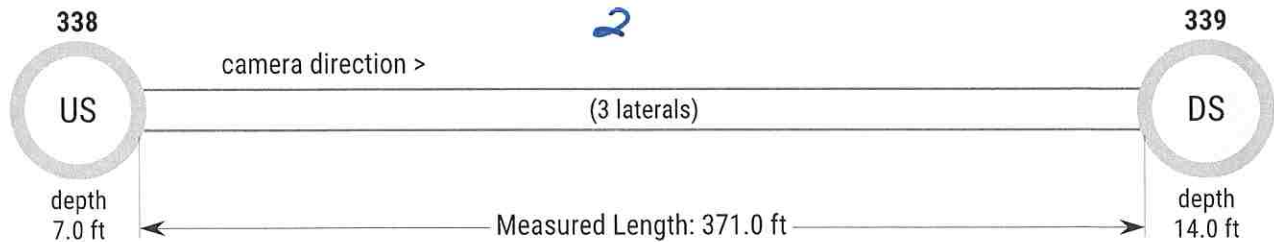

### Asset


Street: E 13TH ST  
City: CASSVILLE MO  
Pipe Use: Sanitary Sewage Pipe  
Pipe Geometry: 8 in (Circular)  
Material: Vitrified Clay Pipe  
Map #/Plan File: 16  
Drainage Area:  
Flow Direction: ←West  
Surface: Asphalt

### Inspection

Customer: ROSETTA CONSTRUCTION  
Project:  
Job #: 23010MO-11  
Media Date/Time: 2023/04/19 09:29  
Surveyed By: TYLER (P0038607-072022)  
Supervisor: DOUG B  
Pre-Cleaning: Light Cleaning  
Truck: 211MO  
Weather: Dry - No Precipitation During Survey  
Additional Info: DROP AT THE DOWN STREAM MANHOLE


7895 St. Claire Ave, East St. Louis, IL 62207

## Observations

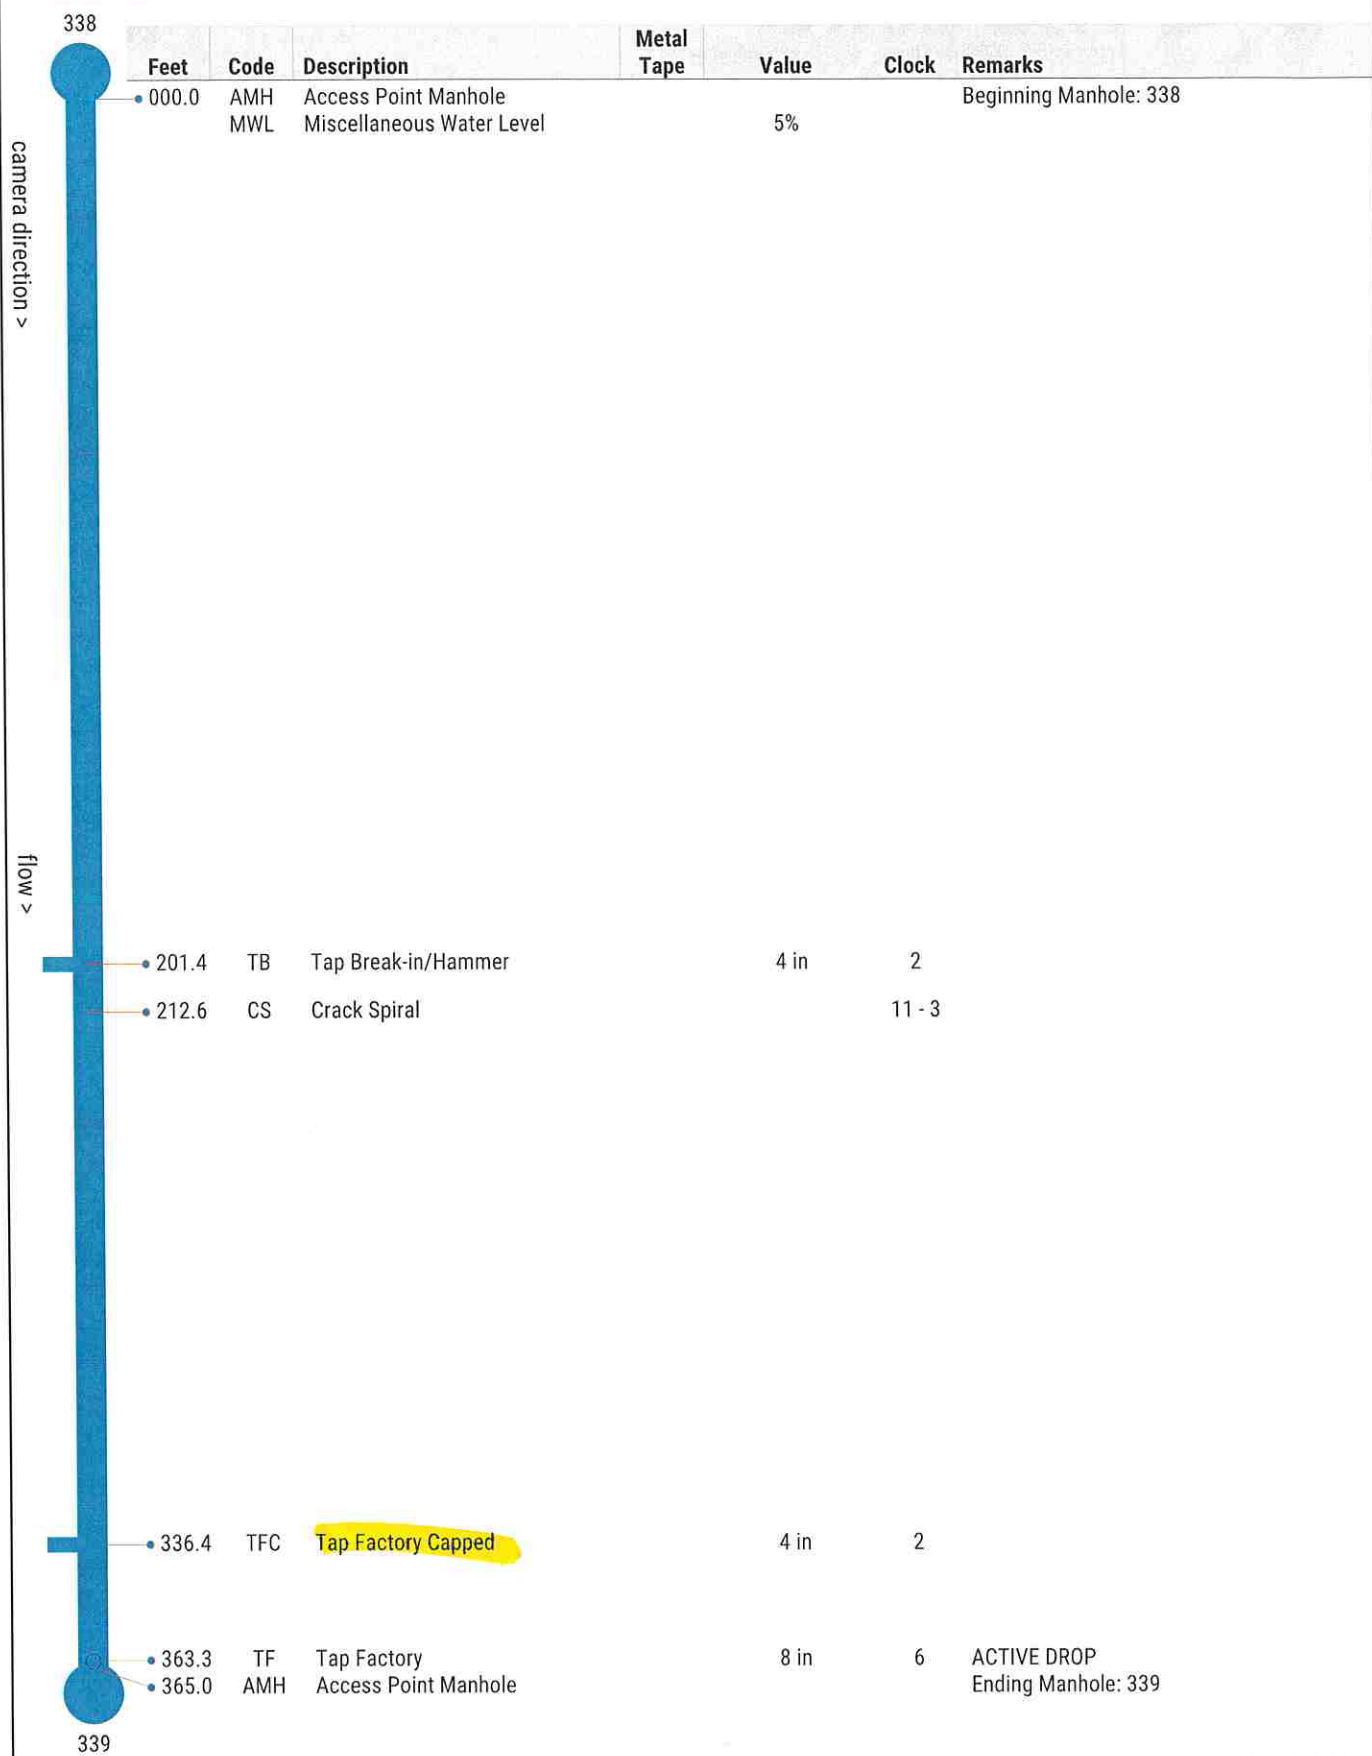

## Inspection Report

### Overview

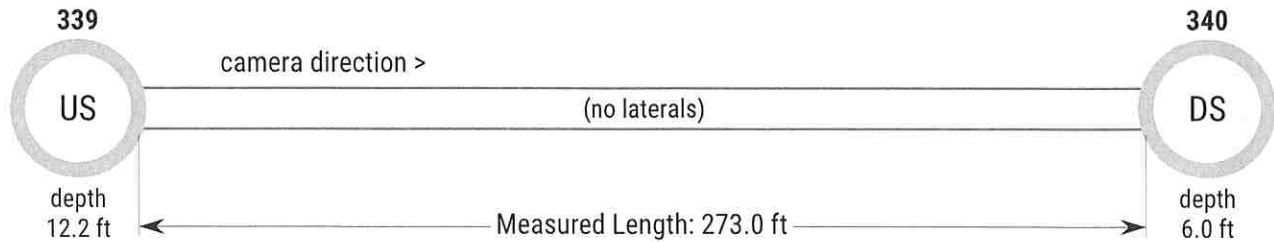

### Asset


Street: 13TH ST  
City: CASSVILLE MO  
Pipe Use: Sanitary Sewage Pipe  
Pipe Geometry: 8 in (Circular)  
Material: Vitrified Clay Pipe  
Map #/Plan File: 16  
Drainage Area:  
Flow Direction: ↖ Northwest  
Surface: Grass

### Inspection

Customer: ROSETTA CONSTRUCTION  
Project:  
Job #: 23010MO-11  
Media Date/Time: 2023/05/01 03:38  
Surveyed By: TYLER (P0038607-072022)  
Supervisor: DOUG B  
Pre-Cleaning: Heavy Cleaning  
Truck: 211MO  
Weather: Dry - No Precipitation During Survey  
Additional Info: RAN ROOT SAW TO CUT ROOTS AND GREASE

7895 St. Claire Ave, East St. Louis, IL 62207


## Observations

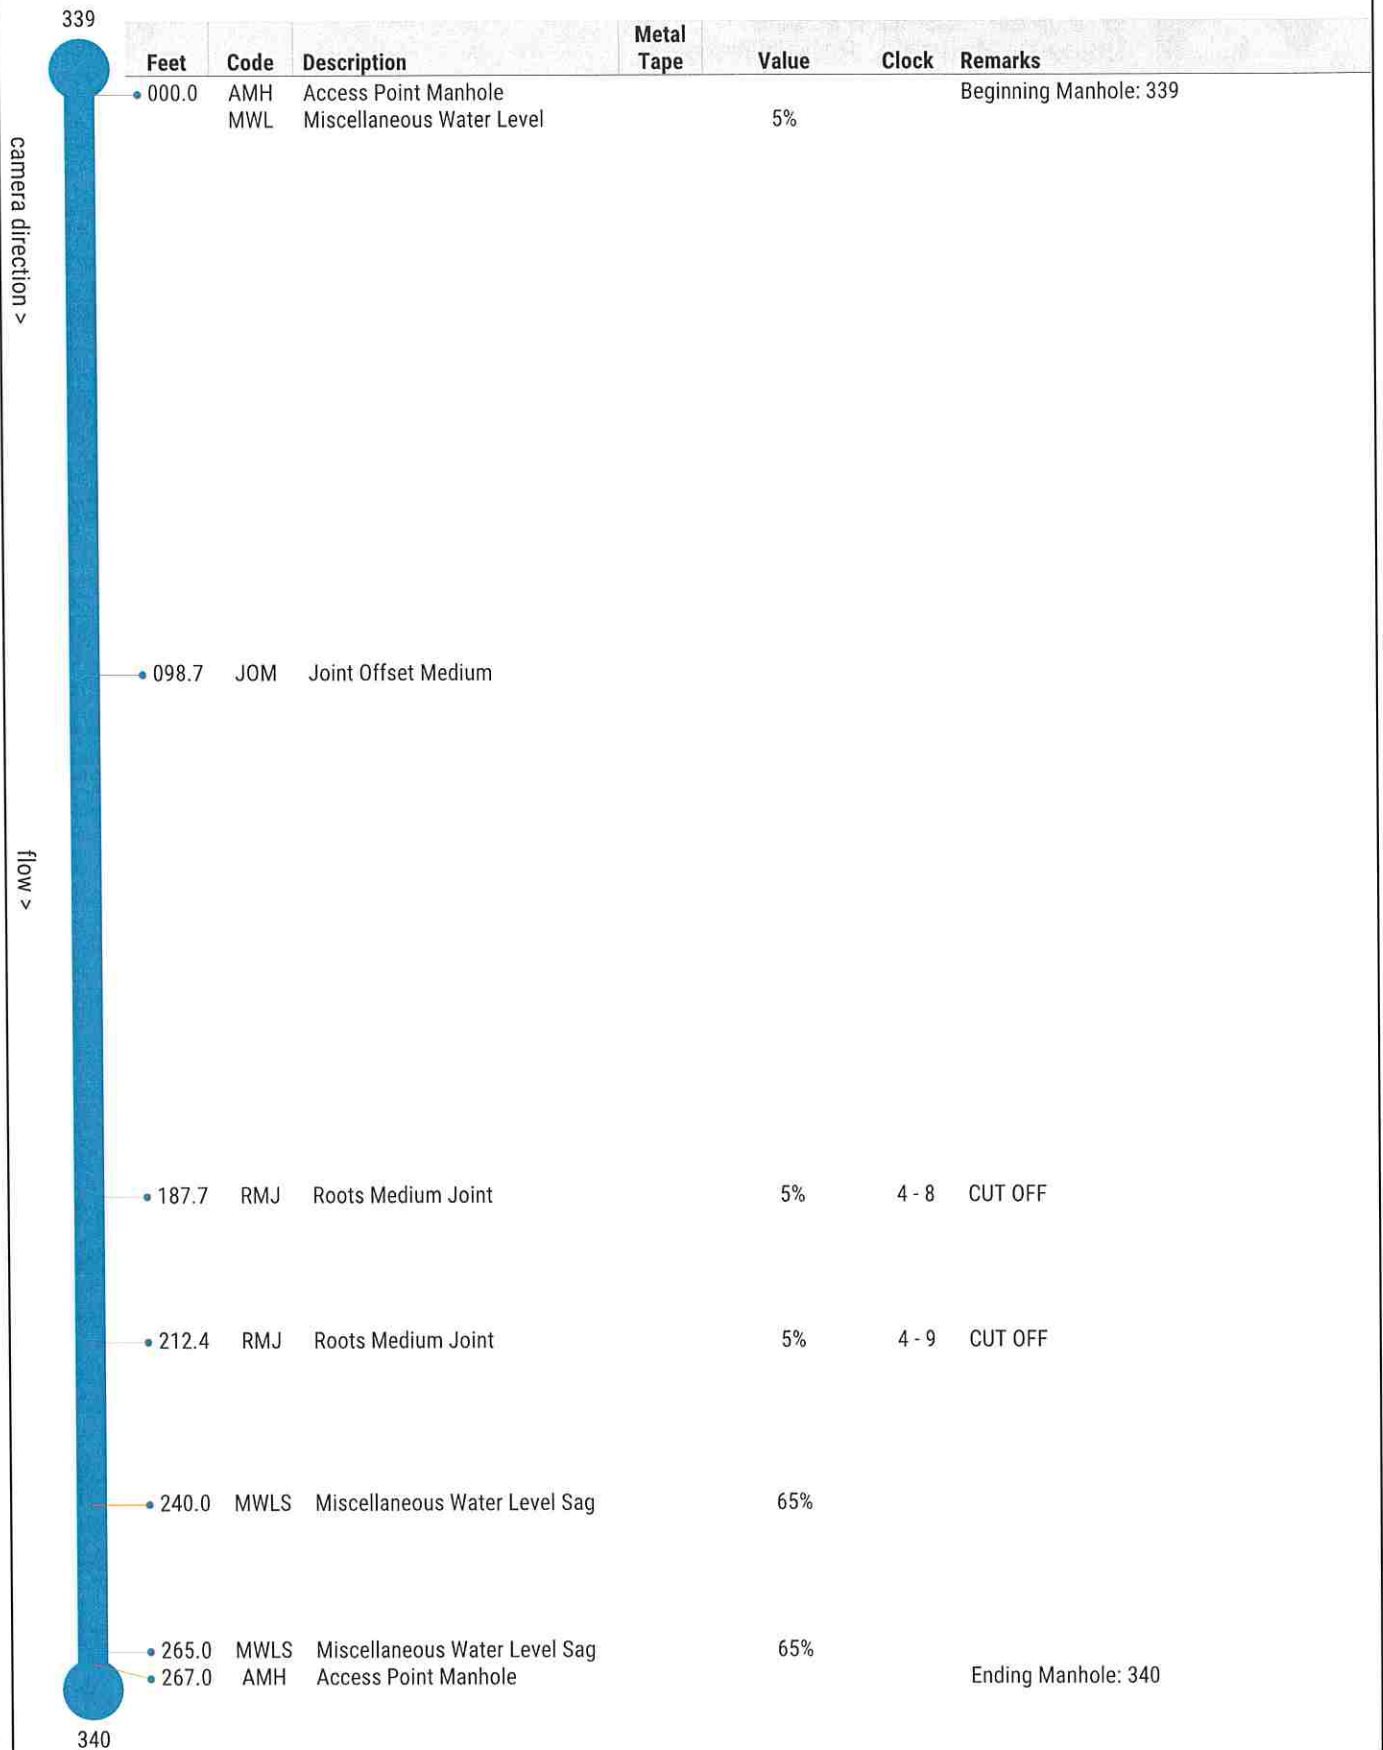



## Inspection Report

### Overview

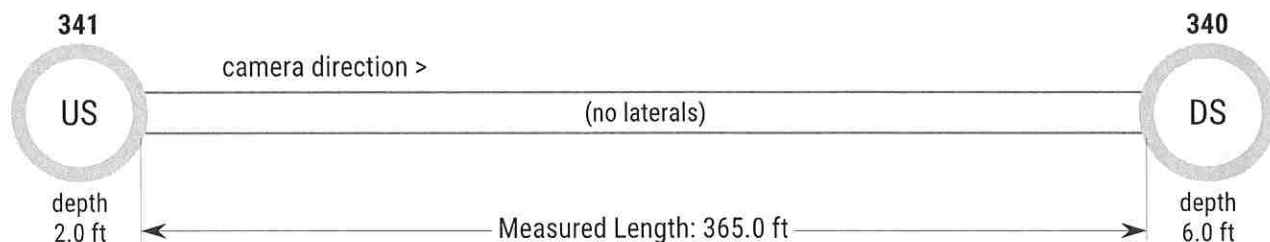

### Asset


Street: WILDWOOD DR  
City: CASSVILLE MO  
Pipe Use: Sanitary Sewage Pipe  
Pipe Geometry: 8 in (Circular)  
Material: Vitrified Clay Pipe  
Map #/Plan File: 16  
Drainage Area:  
Flow Direction: ✓ Southwest  
Surface: Grass

### Inspection

Customer: ROSETTA CONSTRUCTION  
Project:  
Job #: 23010MO-11  
Media Date/Time: 2023/05/01 03:15  
Surveyed By: TYLER (P0038607-072022)  
Supervisor: DOUG B  
Pre-Cleaning: Light Cleaning  
Truck: 211MO  
Weather: Dry - No Precipitation During Survey  
Additional Info:


7895 St. Claire Ave, East St. Louis, IL 62207

## Observations

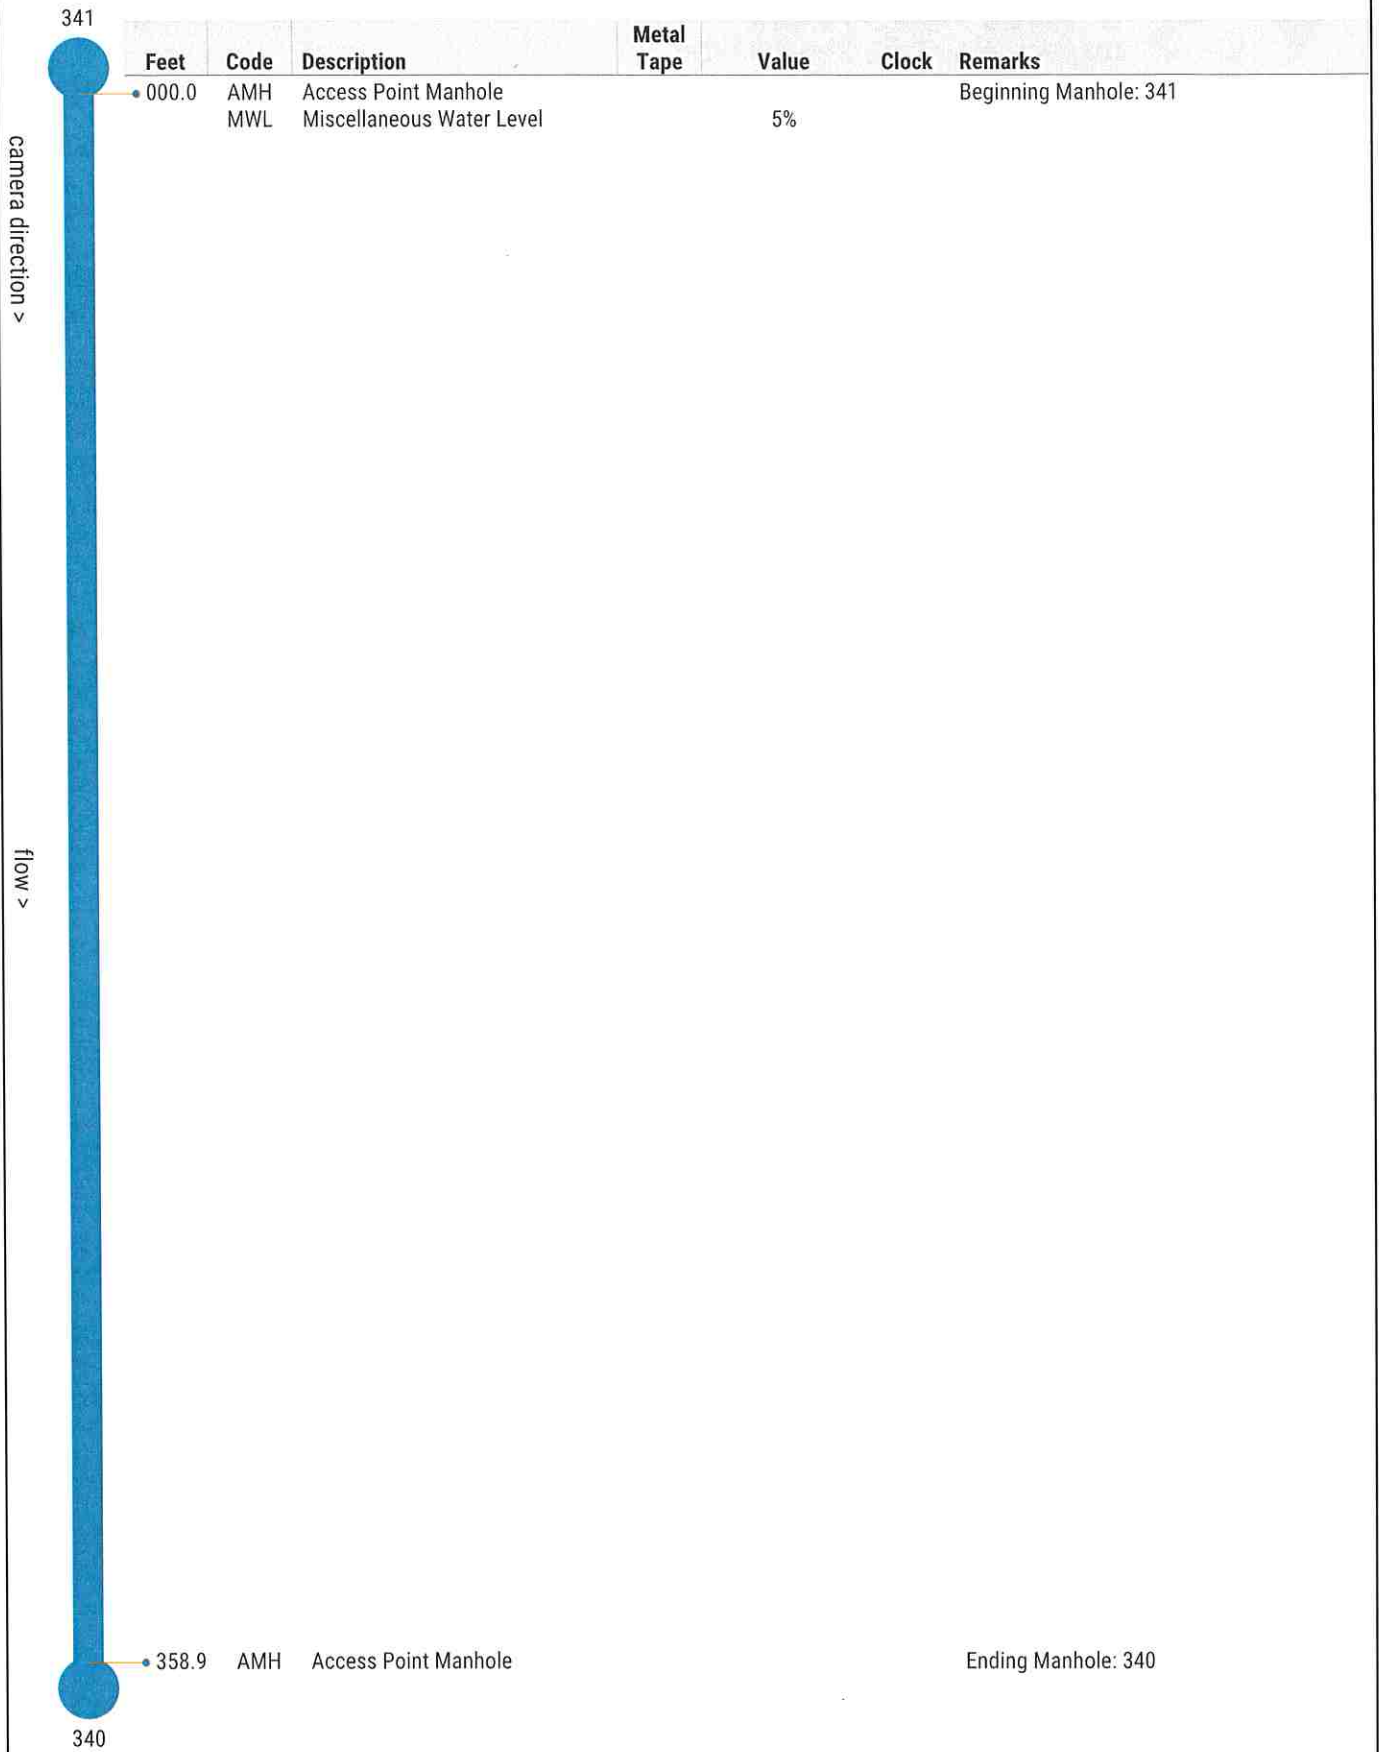

## Inspection Report

### Overview

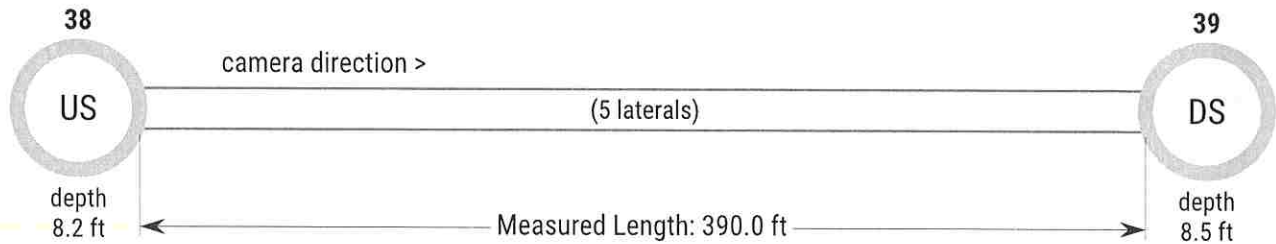

### Asset


Street: PRESELY DR  
City: CASSVILLE MO  
Pipe Use: Sanitary Sewage Pipe  
Pipe Geometry: 8 in (Circular)  
Material: Polyvinyl Chloride  
Map #/Plan File: 14  
Drainage Area:  
Flow Direction: ↓ South  
Surface: Asphalt

### Inspection

Customer: ROSETTA CONSTRUCTION  
Project:  
Job #: 23010MO-11  
Media Date/Time: 2023/04/11 12:09  
Surveyed By: TYLER (P0038607-072022)  
Supervisor: DOUG B  
Pre-Cleaning: Light Cleaning  
Truck: 211MO  
Weather: Dry - No Precipitation During Survey  
Additional Info:


7895 St. Claire Ave, East St. Louis, IL 62207

## Observations

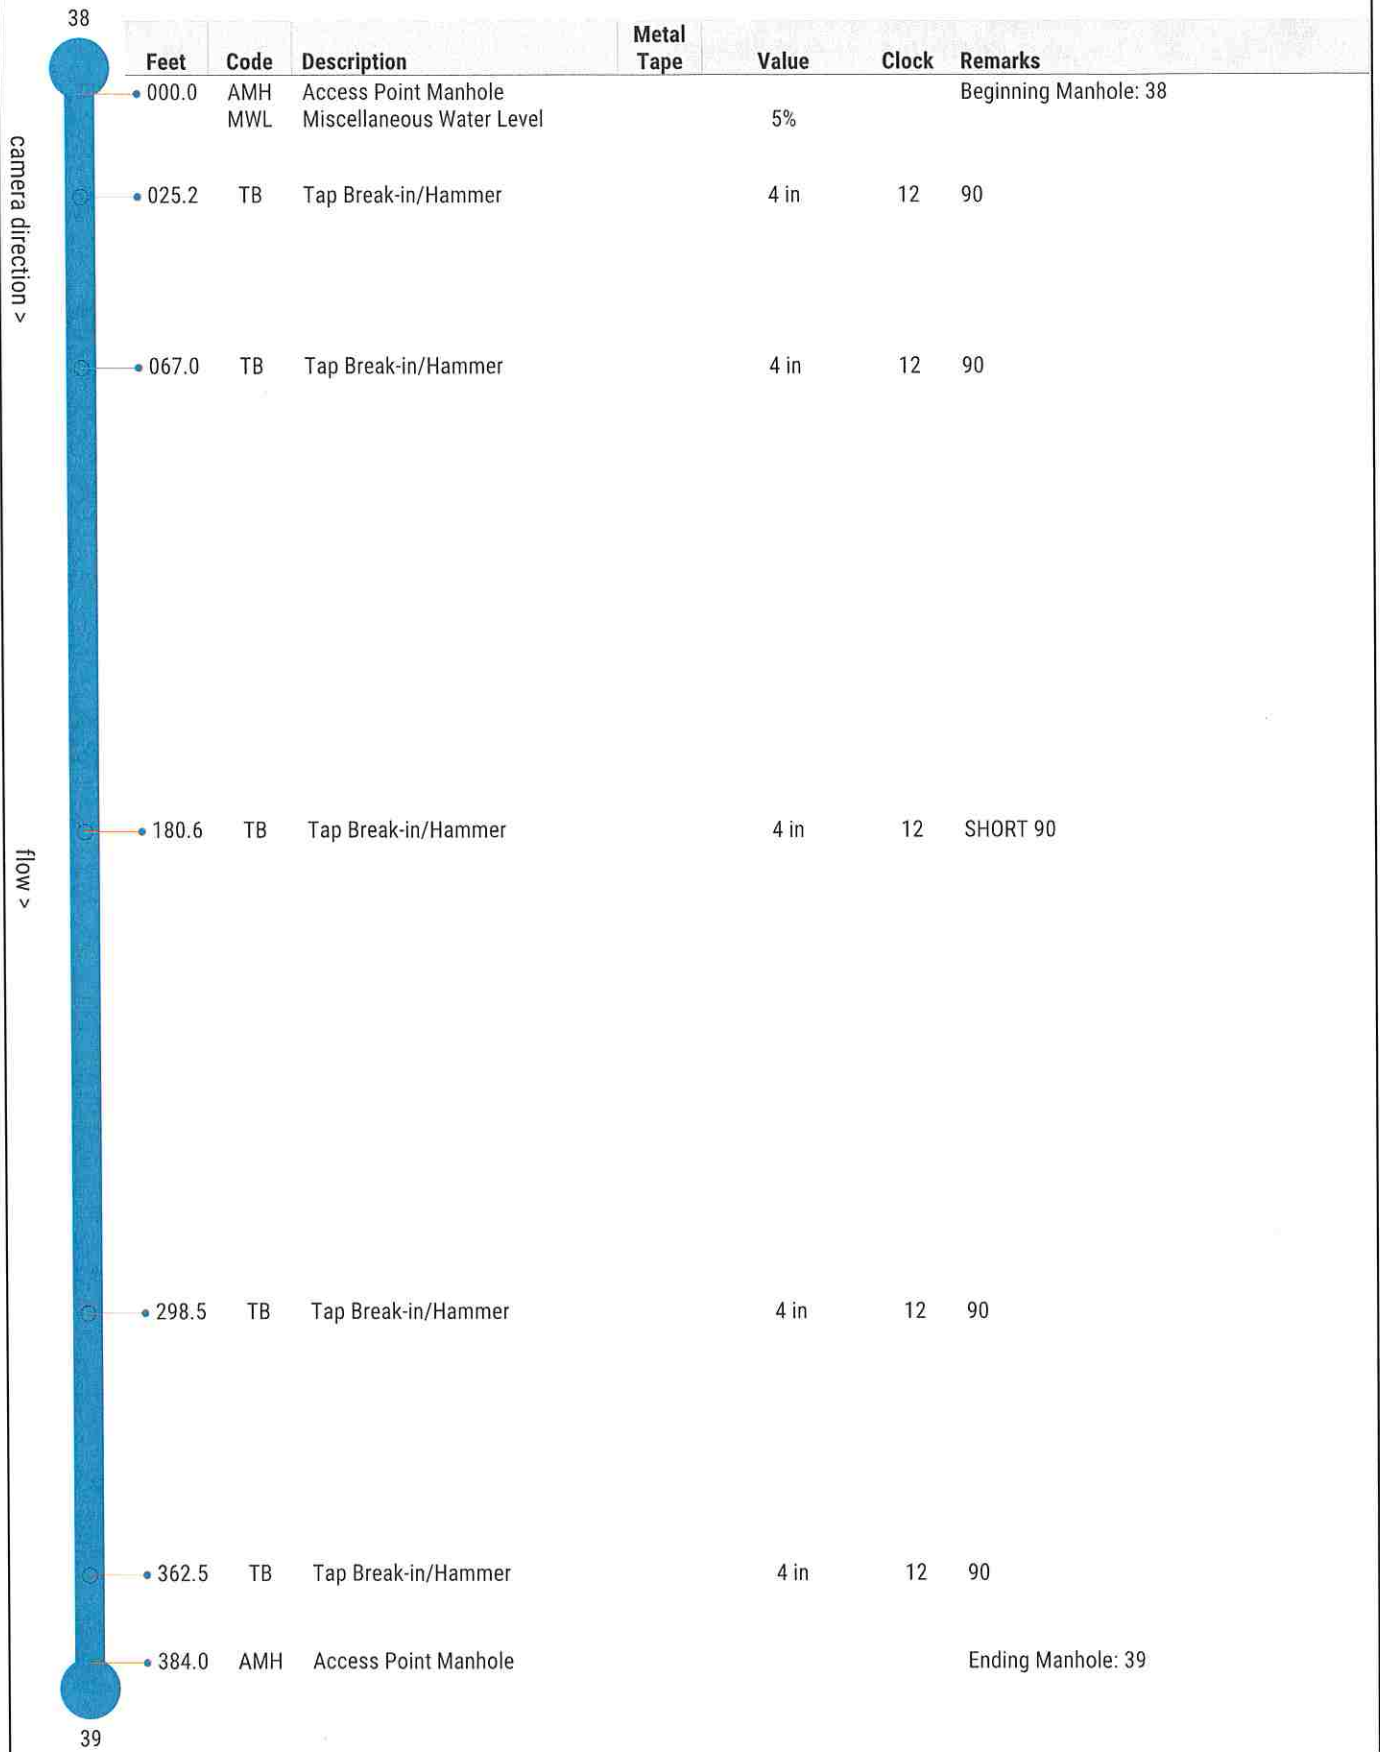

## Inspection Report

### Overview

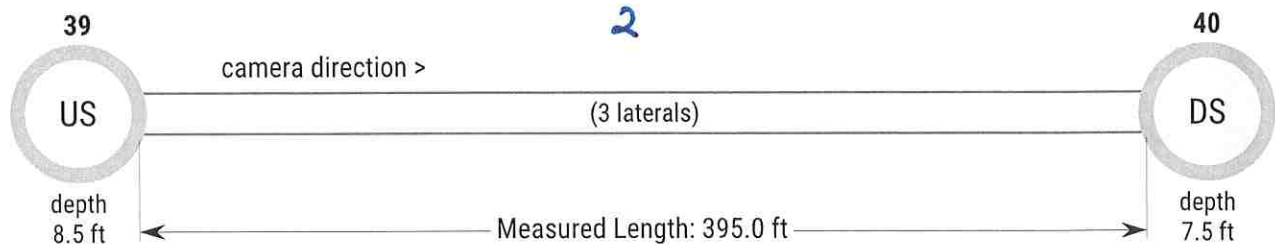

### Asset


Street: PRESELY DR  
City: CASSVILLE MO  
Pipe Use: Sanitary Sewage Pipe  
Pipe Geometry: 8 in (Circular)  
Material: Polyvinyl Chloride  
Map #/Plan File: 14  
Drainage Area:  
Flow Direction: ↓ South  
Surface: Asphalt

### Inspection

Customer: ROSETTA CONSTRUCTION  
Project:  
Job #: 23010MO-11  
Media Date/Time: 2023/04/11 12:55  
Surveyed By: TYLER (P0038607-072022)  
Supervisor: DOUG B  
Pre-Cleaning: Light Cleaning  
Truck: 211MO  
Weather: Dry - No Precipitation During Survey  
Additional Info:

7895 St. Claire Ave, East St. Louis, IL 62207


## Observations

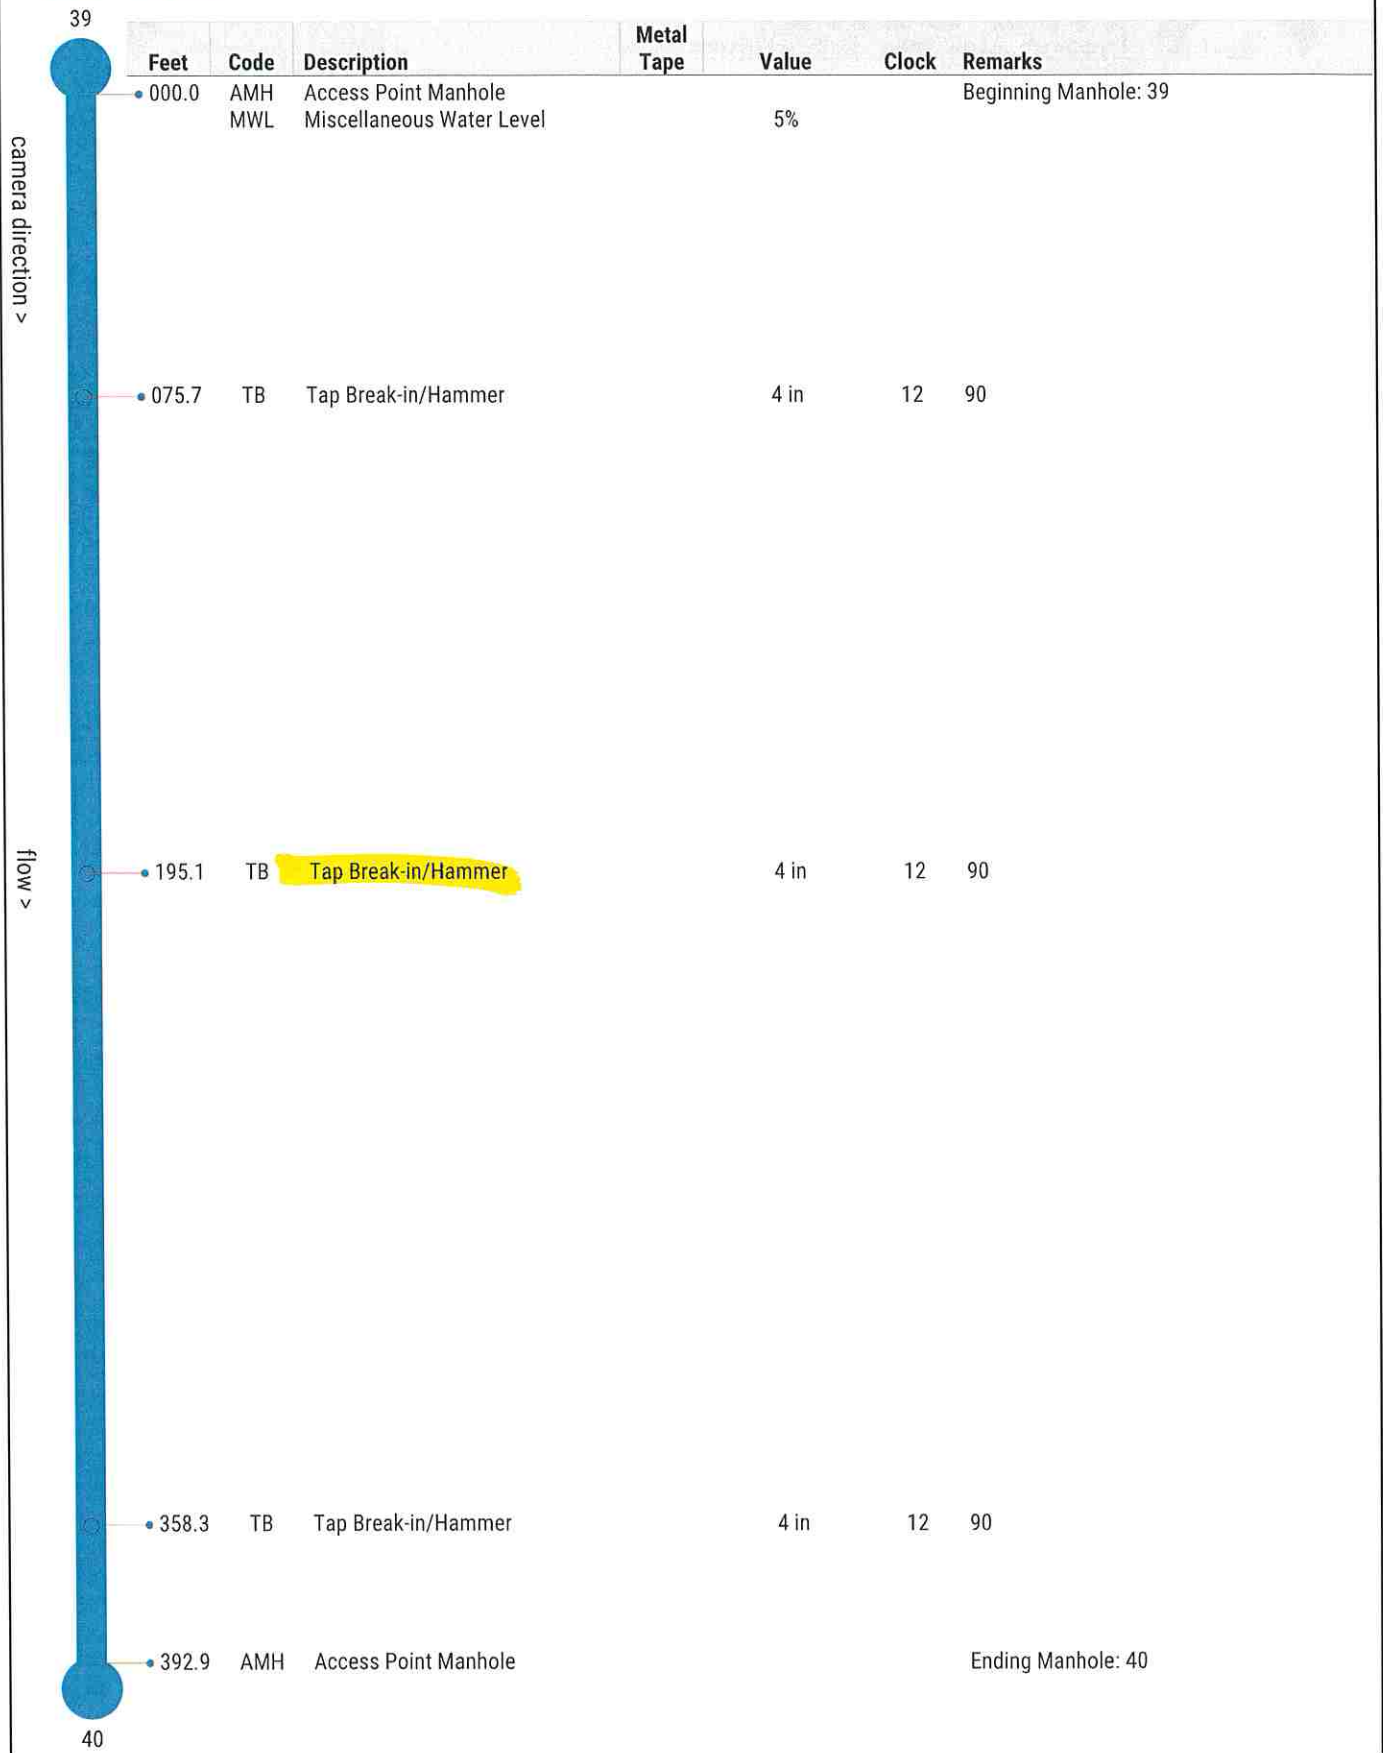



## Inspection Report

### Overview

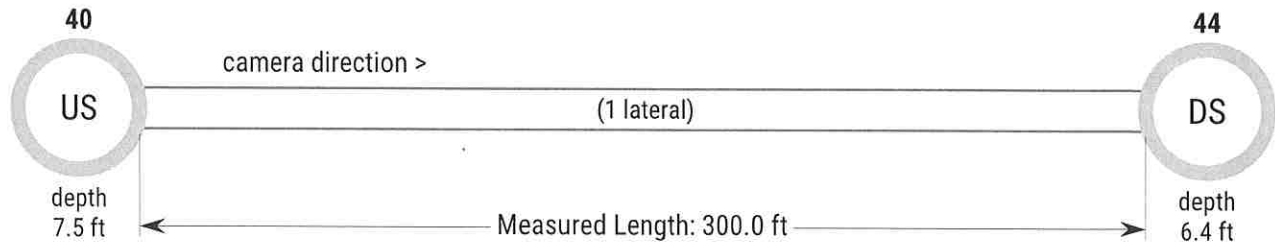

### Asset


Street: 11TH ST  
City: CASSVILLE MO  
Pipe Use: Sanitary Sewage Pipe  
Pipe Geometry: 8 in (Circular)  
Material: Vitrified Clay Pipe  
Map #/Plan File: 14  
Drainage Area:  
Flow Direction: →East  
Surface: Asphalt

### Inspection

Customer: ROSETTA CONSTRUCTION  
Project:  
Job #: 23010MO-11  
Media Date/Time: 2023/05/03 09:01  
Surveyed By: TYLER (P0038607-072022)  
Supervisor: DOUG B  
Pre-Cleaning: Light Cleaning  
Truck: 211MO  
Weather: Dry - No Precipitation During Survey  
Additional Info:


7895 St. Claire Ave, East St. Louis, IL 62207

## Observations

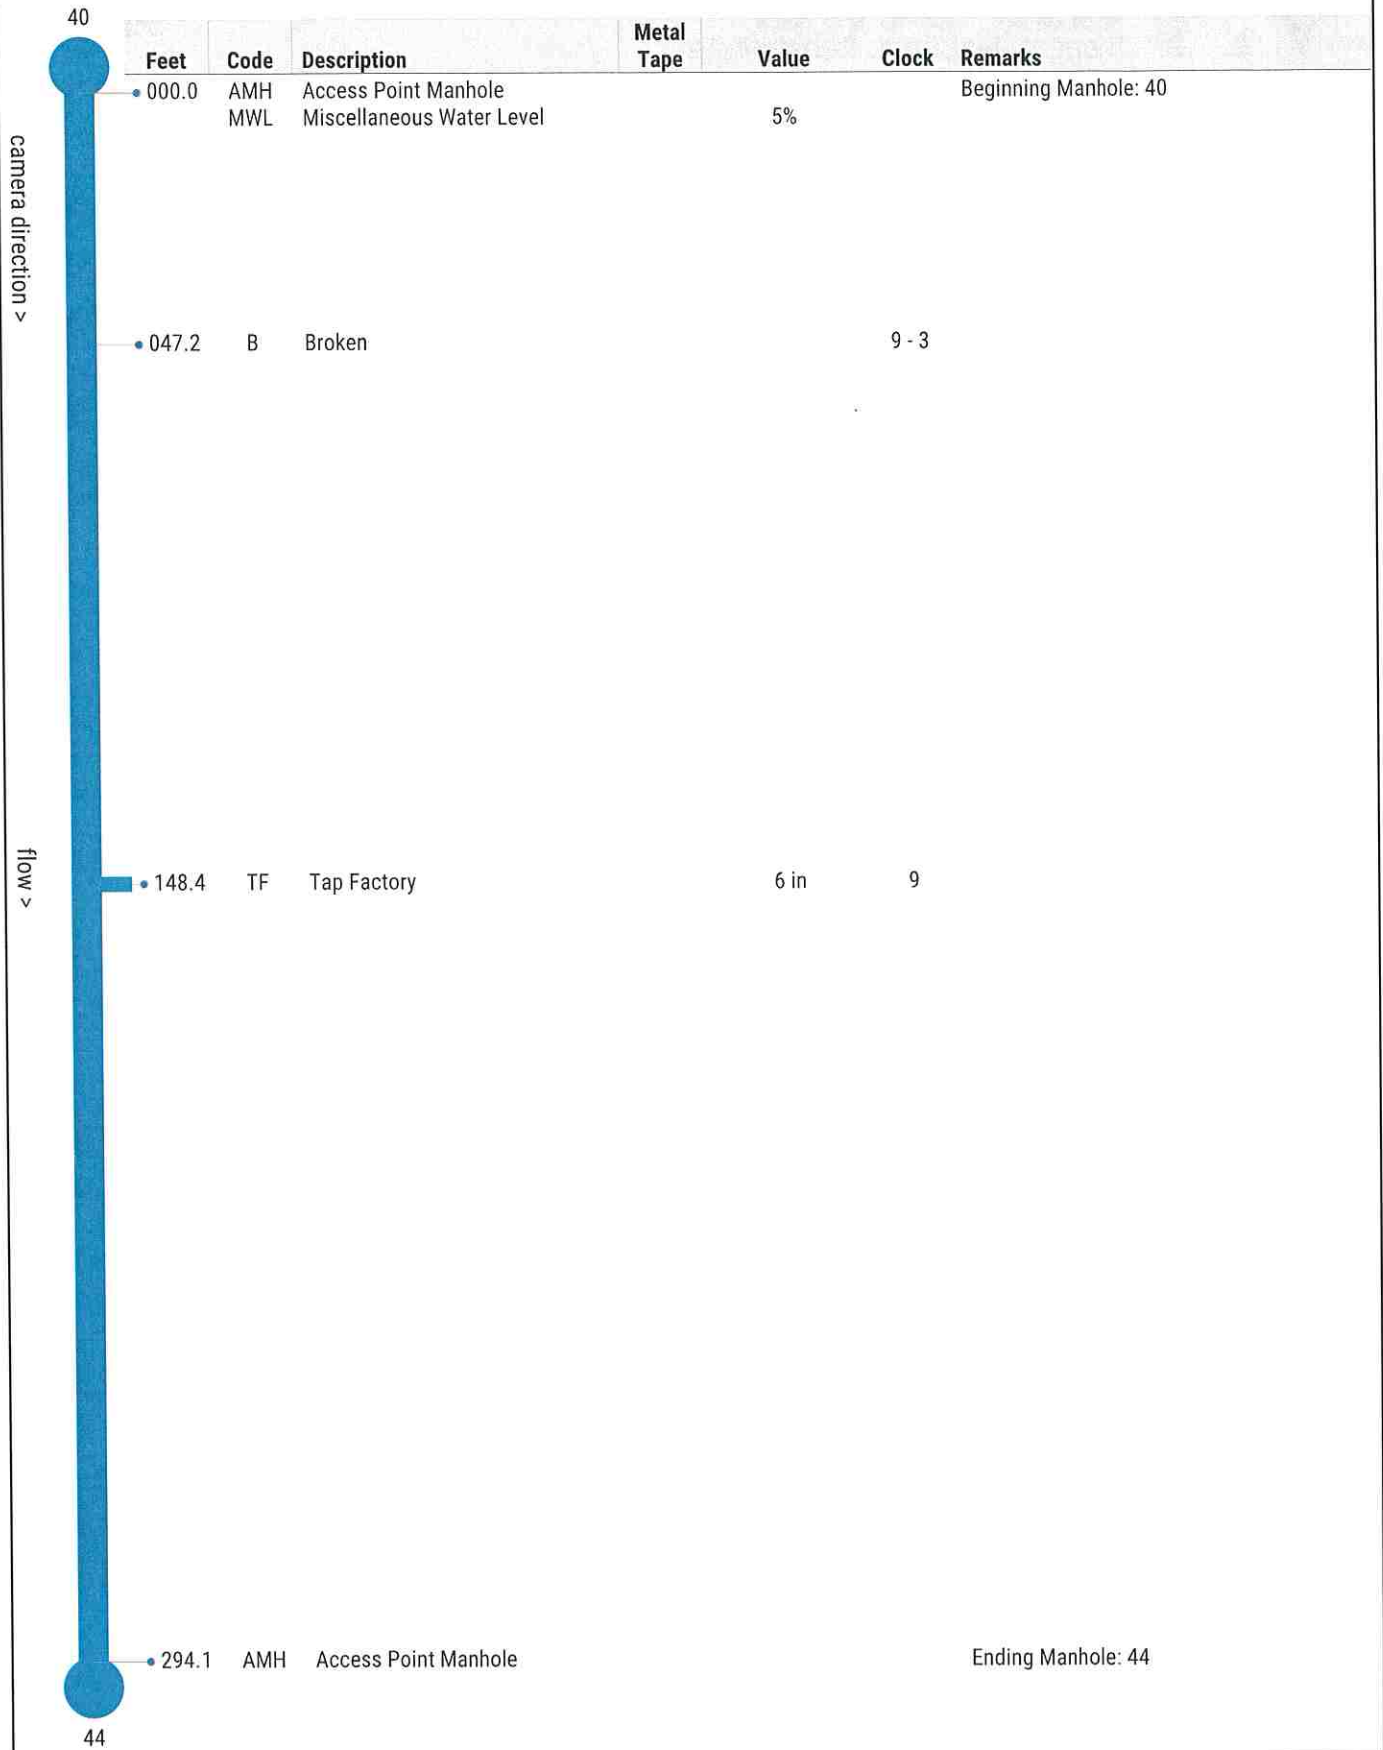

## Inspection Report

### Overview

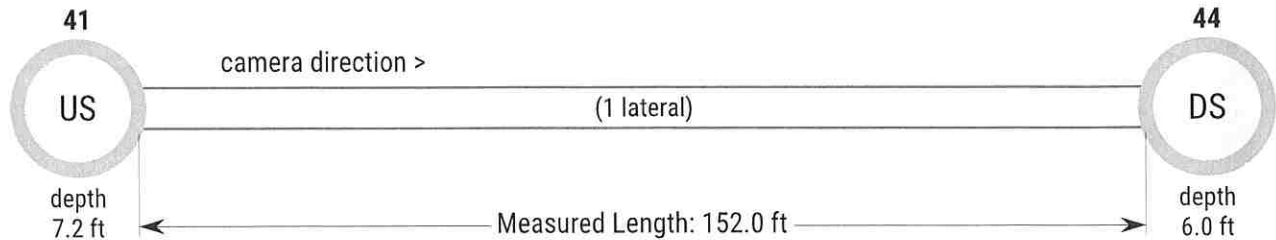

### Asset


Street: SAPP ST  
City: CASSVILLE MO  
Pipe Use: Sanitary Sewage Pipe  
Pipe Geometry: 8 in (Circular)  
Material: Vitrified Clay Pipe  
Map #/Plan File: 14  
Drainage Area:  
Flow Direction: ↓ South  
Surface: Asphalt

### Inspection

Customer: ROSETTA CONSTRUCTION  
Project:  
Job #: 23010MO-11  
Media Date/Time: 2023/04/12 11:39  
Surveyed By: TYLER (P0038607-072022)  
Supervisor: DOUG B  
Pre-Cleaning: Light Cleaning  
Truck: 211MO  
Weather: Dry - No Precipitation During Survey  
Additional Info:


7895 St. Claire Ave, East St. Louis, IL 62207

## Observations

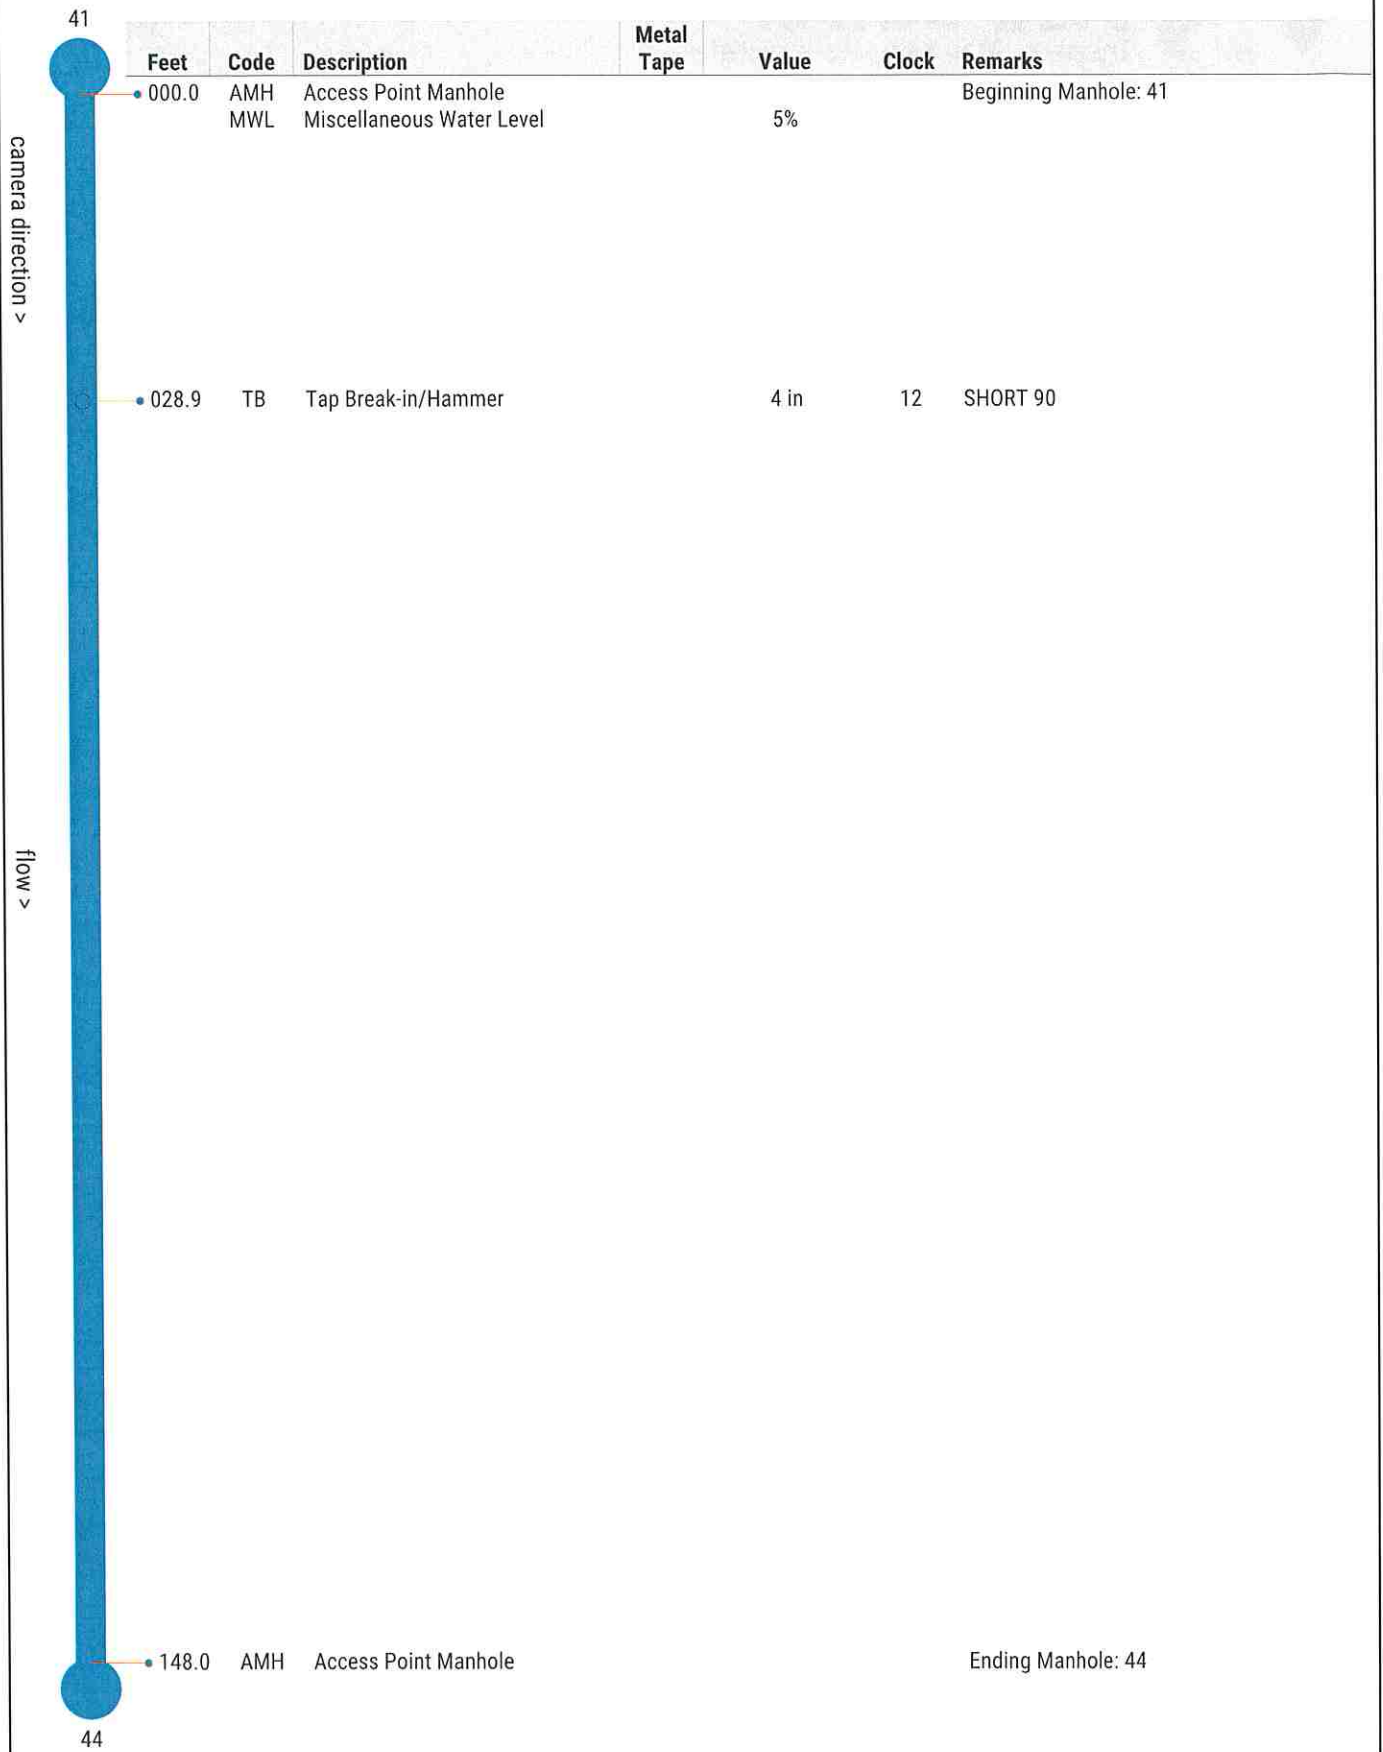

## Inspection Report

### Overview

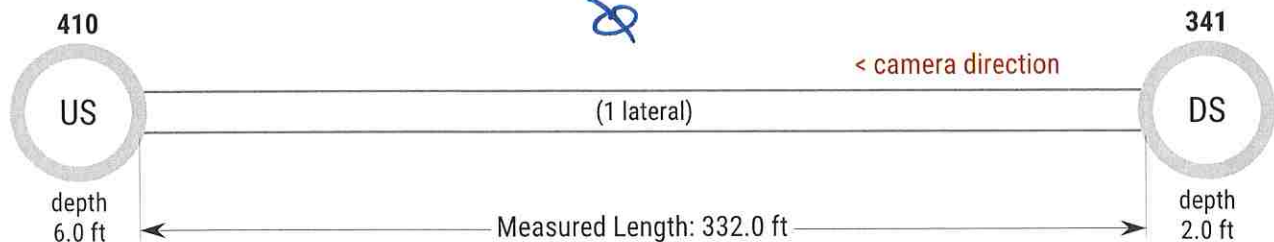

### Asset


Street: WILDWOOD DR  
City: CASSVILLE MO  
Pipe Use: Sanitary Sewage Pipe  
Pipe Geometry: 8 in (Circular)  
Material: Vitrified Clay Pipe  
Map #/Plan File: 16  
Drainage Area:  
Flow Direction: ←West  
Surface: Gravel

### Inspection

Customer: ROSETTA CONSTRUCTION  
Project:  
Job #: 23010MO-11  
Media Date/Time: 2023/05/01 02:10  
Surveyed By: TYLER (P0038607-072022)  
Supervisor: DOUG B  
Pre-Cleaning: Light Cleaning  
Truck: 211MO  
Weather: Dry - No Precipitation During Survey  
Additional Info:

7895 St. Claire Ave, East St. Louis, IL 62207

## Observations

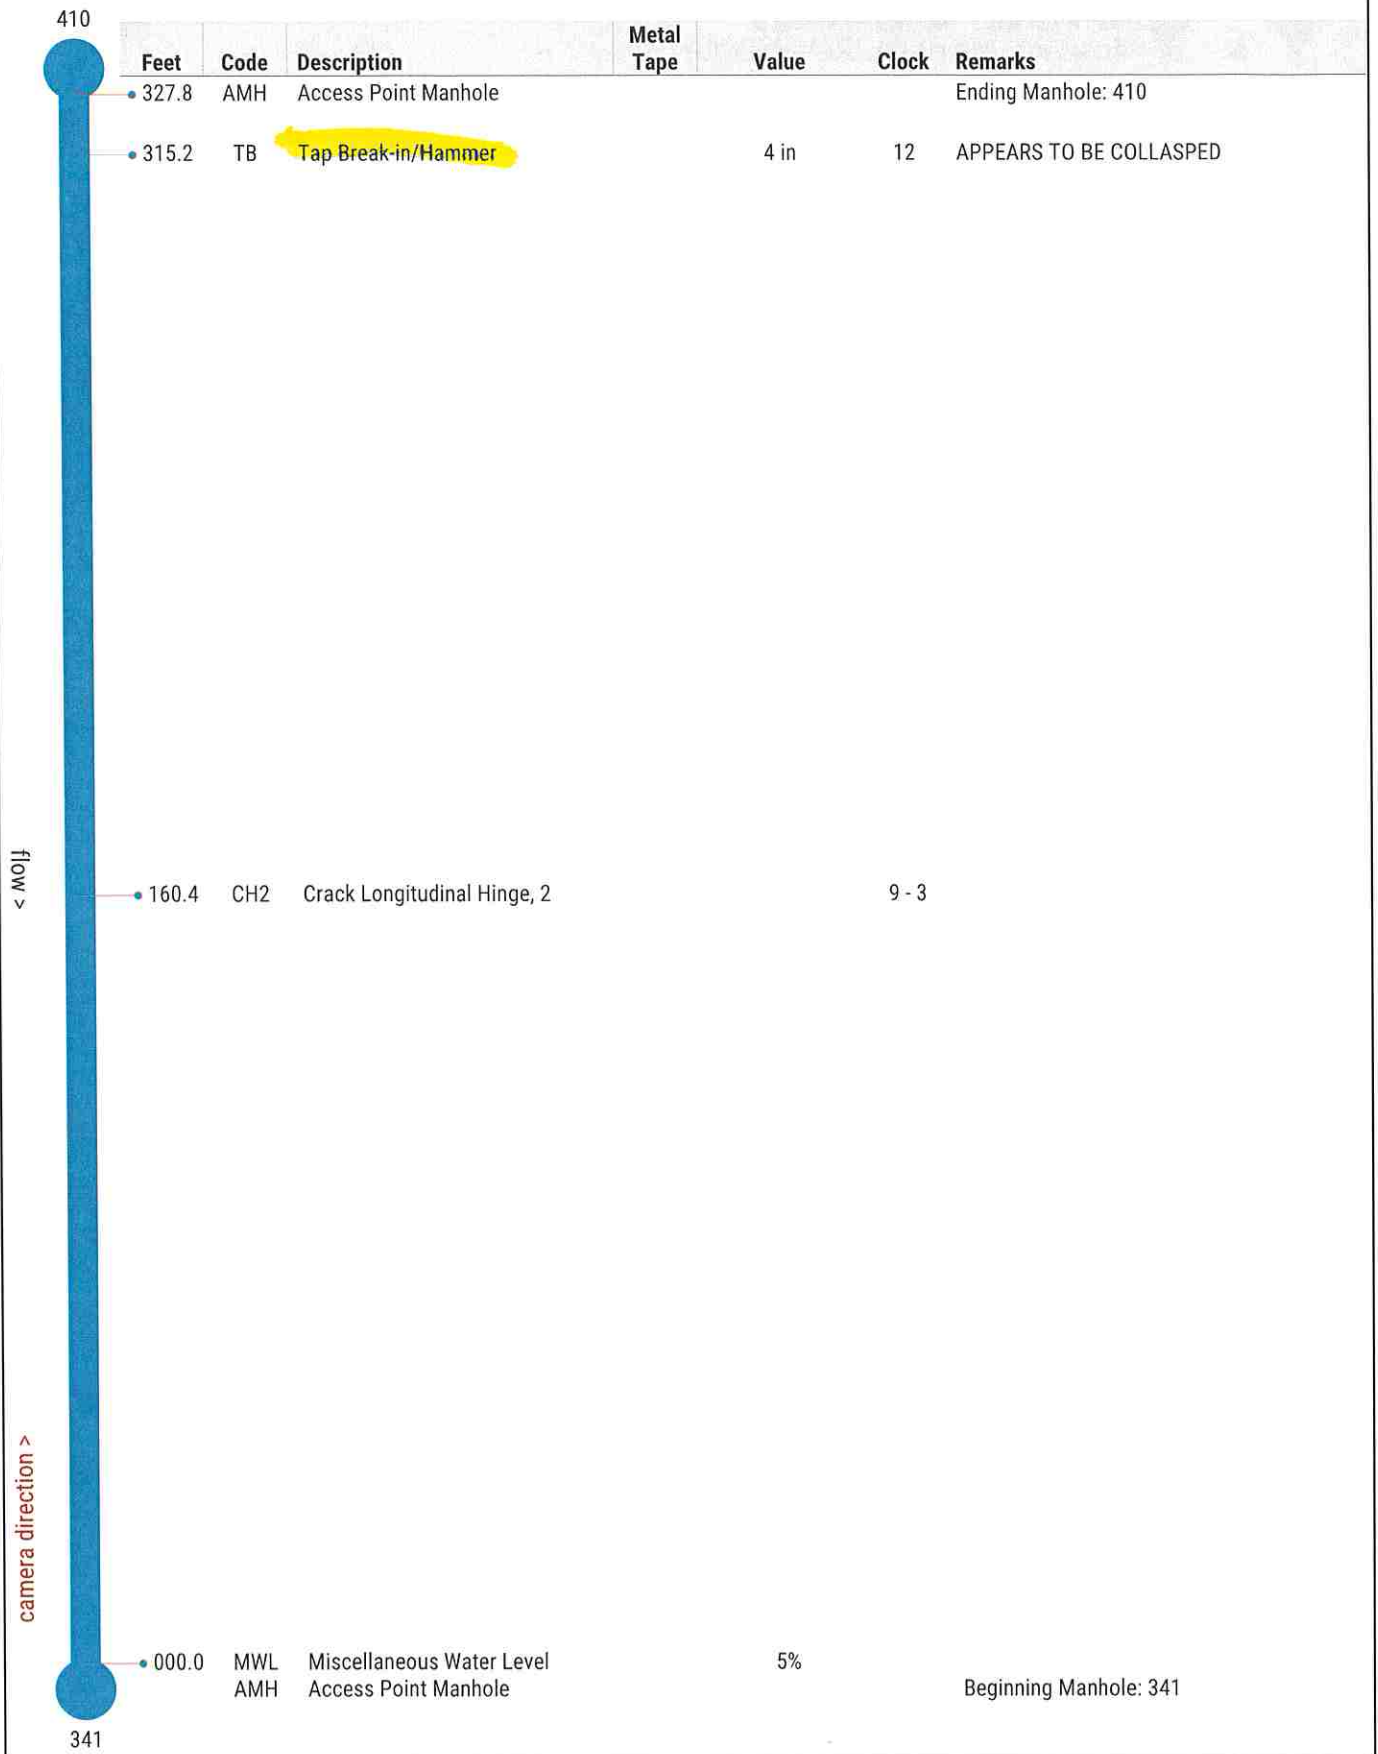






## Inspection Report

### Overview

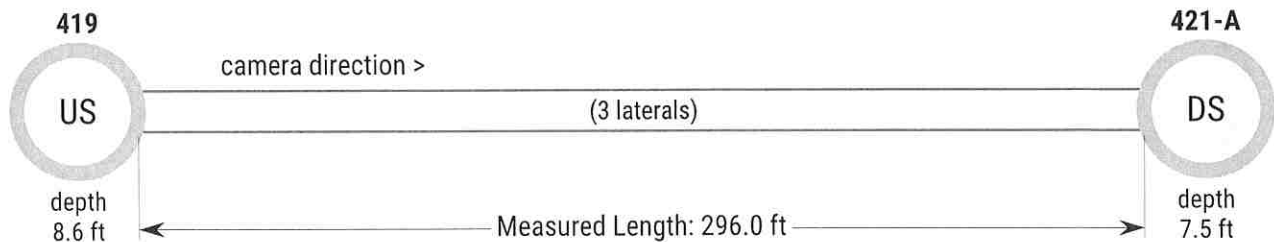

### Asset


Street: COUNTY FARM ROAD  
City: CASSVILLE MO  
Pipe Use: Sanitary Sewage Pipe  
Pipe Geometry: 8 in (Circular)  
Material: Vitrified Clay Pipe  
Map #/Plan File: 14  
Drainage Area:  
Flow Direction: ↓ South  
Surface: Asphalt

### Inspection

Customer: ROSETTA CONSTRUCTION  
Project:  
Job #: 23010MO-11  
Media Date/Time: 2023/04/11 10:22  
Surveyed By: TYLER (P0038607-072022)  
Supervisor: DOUG B  
Pre-Cleaning: Light Cleaning  
Truck: 211MO  
Weather: Dry - No Precipitation During Survey  
Additional Info:


7895 St. Claire Ave, East St. Louis, IL 62207

## Observations

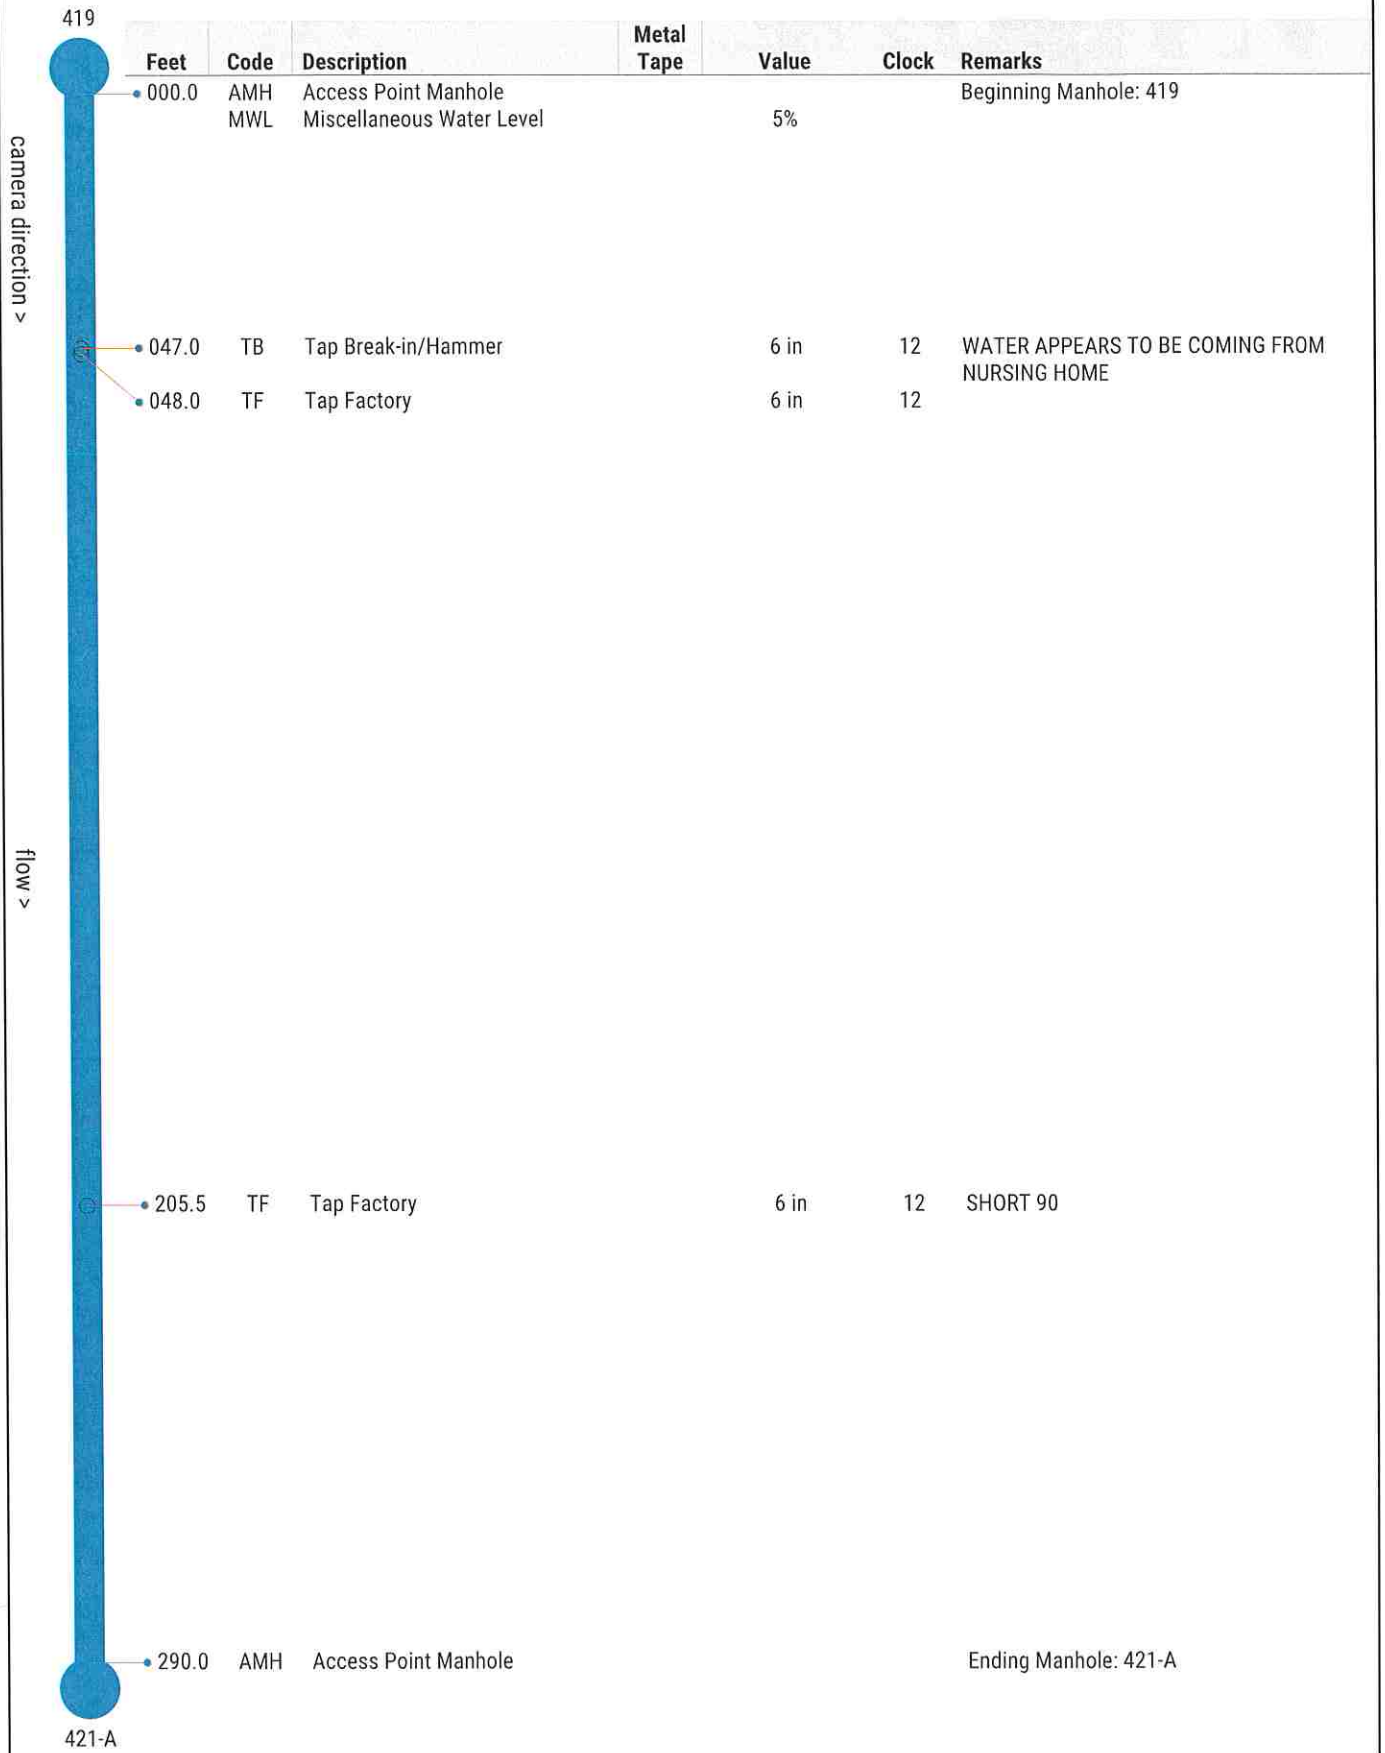

## Inspection Report

### Overview

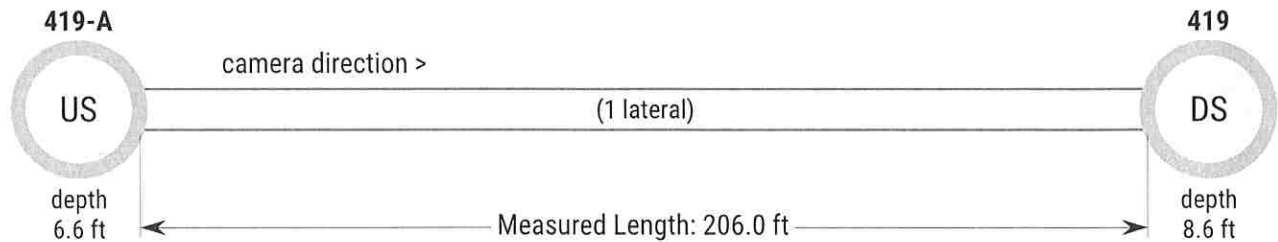

### Asset


Street: COUNTY FARM ROAD  
City: CASSVILLE MO  
Pipe Use: Sanitary Sewage Pipe  
Pipe Geometry: 8 in (Circular)  
Material: Vitrified Clay Pipe  
Map #/Plan File: 14  
Drainage Area:  
Flow Direction: ↓ South  
Surface: Asphalt

### Inspection

Customer: ROSETTA CONSTRUCTION  
Project:  
Job #: 23010MO-11  
Media Date/Time: 2023/04/11 10:07  
Surveyed By: TYLER (P0038607-072022)  
Supervisor: DOUG B  
Pre-Cleaning: Light Cleaning  
Truck: 211MO  
Weather: Dry - No Precipitation During Survey  
Additional Info:


7895 St. Claire Ave, East St. Louis, IL 62207

## Observations

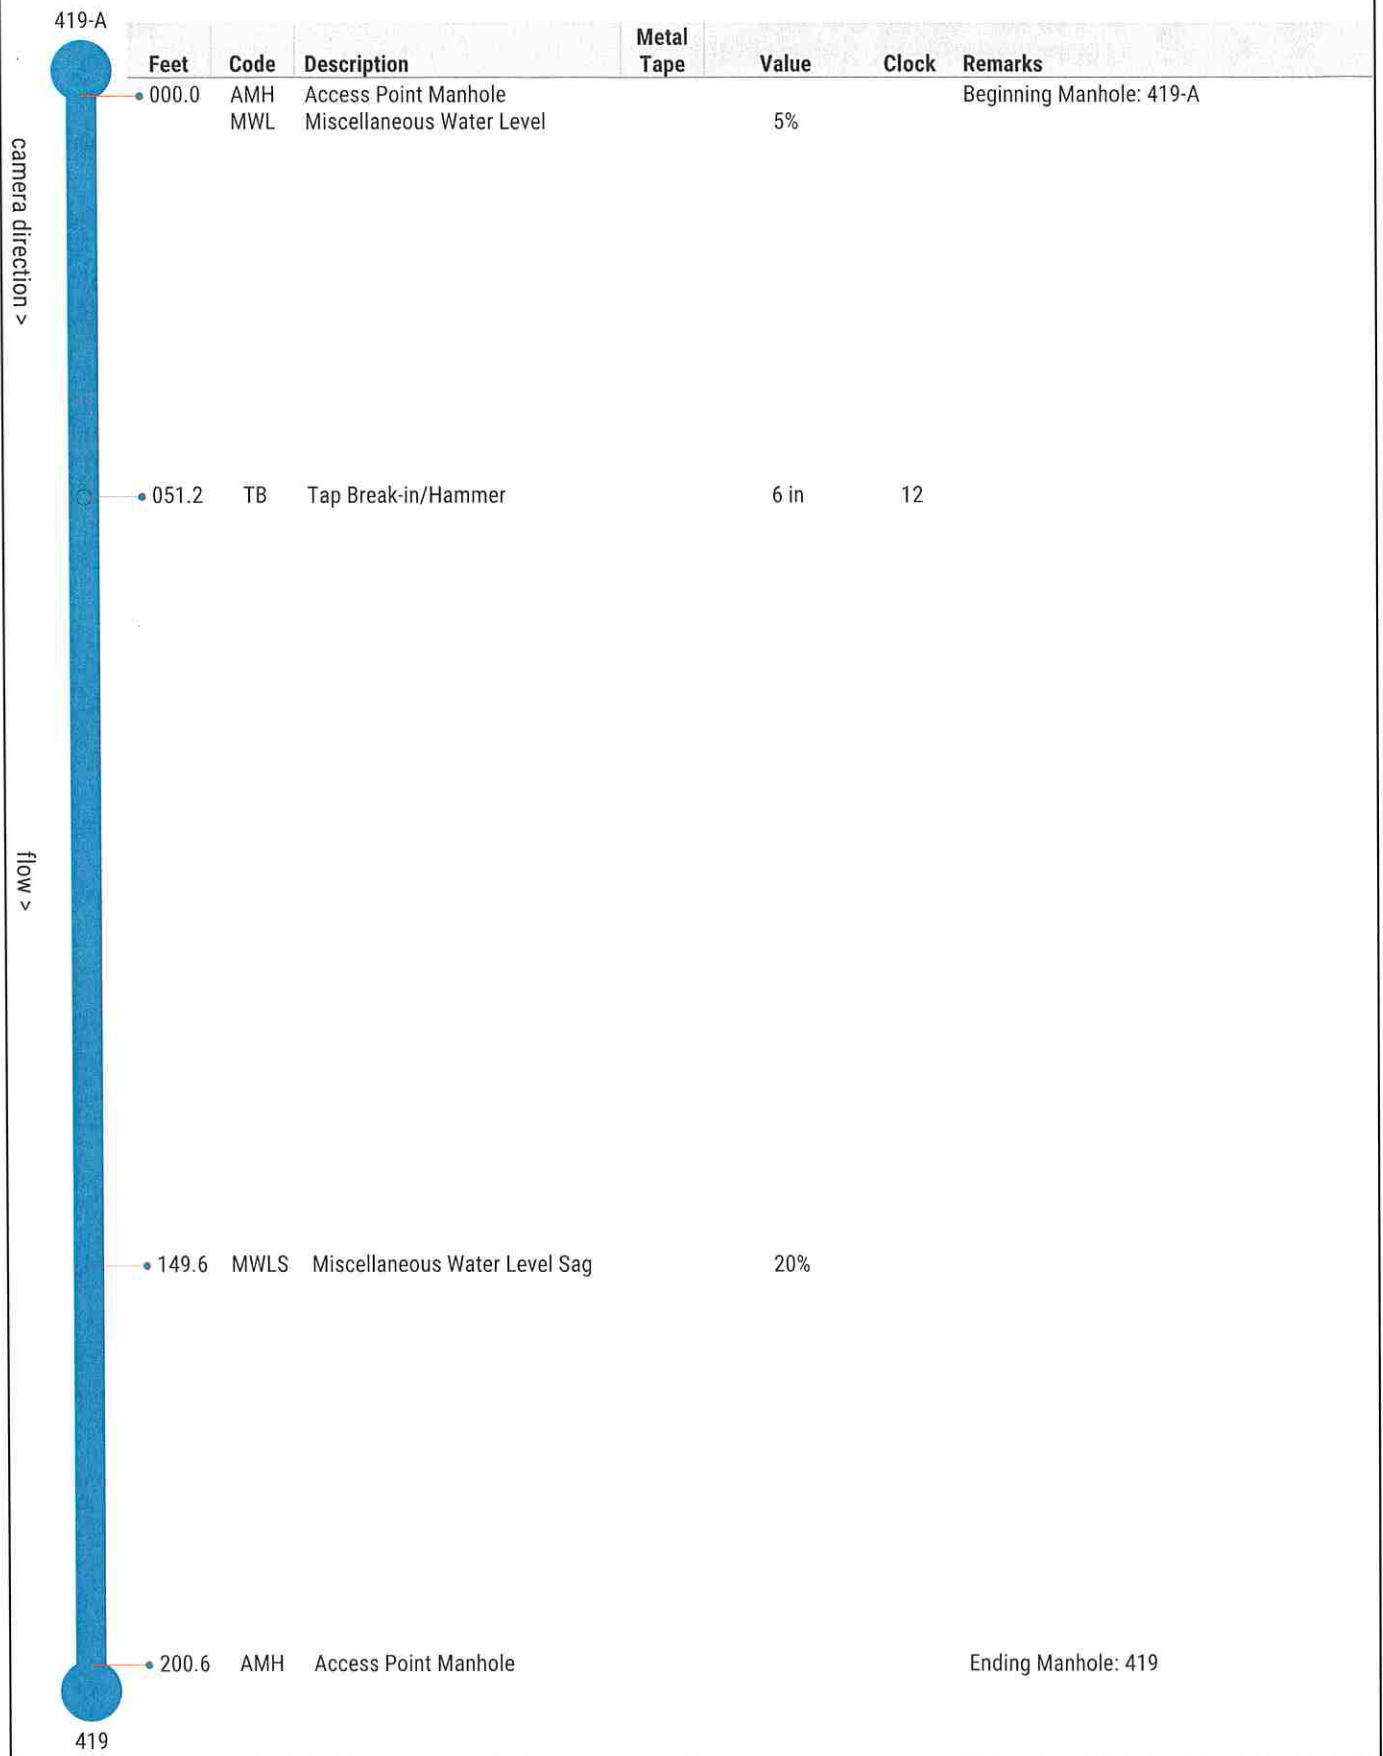

## Inspection Report

### Overview

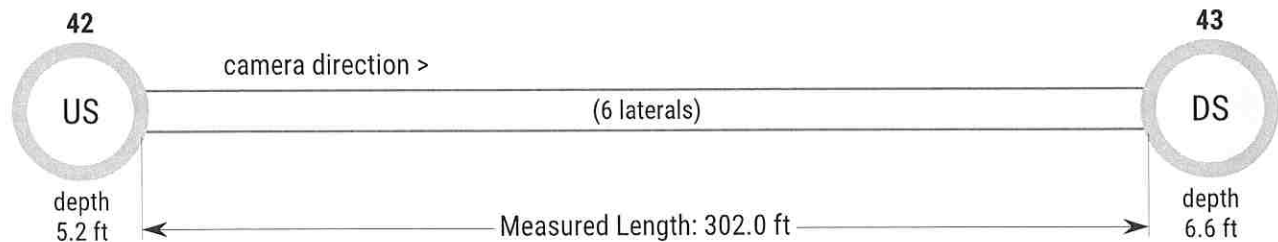

### Asset


Street: SAPP ST  
City: CASSVILLE MO  
Pipe Use: Sanitary Sewage Pipe  
Pipe Geometry: 8 in (Circular)  
Material: Vitrified Clay Pipe  
Map #/Plan File: 14  
Drainage Area:  
Flow Direction: ↓ South  
Surface: Asphalt

### Inspection

Customer: ROSETTA CONSTRUCTION  
Project:  
Job #: 23010MO-11  
Media Date/Time: 2023/04/12 09:14  
Surveyed By: TYLER (P0038607-072022)  
Supervisor: DOUG B  
Pre-Cleaning: Heavy Cleaning  
Truck: 211MO  
Weather: Dry - No Precipitation During Survey  
Additional Info: RAN ROOT SAW

7895 St. Claire Ave, East St. Louis, IL 62207


## Observations

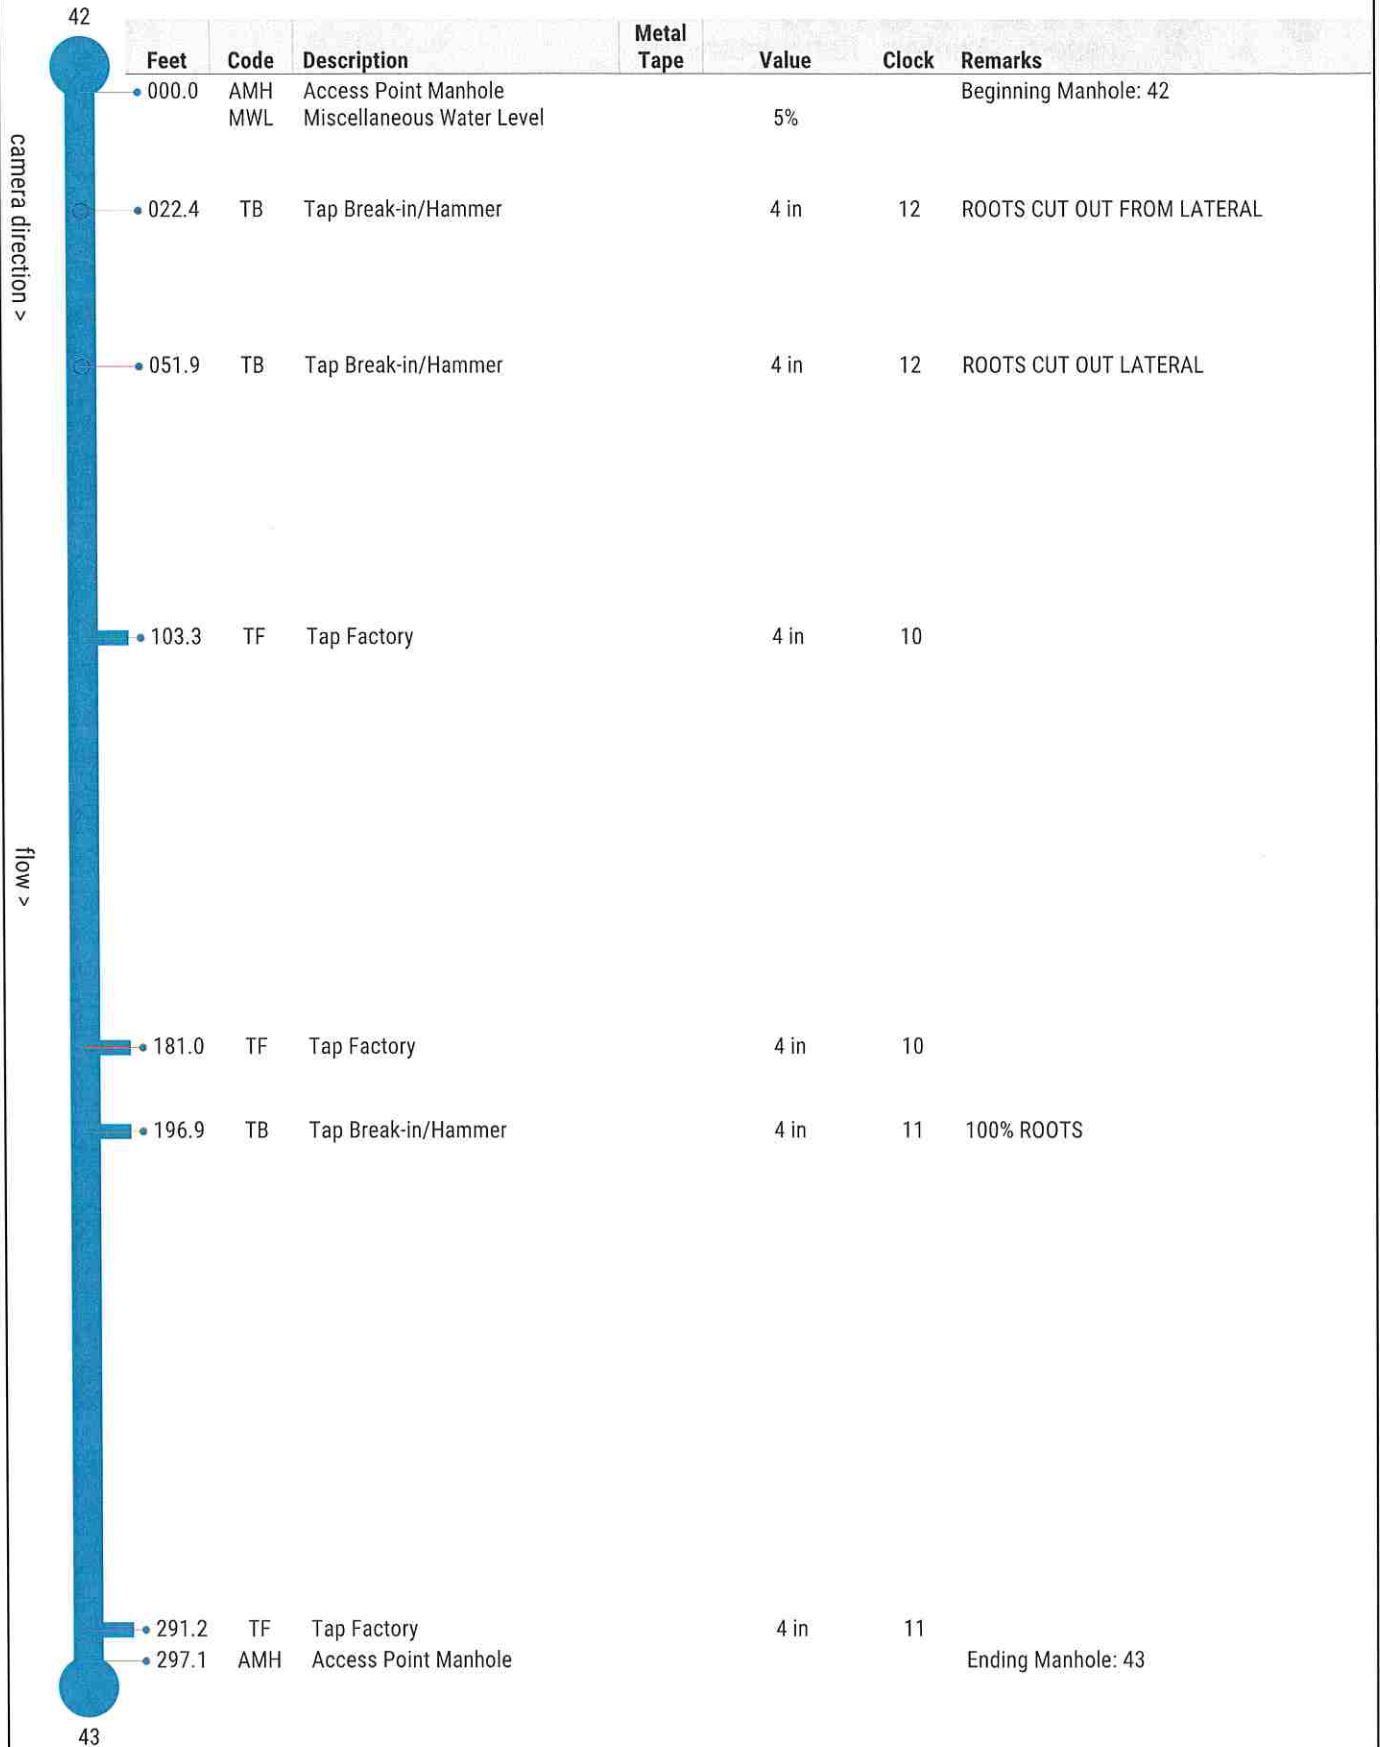



## Inspection Report

### Overview

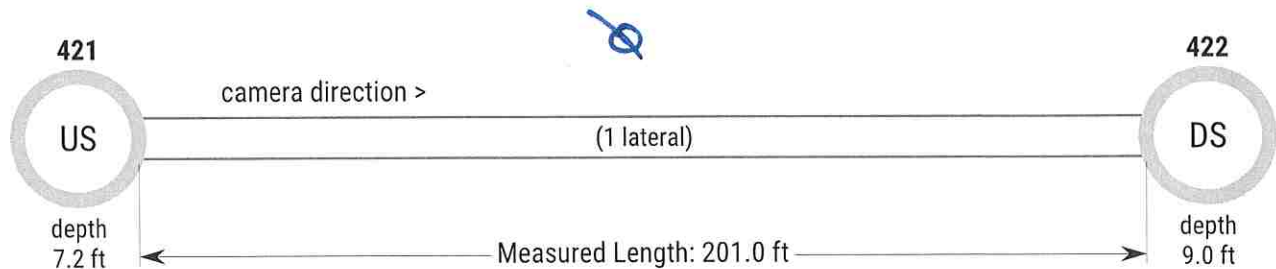

### Asset


Street: COUNTY FARM RD  
City: CASSVILLE MO  
Pipe Use: Sanitary Sewage Pipe  
Pipe Geometry: 8 in (Circular)  
Material: Vitrified Clay Pipe  
Map #/Plan File: 14  
Drainage Area:  
Flow Direction: ↓ South  
Surface: Asphalt

### Inspection

Customer: ROSETTA CONSTRUCTION  
Project:  
Job #: 23010MO-11  
Media Date/Time: 2023/04/19 08:51  
Surveyed By: TYLER (P0038607-072022)  
Supervisor: DOUG B  
Pre-Cleaning: Light Cleaning  
Truck: 211MO  
Weather: Dry - No Precipitation During Survey  
Additional Info:


7895 St. Claire Ave, East St. Louis, IL 62207

Observations

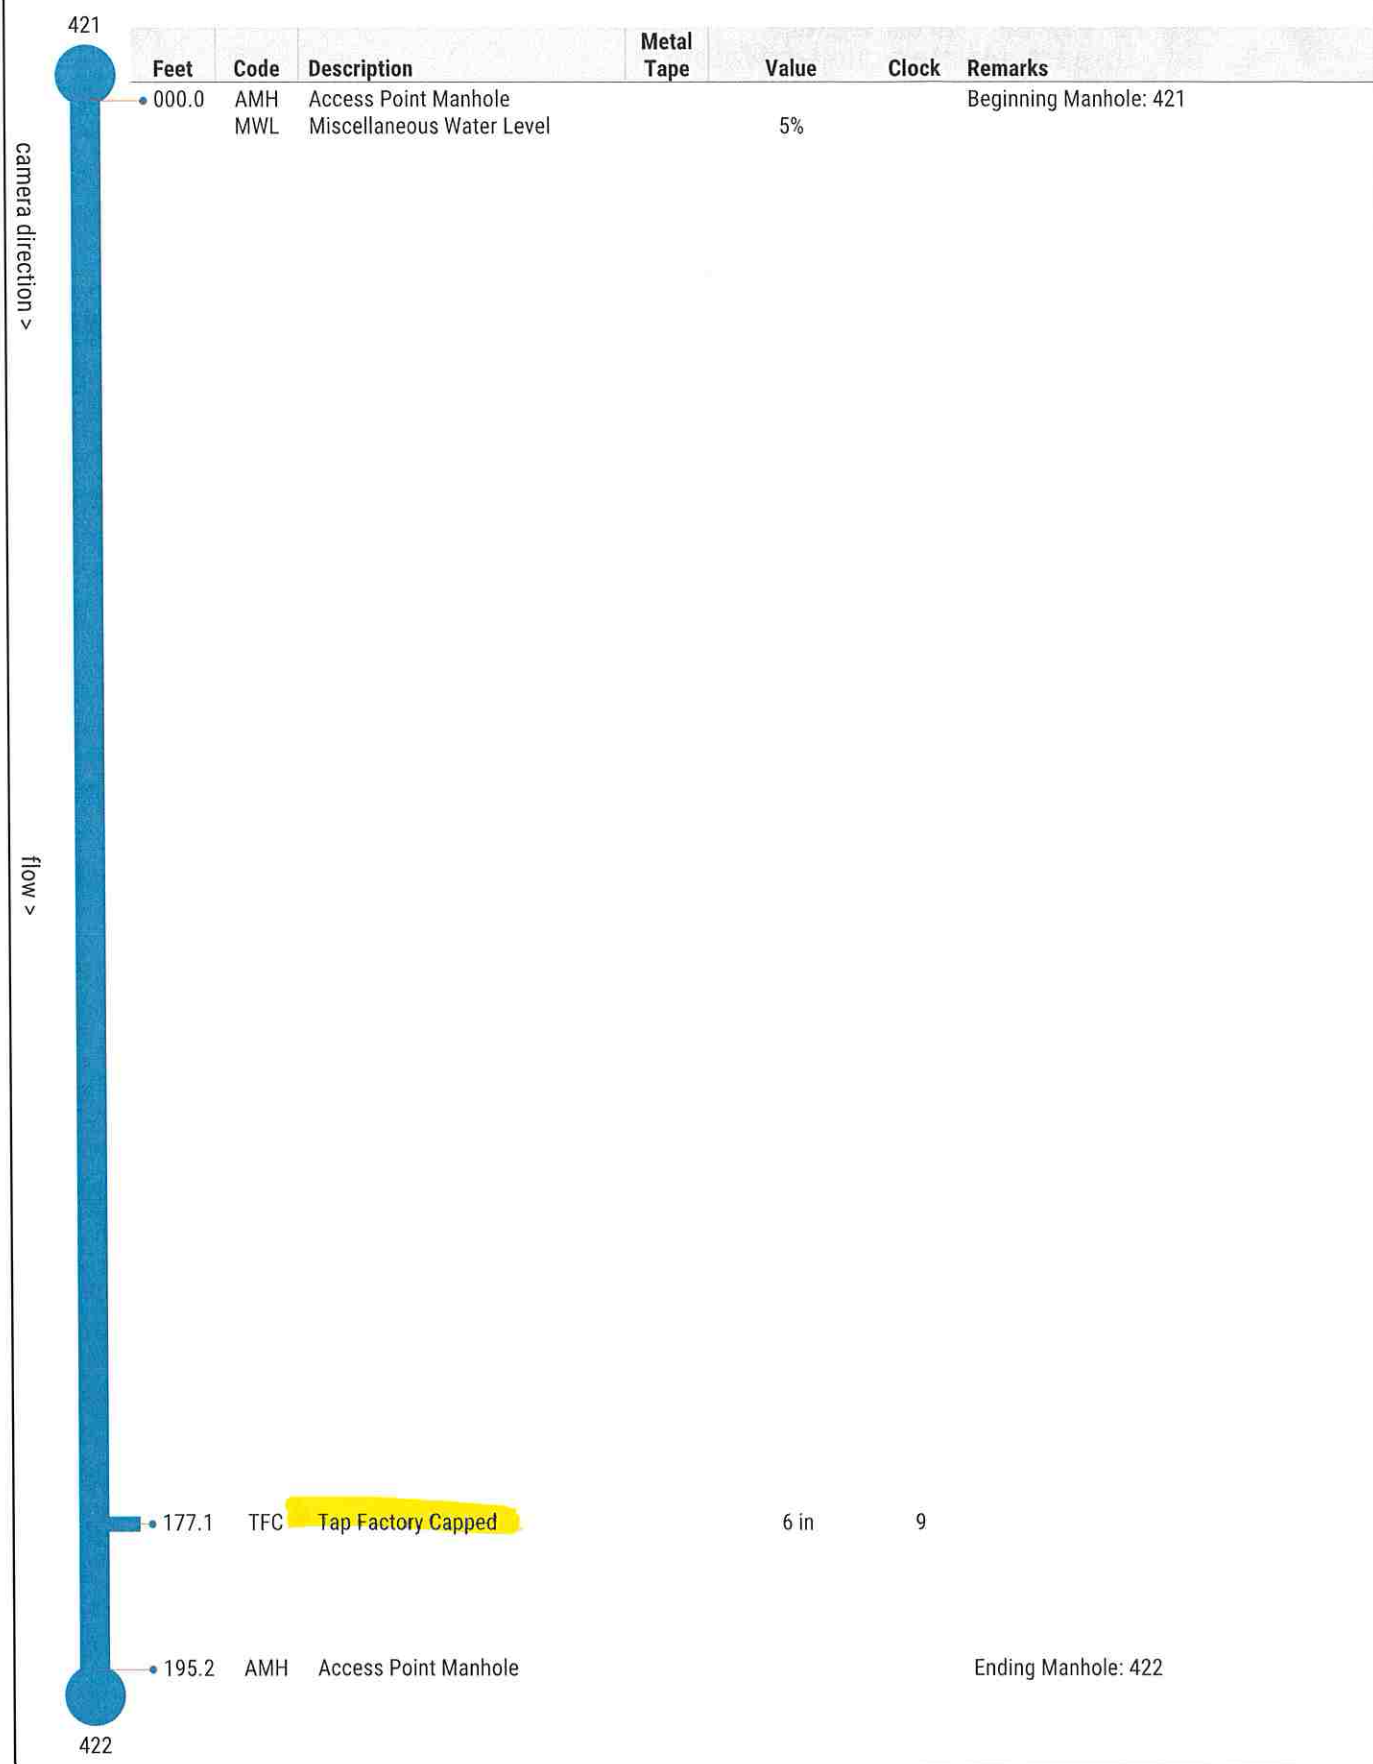

## Inspection Report

### Overview

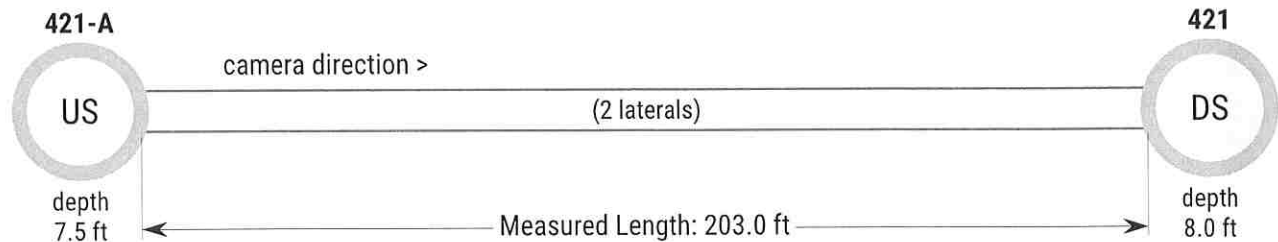

### Asset


Street: COUNTY FARM ROAD  
City: CASSVILLE MO  
Pipe Use: Sanitary Sewage Pipe  
Pipe Geometry: 8 in (Circular)  
Material: Vitrified Clay Pipe  
Map #/Plan File: 14  
Drainage Area:  
Flow Direction: ↓ South  
Surface: Asphalt

### Inspection

Customer: ROSETTA CONSTRUCTION  
Project:  
Job #: 23010MO-11  
Media Date/Time: 2023/04/11 10:53  
Surveyed By: TYLER (P0038607-072022)  
Supervisor: DOUG B  
Pre-Cleaning: Light Cleaning  
Truck: 211MO  
Weather: Dry - No Precipitation During Survey  
Additional Info:


7895 St. Claire Ave, East St. Louis, IL 62207

## Observations

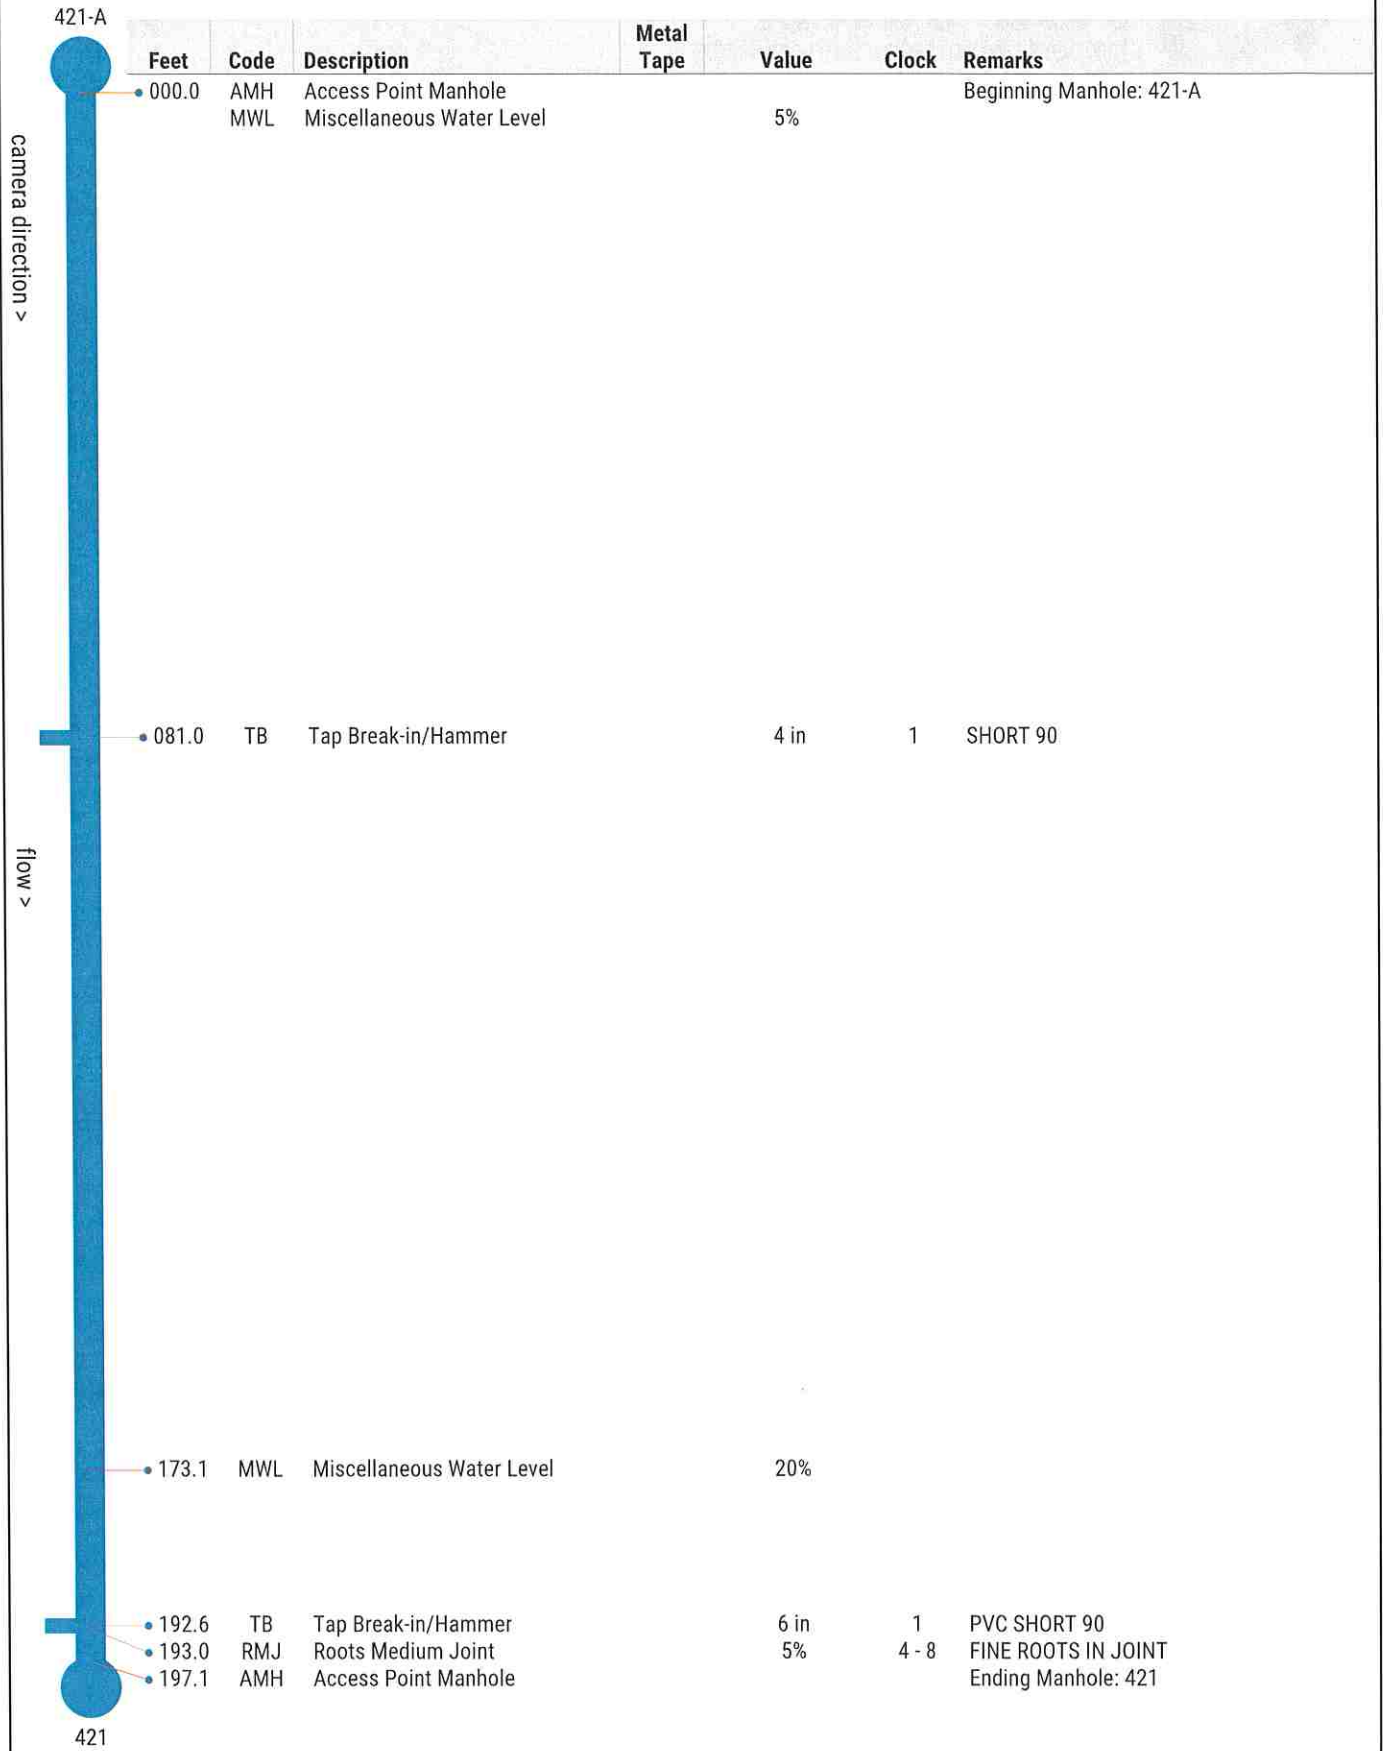

## Inspection Report

### Overview

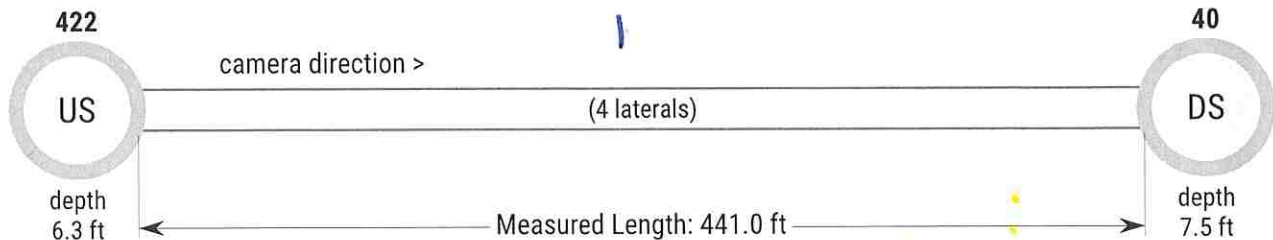

### Asset


Street: 11TH ST  
City: CASSVILLE MO  
Pipe Use: Sanitary Sewage Pipe  
Pipe Geometry: 8 in (Circular)  
Material: Vitrified Clay Pipe  
Map #/Plan File: 14  
Drainage Area:  
Flow Direction: →East  
Surface: Asphalt

### Inspection

Customer: ROSETTA CONSTRUCTION  
Project:  
Job #: 23010MO-11  
Media Date/Time: 2023/05/03 07:45  
Surveyed By: TYLER (P0038607-072022)  
Supervisor: DOUG B  
Pre-Cleaning: Heavy Cleaning  
Truck: 211MO  
Weather: Dry - No Precipitation During Survey  
Additional Info: MADE 5 CLEANING PASSES AND VACTOR ALOT OF DEBRIS

7895 St. Claire Ave, East St. Louis, IL 62207


## Observations

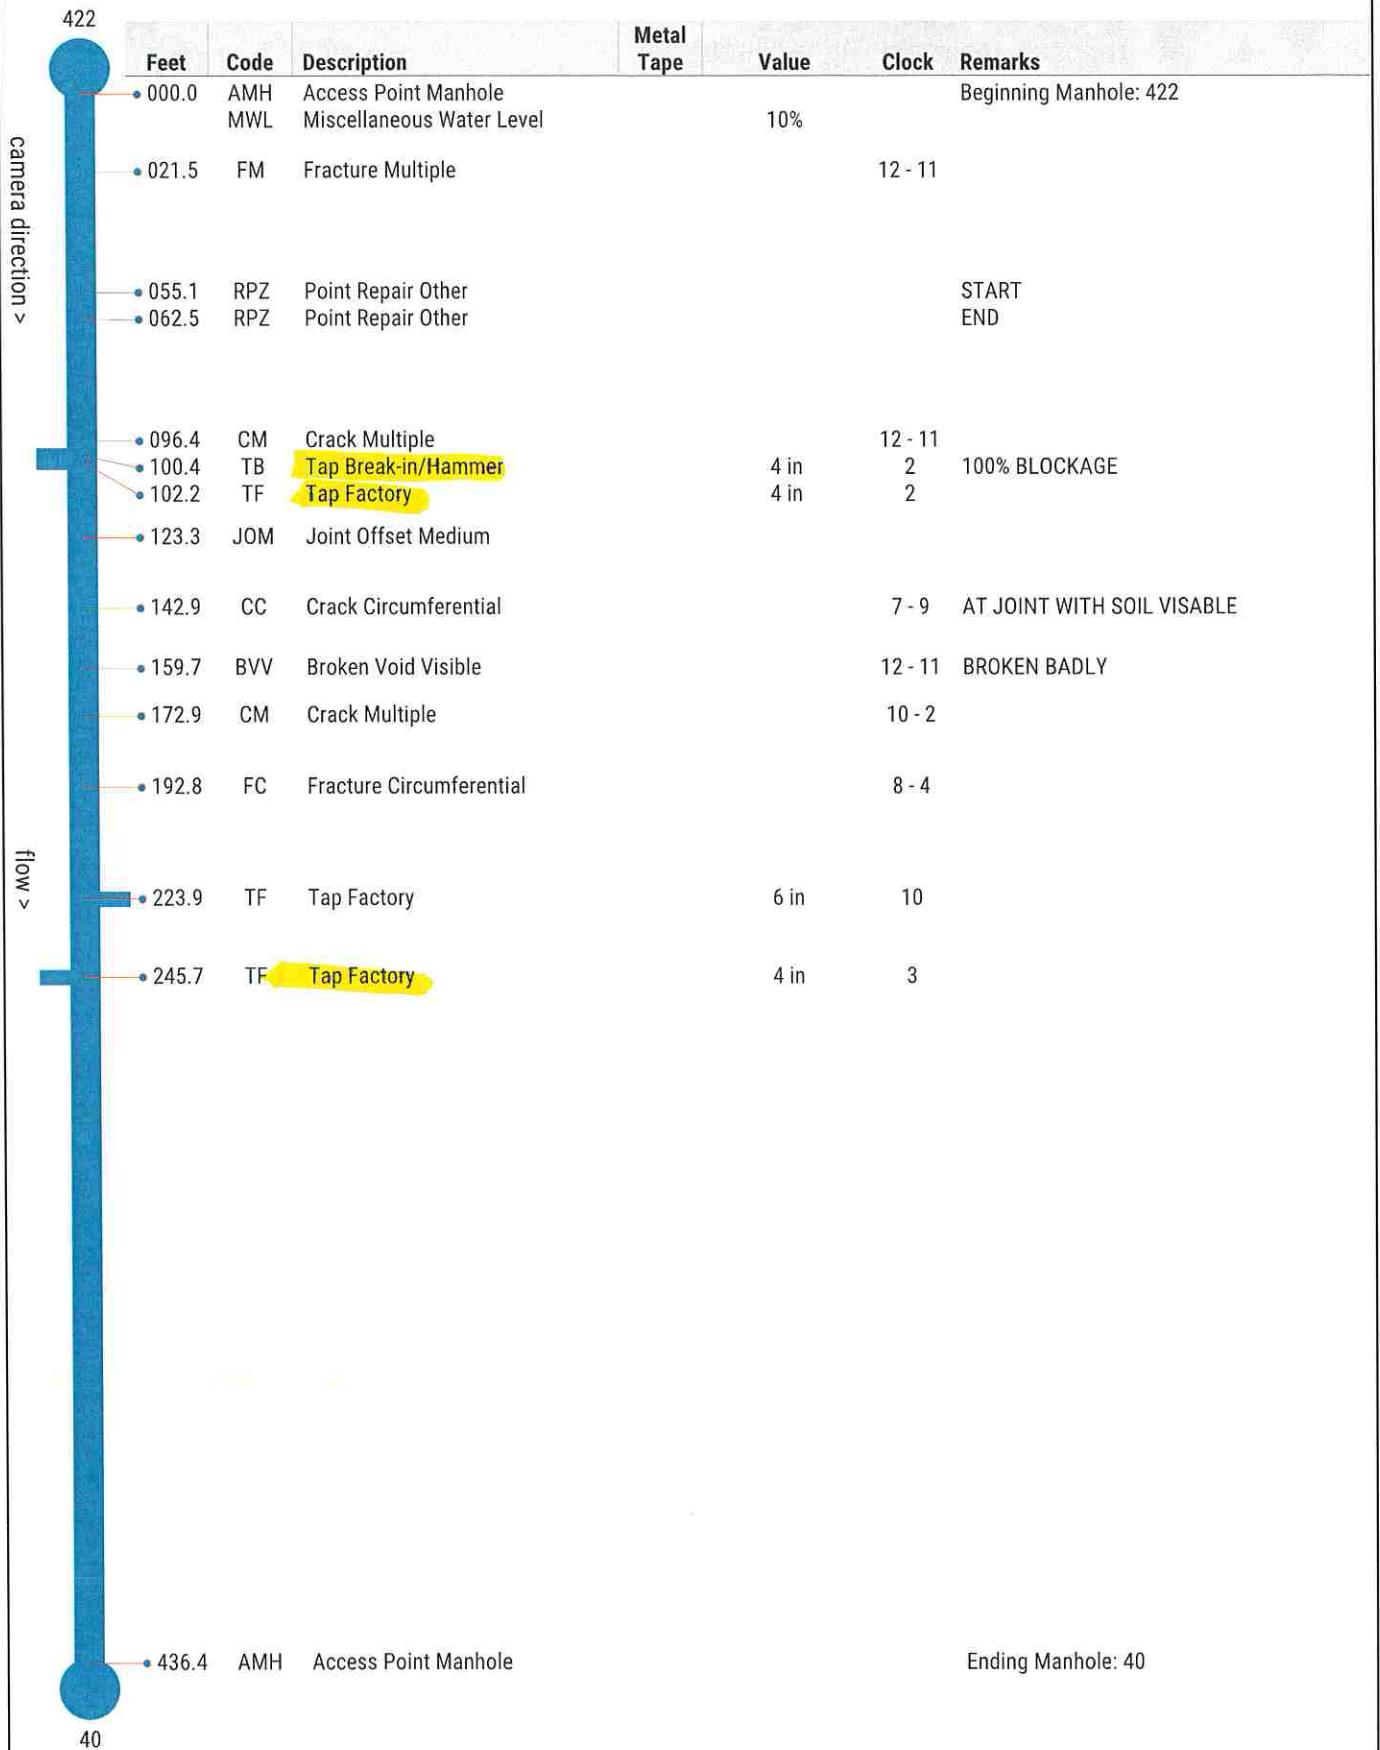



## Inspection Report

### Overview

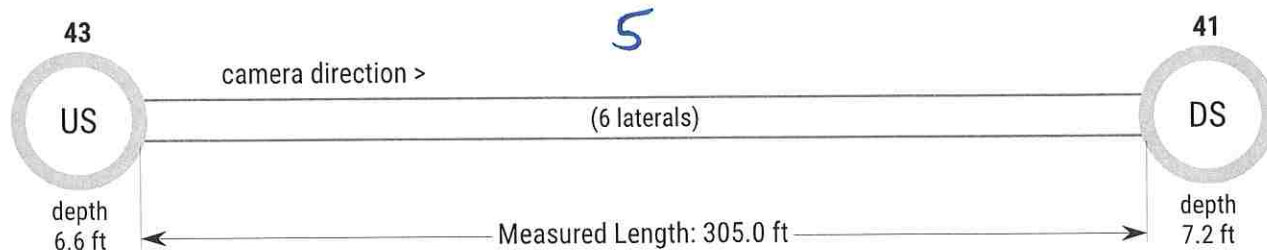

### Asset


Street: SAPP ST  
City: CASSVILLE MO  
Pipe Use: Sanitary Sewage Pipe  
Pipe Geometry: 8 in (Circular)  
Material: Vitrified Clay Pipe  
Map #/Plan File: 14  
Drainage Area:  
Flow Direction: ↓ South  
Surface: Asphalt

### Inspection

Customer: ROSETTA CONSTRUCTION  
Project:  
Job #: 23010MO-11  
Media Date/Time: 2023/04/12 11:22  
Surveyed By: TYLER (P0038607-072022)  
Supervisor: DOUG B  
Pre-Cleaning: Light Cleaning  
Truck: 211MO  
Weather: Dry - No Precipitation During Survey  
Additional Info:


7895 St. Claire Ave, East St. Louis, IL 62207

## Observations

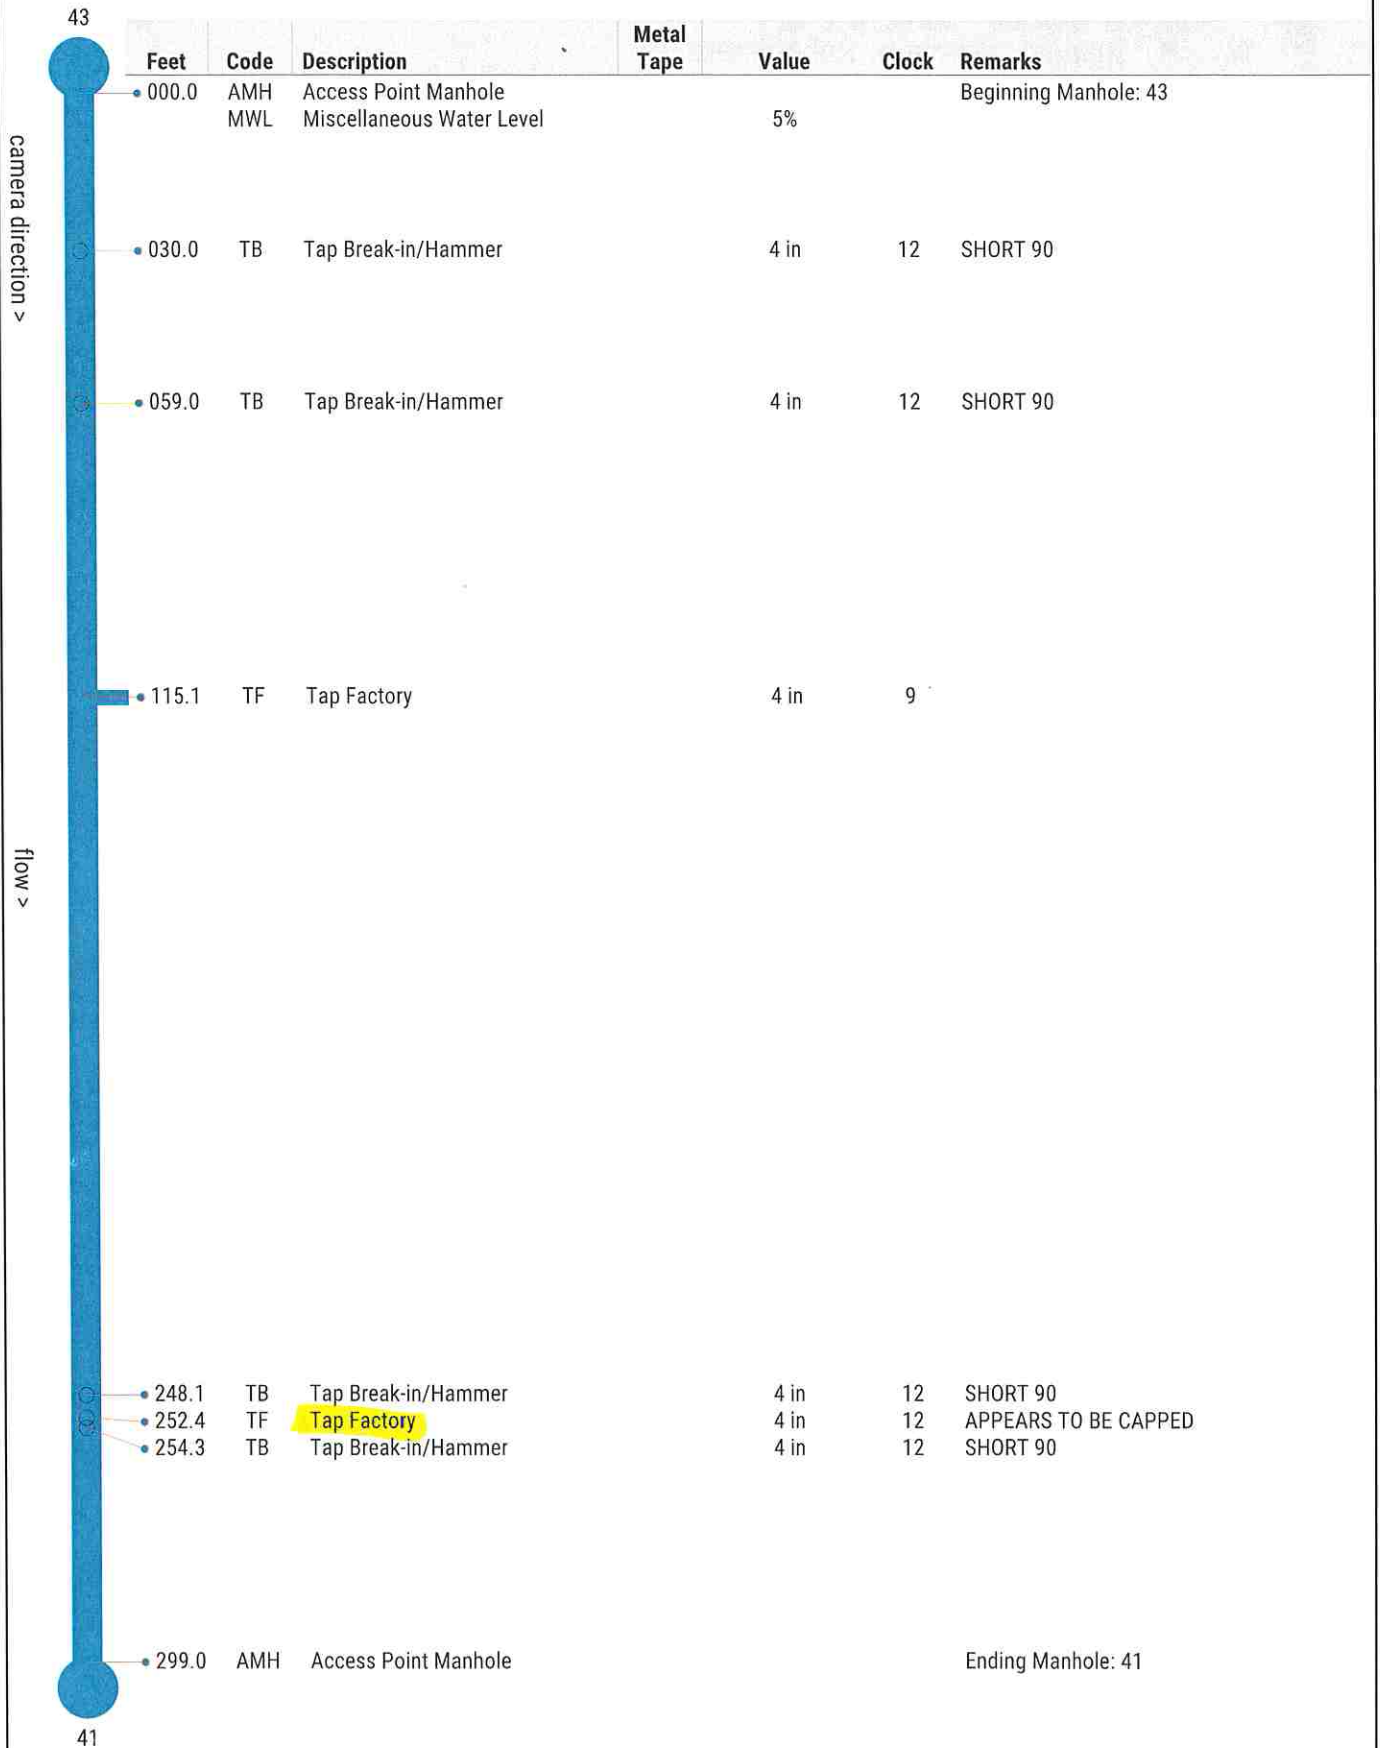

## Inspection Report

### Overview

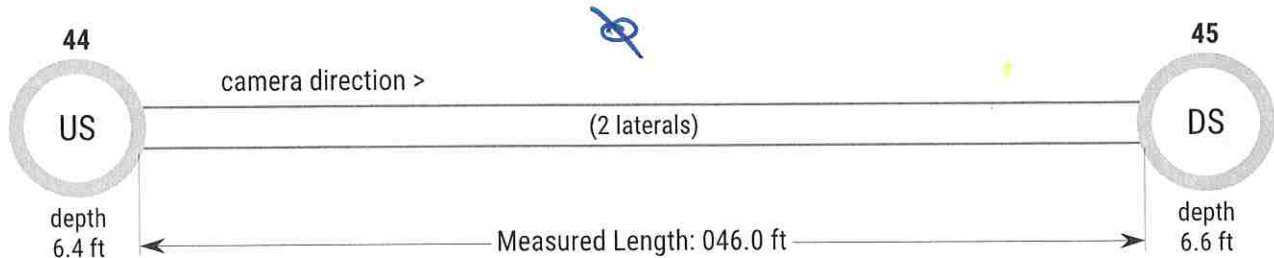

### Asset


Street: 11TH ST  
City: CASSVILLE MO  
Pipe Use: Sanitary Sewage Pipe  
Pipe Geometry: 8 in (Circular)  
Material: Vitrified Clay Pipe  
Map #/Plan File: 14  
Drainage Area:  
Flow Direction: →East  
Surface: Asphalt

### Inspection

Customer: ROSETTA CONSTRUCTION  
Project:  
Job #: 23010MO-11  
Media Date/Time: 2023/05/03 11:09  
Surveyed By: TYLER (P0038607-072022)  
Supervisor: DOUG B  
Pre-Cleaning: Light Cleaning  
Truck: 211MO  
Weather: Dry - No Precipitation During Survey  
Additional Info:


7895 St. Claire Ave, East St. Louis, IL 62207

## Observations

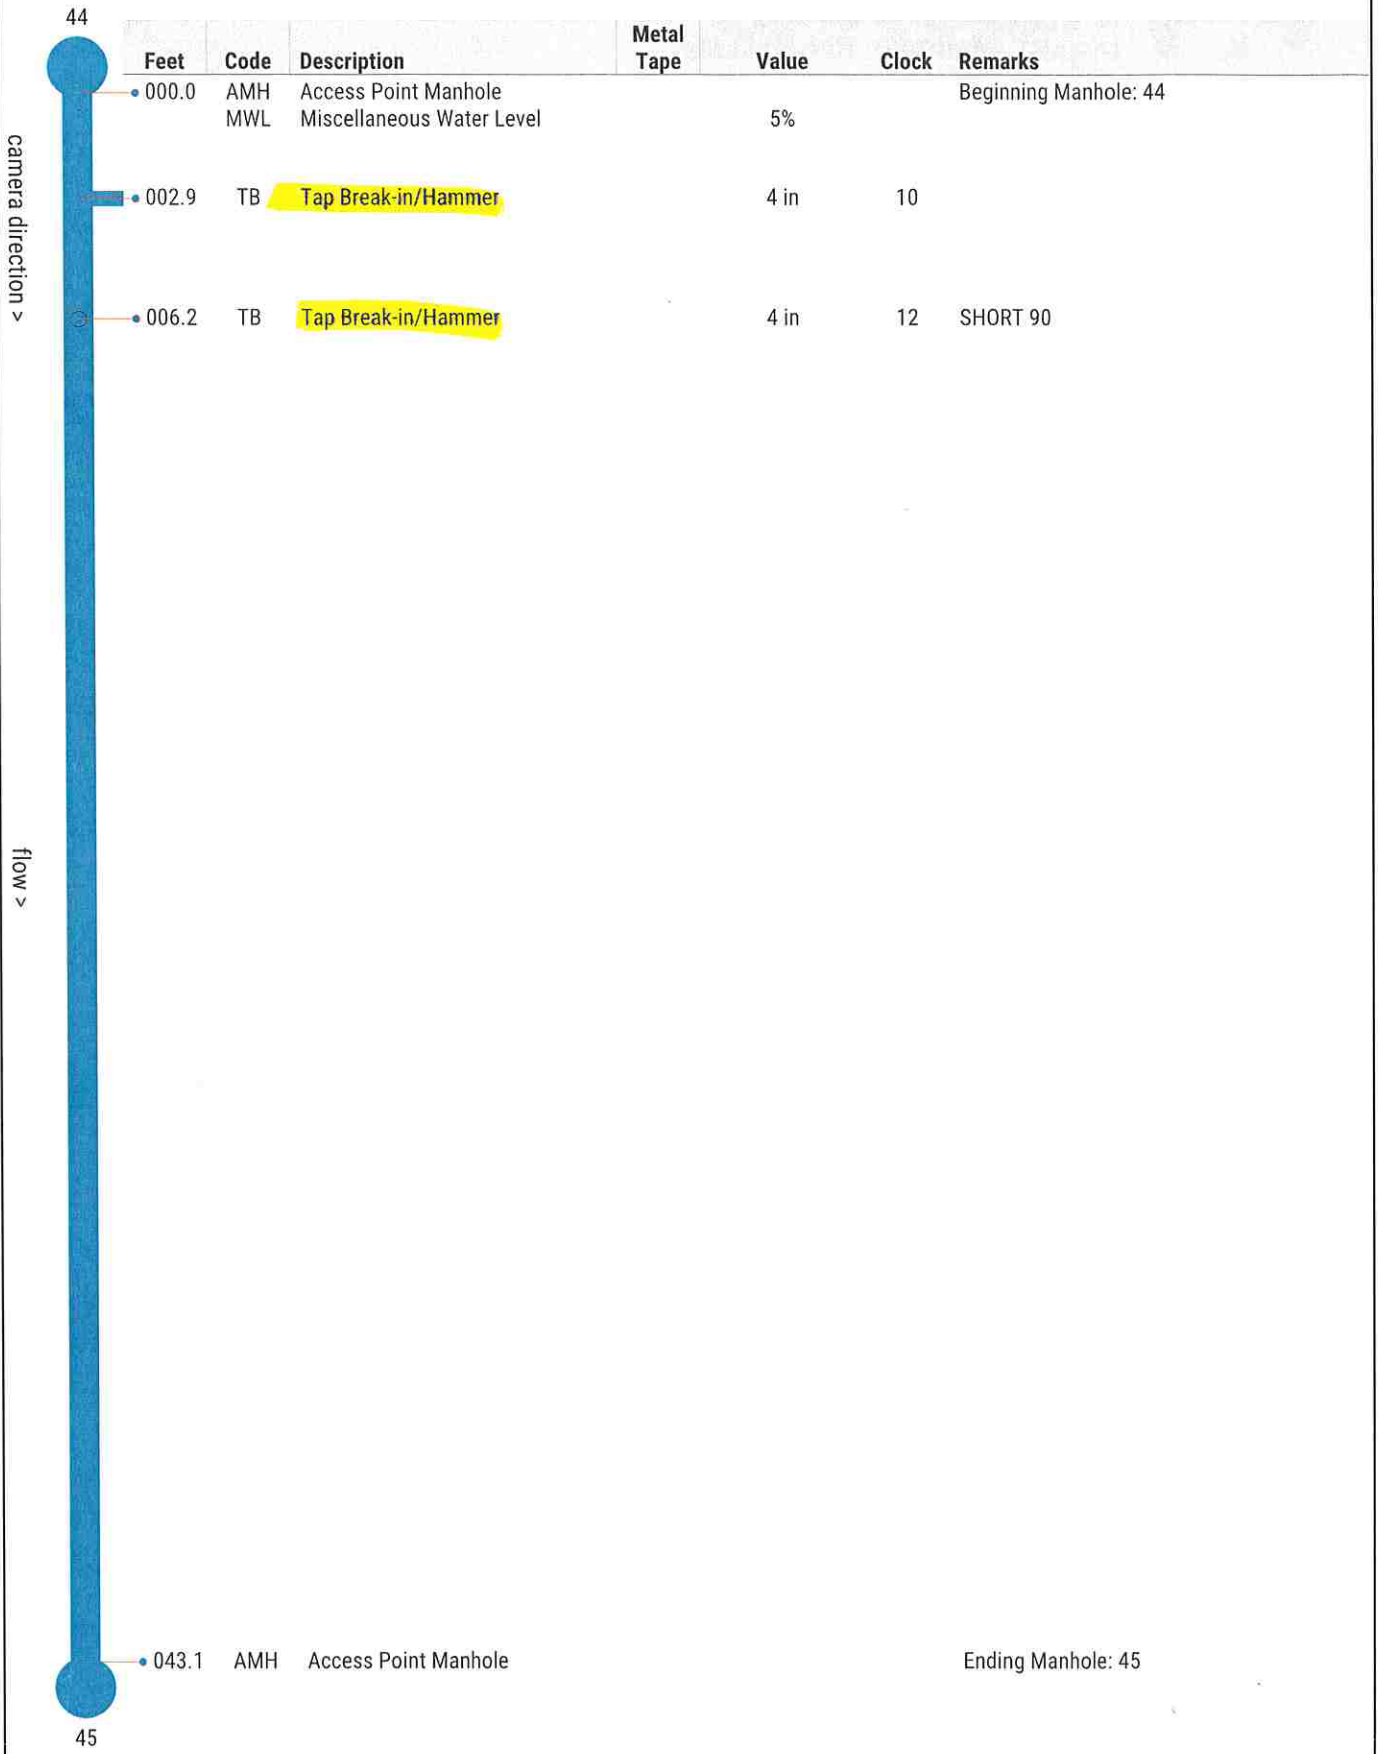

## Inspection Report

### Overview

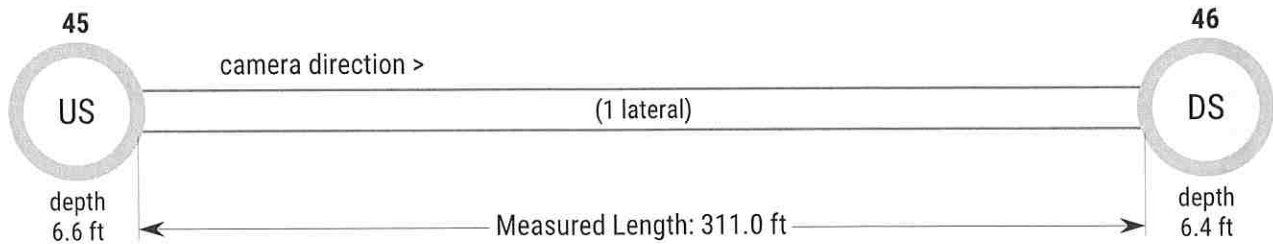

### Asset


Street: 11TH ST  
City: CASSVILLE MO  
Pipe Use: Sanitary Sewage Pipe  
Pipe Geometry: 8 in (Circular)  
Material: Vitrified Clay Pipe  
Map #/Plan File: 14  
Drainage Area:  
Flow Direction: →East  
Surface: Asphalt

### Inspection

Customer: ROSETTA CONSTRUCTION  
Project:  
Job #: 23010MO-11  
Media Date/Time: 2023/05/03 11:40  
Surveyed By: TYLER (P0038607-072022)  
Supervisor: DOUG B  
Pre-Cleaning: Light Cleaning  
Truck: 211MO  
Weather: Dry - No Precipitation During Survey  
Additional Info:

7895 St. Claire Ave, East St. Louis, IL 62207


## Observations

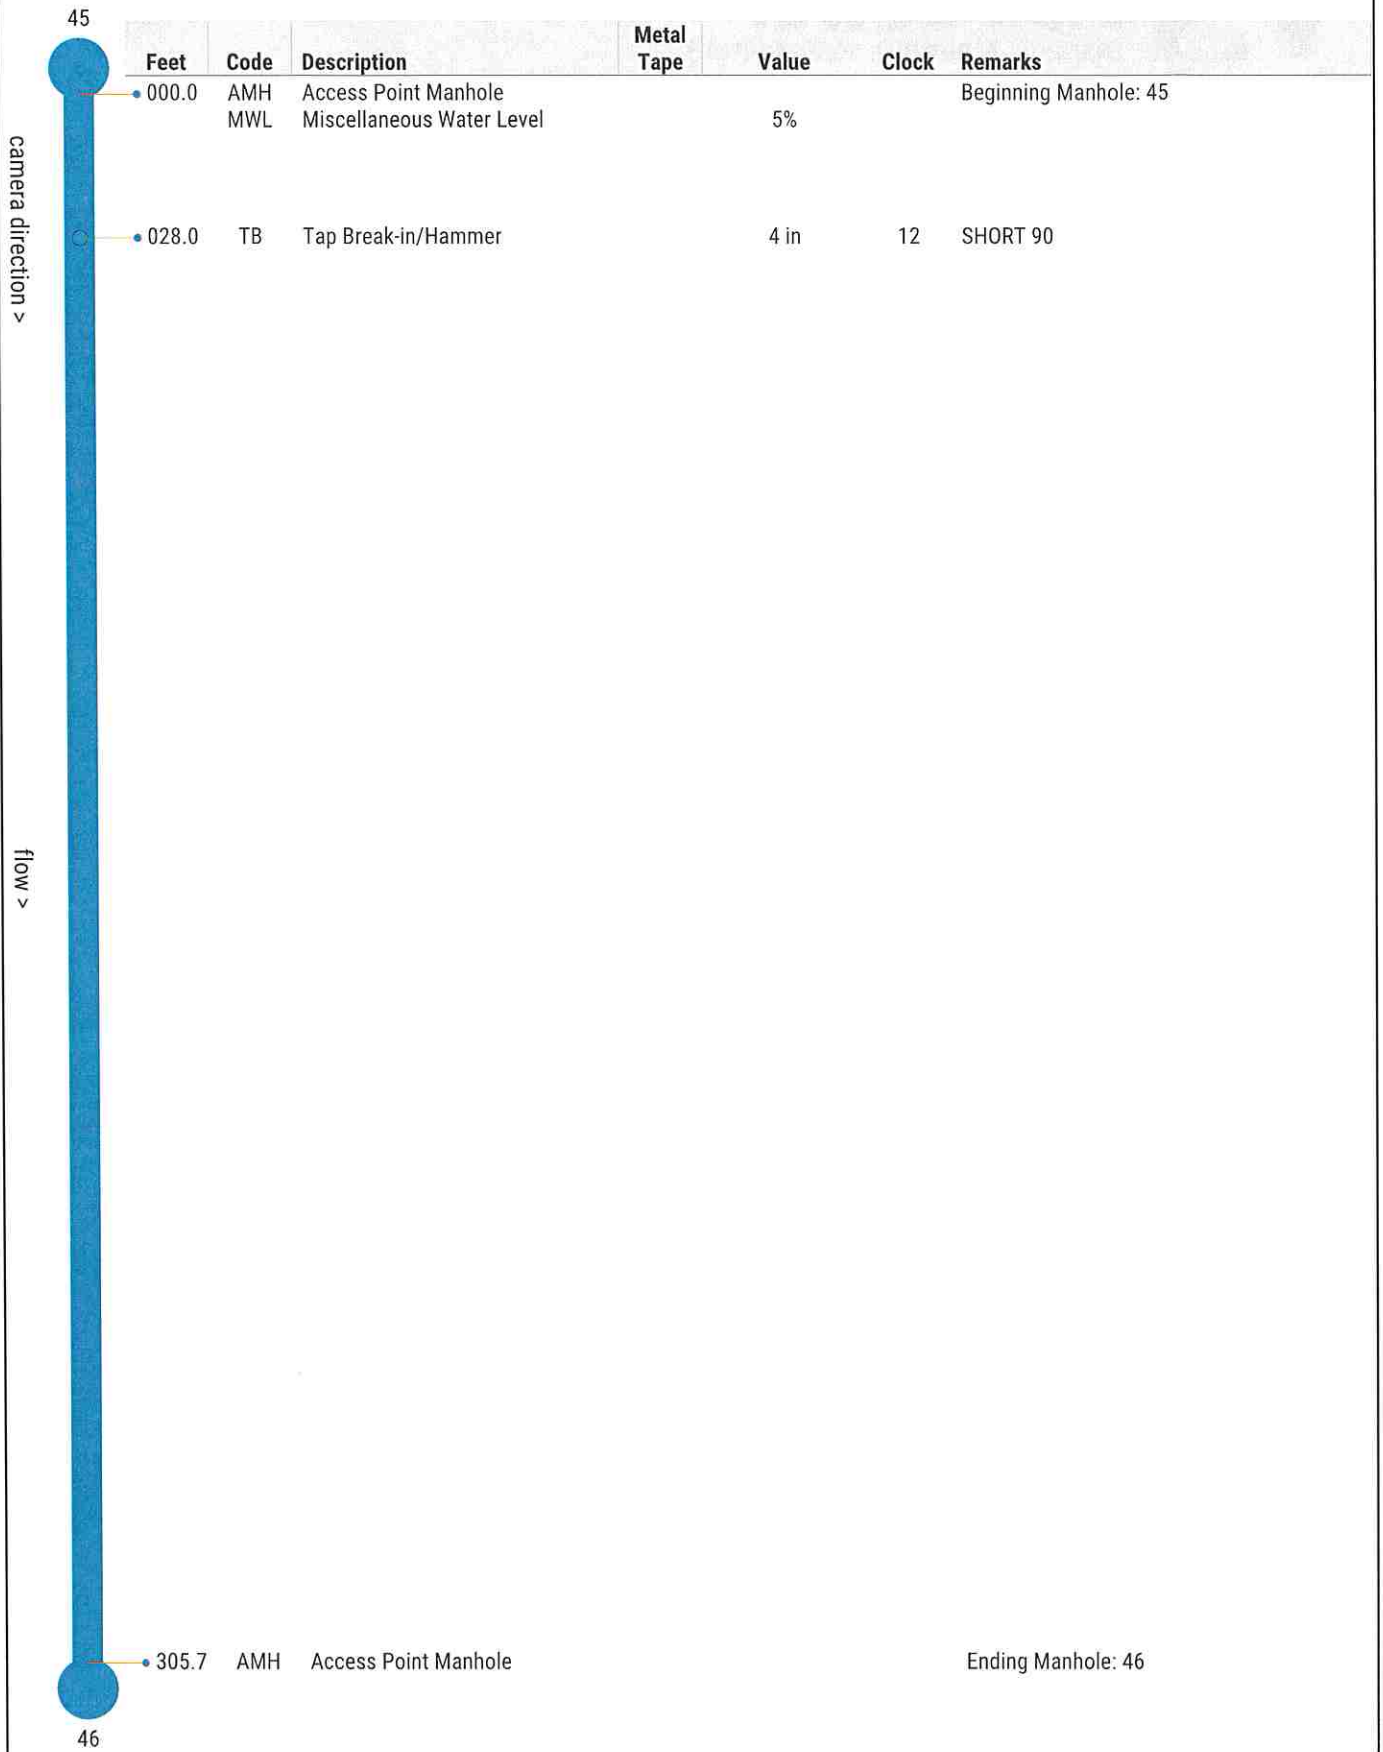



## Inspection Report

### Overview

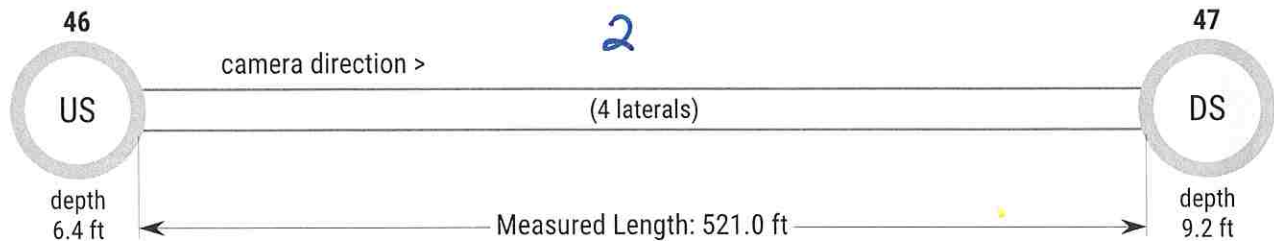

### Asset


Street: 11TH ST  
City: CASSVILLE MO  
Pipe Use: Sanitary Sewage Pipe  
Pipe Geometry: 8 in (Circular)  
Material: Vitrified Clay Pipe  
Map #/Plan File: 15  
Drainage Area:  
Flow Direction: →East  
Surface: Asphalt

### Inspection

Customer: ROSETTA CONSTRUCTION  
Project:  
Job #: 23010MO-11  
Media Date/Time: 2023/05/04 12:32  
Surveyed By: TYLER (P0038607-072022)  
Supervisor: DOUG B  
Pre-Cleaning: Heavy Cleaning  
Truck: 211MO  
Weather: Dry - No Precipitation During Survey  
Additional Info: LINE SWITCHES TO 10INCH SEE NOTES


7895 St. Claire Ave, East St. Louis, IL 62207

## Observations

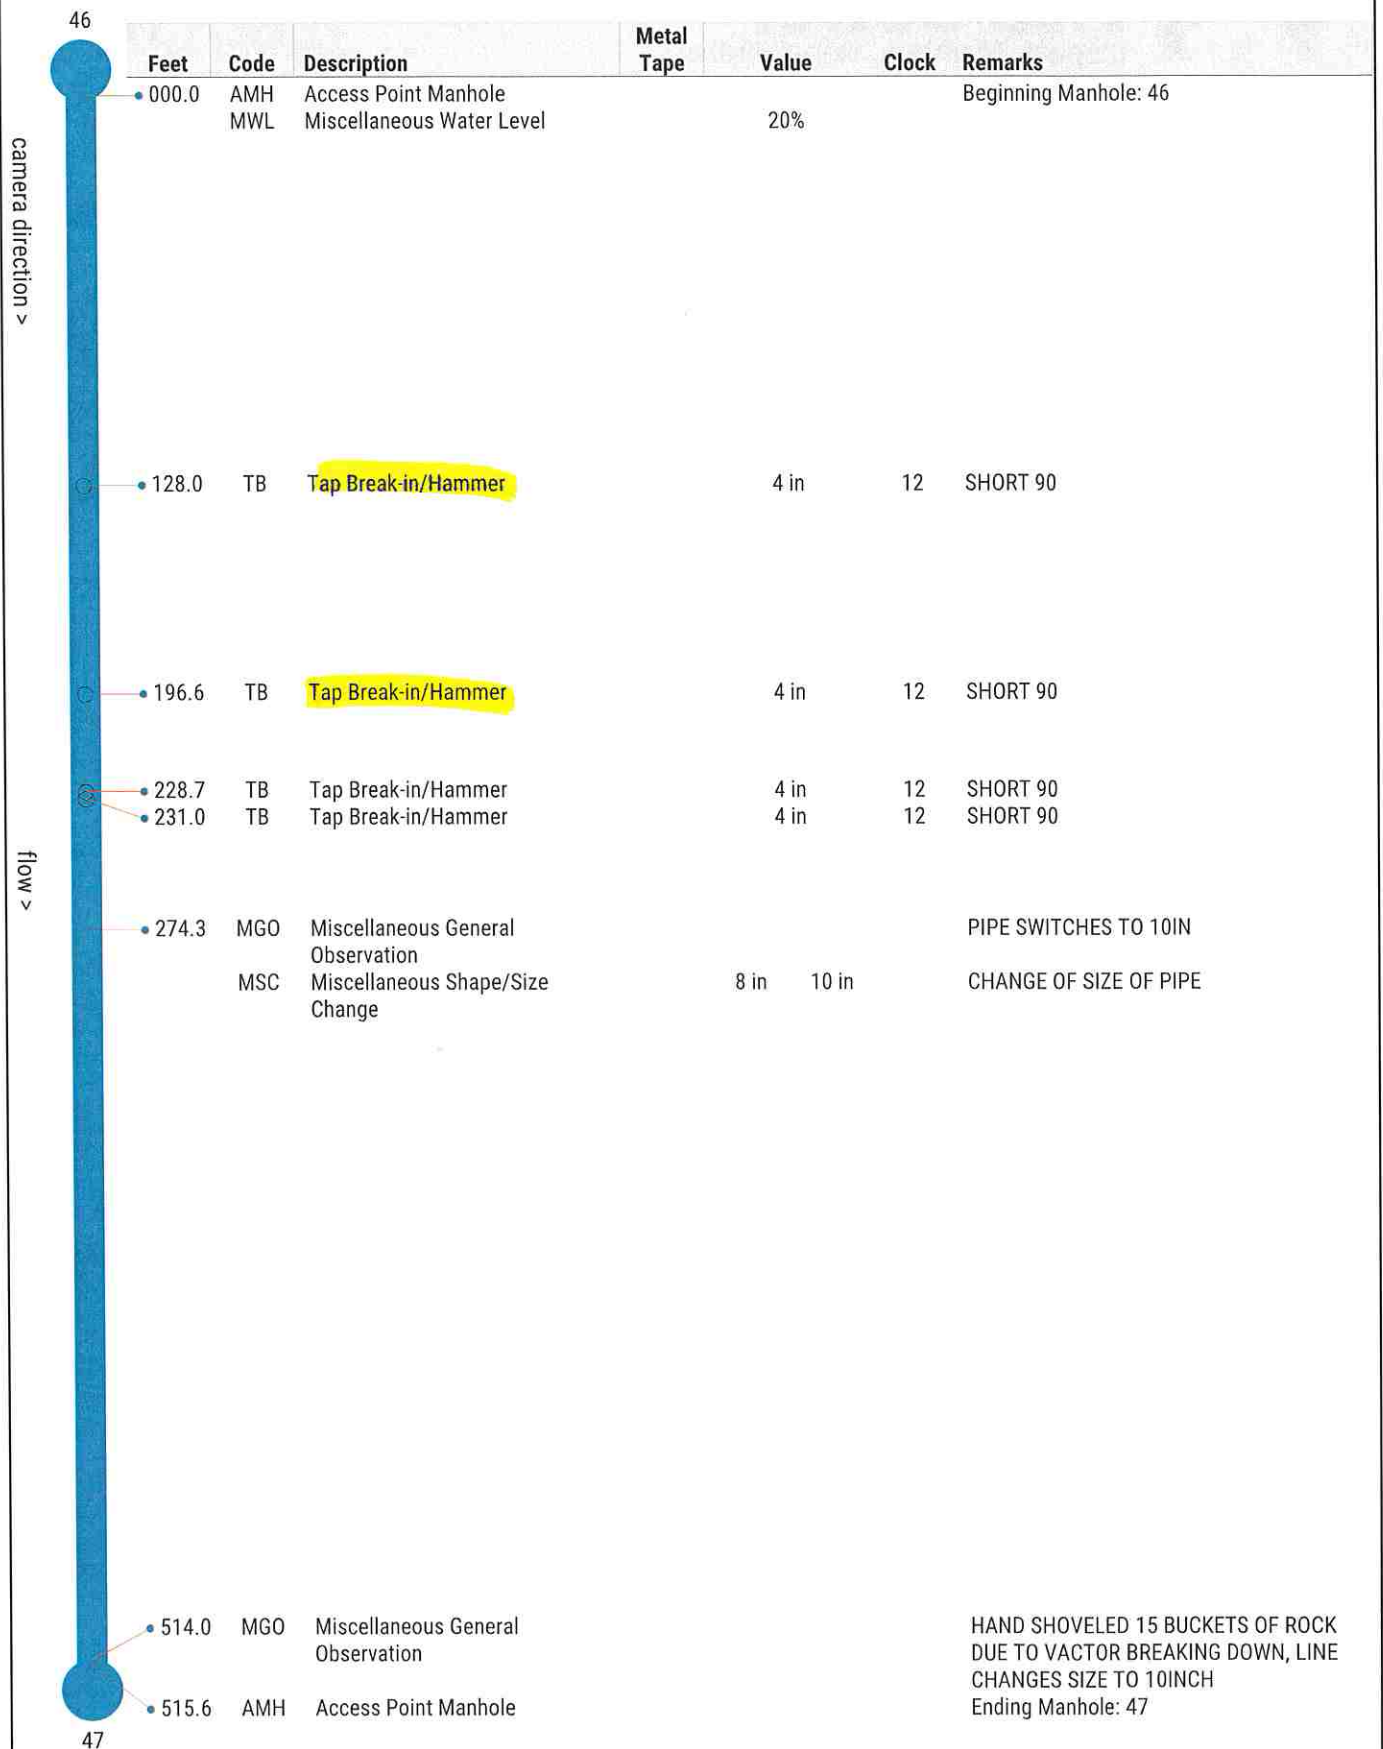

## Inspection Report

### Overview

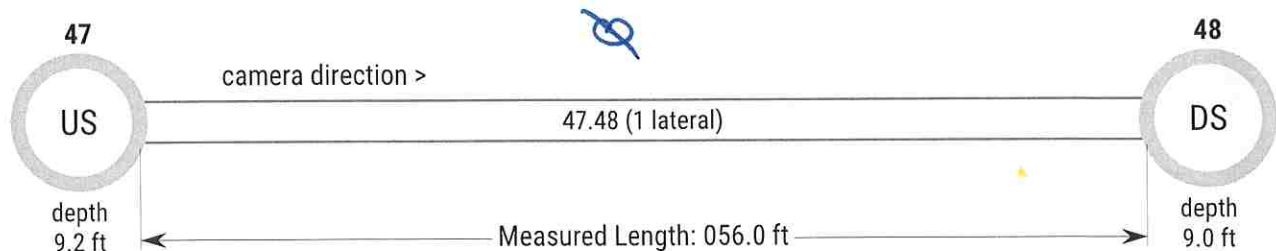

### Asset


Street: 11TH ST  
City: CASSVILLE MO  
Pipe Use: Sanitary Sewage Pipe  
Pipe Geometry: 8 in (Circular)  
Material: Vitrified Clay Pipe  
Map #/Plan File: 15  
Drainage Area:  
Flow Direction: ↑ North  
Surface: Asphalt

### Inspection

Customer: ROSETTA CONSTRUCTION  
Project:  
Job #: 23010MO-11  
Media Date/Time: 2023/05/08 01:53  
Surveyed By: TYLER (P0038607-072022)  
Supervisor: DOUG B  
Pre-Cleaning: Heavy Cleaning  
Truck: 211MO  
Weather: Dry - No Precipitation During Survey  
Additional Info: PLUGGED UPSTREAM LINE IN MANHOLE 47


7895 St. Claire Ave, East St. Louis, IL 62207

## Observations

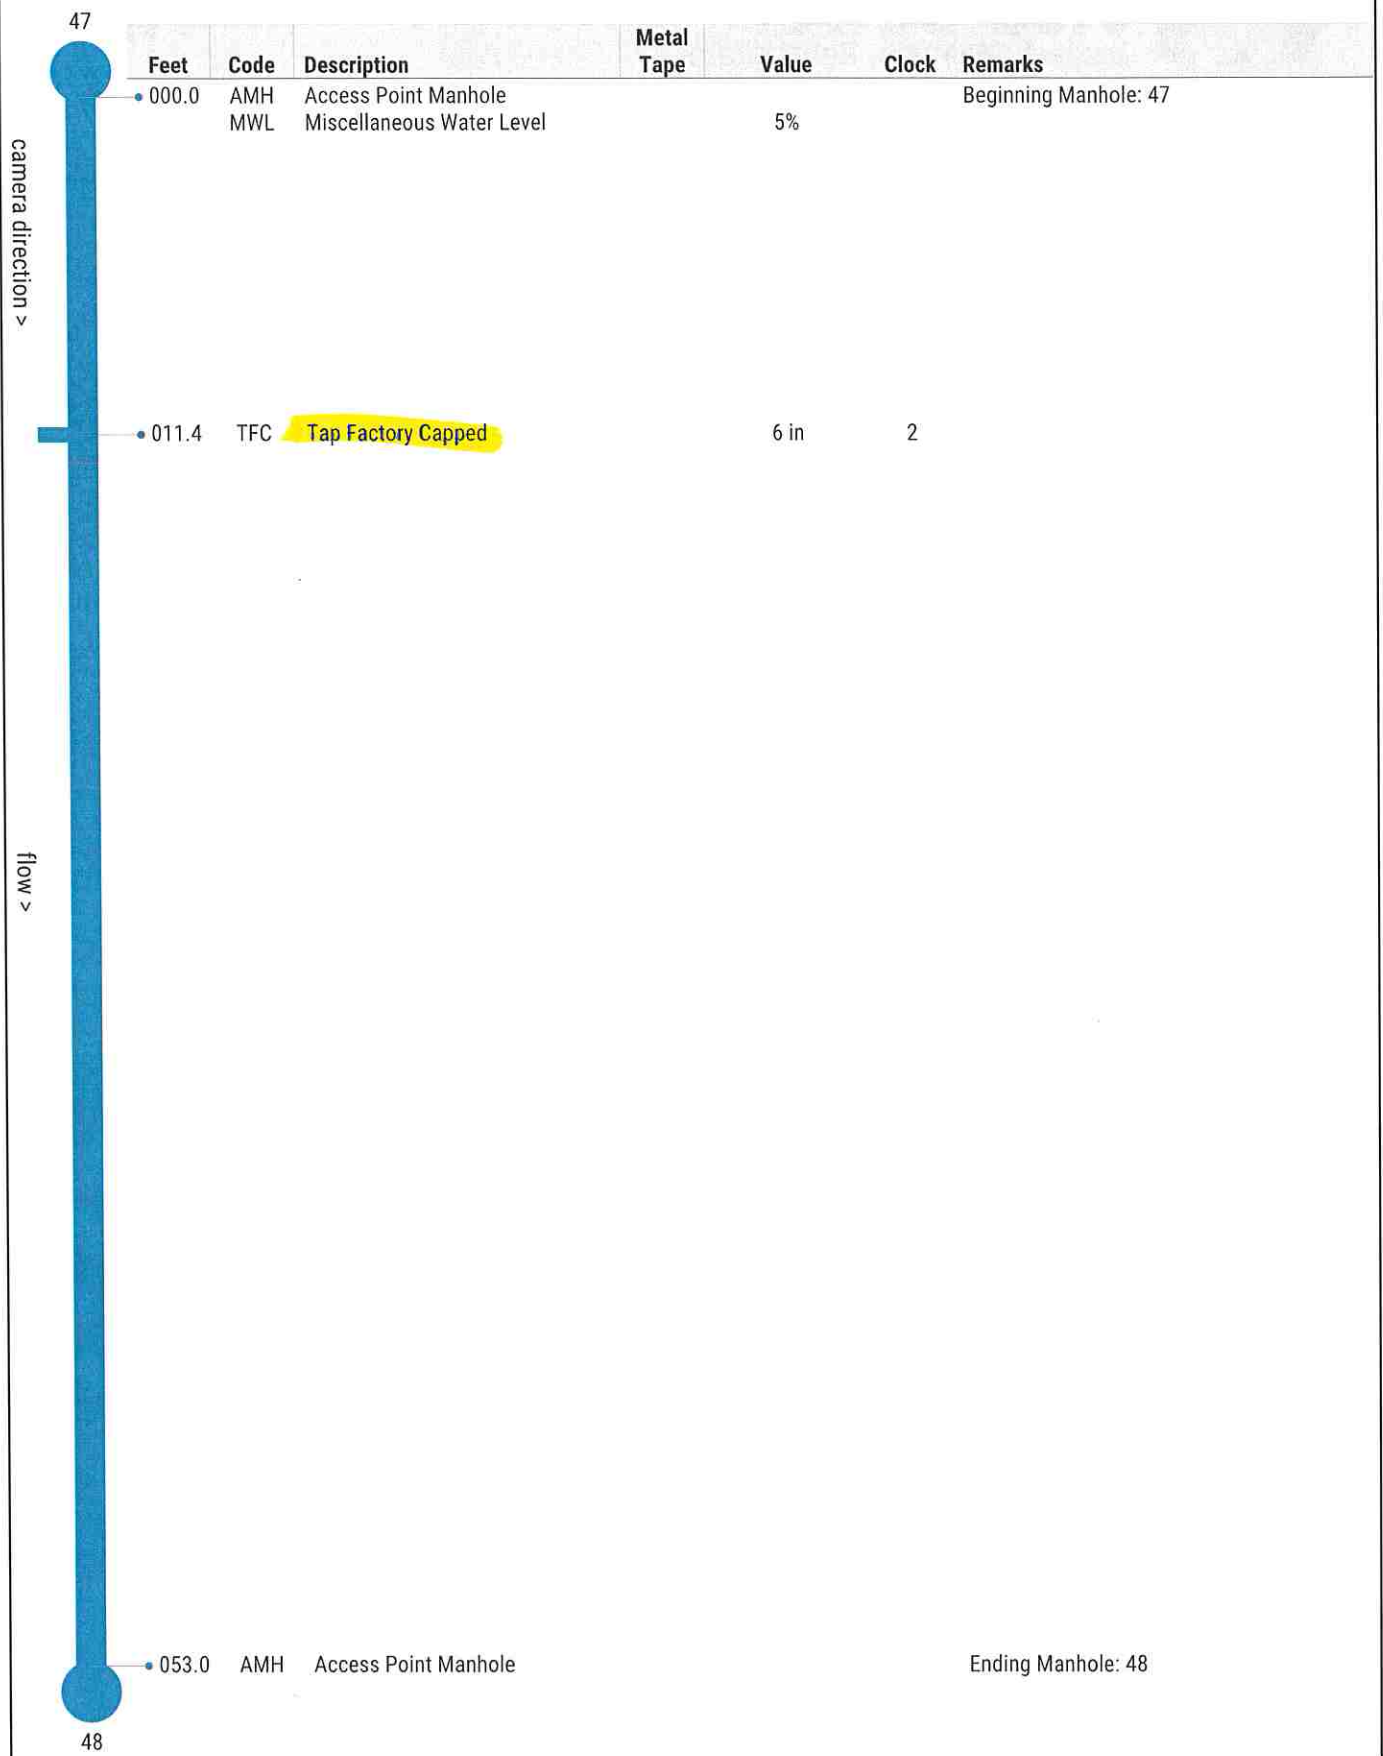

## Inspection Report

### Overview

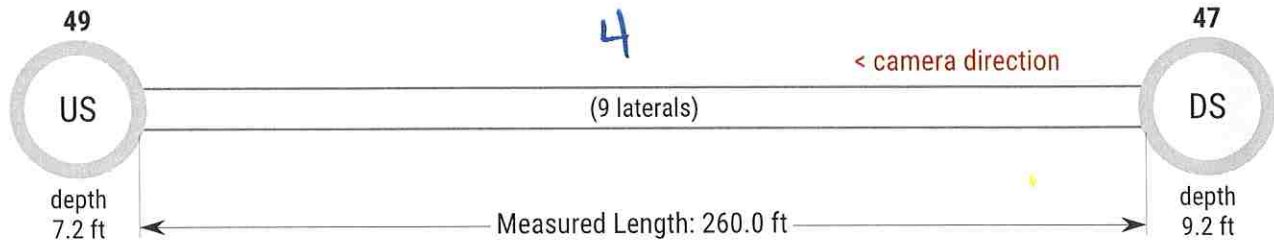

### Asset

Street: TOWNSEND ST  
City: CASSVILLE MO  
Pipe Use: Sanitary Sewage Pipe  
Pipe Geometry: 8 in (Circular)  
Material: Vitrified Clay Pipe  
Map #/Plan File: 15  
Drainage Area:  
Flow Direction: ↗Northeast  
Surface: Asphalt

### Inspection

Customer: ROSETTA CONSTRUCTION  
Project:  
Job #: 23010MO-11  
Media Date/Time: 2023/04/18 02:41  
Surveyed By: TYLER (P0038607-072022)  
Supervisor: DOUG B  
Pre-Cleaning: Heavy Cleaning  
Truck: 211MO  
Weather: Dry - No Precipitation During Survey  
Additional Info: HAD TO RUN ROOT SAW AND CAMERA FROM DOWNSTREAM MANHOLE, RAN UP LINE 9 TIMES WITH ROOT SAW.

7895 St. Claire Ave, East St. Louis, IL 62207


## Observations

	Feet	Code	Description	Metal Tape	Value	Clock	Remarks
49	253.1	AMH	Access Point Manhole				Ending Manhole: 49
	247.1	TB	Tap Break-in/Hammer		4 in	12	90
	230.1	TF	Tap Factory		6 in	2	
	196.5	TF	Tap Factory		6 in	10	100% ROOTS
	193.7	TB	Tap Break-in/Hammer		4 in	12	90 AND ROOTS
	151.8	TB	Tap Break-in/Hammer		4 in	2	SHORT 90
	150.2	TFC	Tap Factory Capped		6 in	2	LOOKS LIKE CONCRETE CAP
	115.3	TFC	Tap Factory Capped		6 in	2	
	063.2	TFC	Tap Factory Capped		6 in	2	ROOTS CUT OFF
	048.7	RMJ	Roots Medium Joint		100%	12 - 11	JOINTS HAD 100% ROOTS COMING THROUGH ALSO ARE CUT OFF NOW
	017.0	TB	Tap Break-in/Hammer		6 in	1	ROOTS CUT OFF
	012.0	RTL	Roots Tap Lateral		100%	10 - 2	LATERALS ON BOTH SIDES HAD ROOTS BLOCKING MAINLINE 100% WE CUT THEM OUT
	000.0	RTL	Roots Tap Lateral		100%	10 - 2	LATERALS ON BOTH SIDES HAD ROOTS BLOCKING MAINLINE 100% WE CUT THEM OUT
		RMJ	Roots Medium Joint		100%	12 - 11	JOINTS HAD 100% ROOTS COMING THROUGH ALSO ARE CUT OFF NOW
		MWL	Miscellaneous Water Level		5%		
47		AMH	Access Point Manhole				Beginning Manhole: 47



## Inspection Report

### Overview

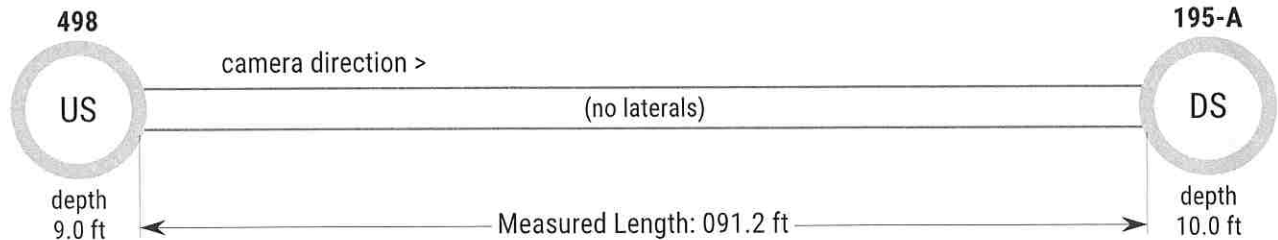

### Asset

Street: FASCO RD  
City: CASSVILLE MO  
Pipe Use: Sanitary Sewage Pipe  
Pipe Geometry: 8 in (Circular)  
Material: Vitrified Clay Pipe  
Map #/Plan File: 17  
Drainage Area:  
Flow Direction: ↗Northeast  
Surface: Grass

### Inspection

Customer: ROSETTA CONSTRUCTION  
Project:  
Job #: 23010MO-11  
Media Date/Time: 2023/05/02 09:53  
Surveyed By: TYLER (P0038607-072022)  
Supervisor: DOUG B  
Pre-Cleaning: Light Cleaning  
Truck: 211MO  
Weather: Dry - No Precipitation During Survey  
Additional Info: MH 195A NEEDS NEW MH

7895 St. Claire Ave, East St. Louis, IL 62207

## Observations

498

camera direction >


flow >

Feet	Code	Description	Metal Tape	Value	Clock	Remarks
• 000.0	AMH MWL	Access Point Manhole Miscellaneous Water Level		10%		Beginning Manhole: 498
• 009.3	MMC	Miscellaneous Material Change				VCP TO CAST IRON
• 091.2	MSA	Miscellaneous Survey Abandoned				COULD NOT MAKE IT THROUGH LINE, NO DOWNSTREAM MANHOLE YET, WILL HAVE TO FINISH LINE WHEN MANHOLE IS REPLACED

195-A

## Inspection Report

### Overview

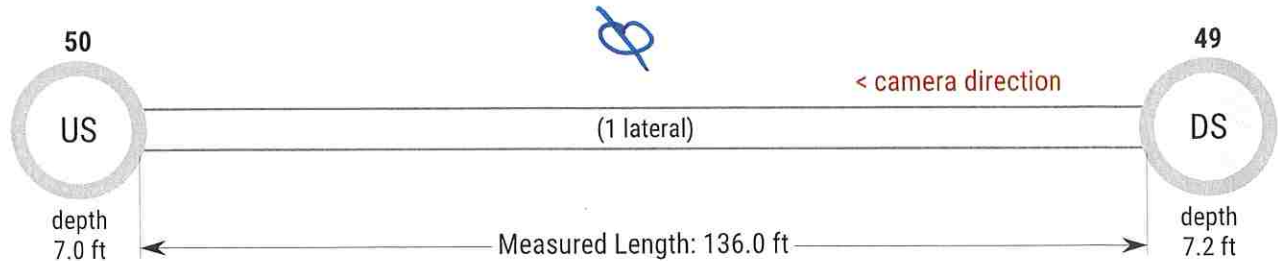

### Asset


Street: TOWNSEND ST  
City: CASSVILLE MO  
Pipe Use: Sanitary Sewage Pipe  
Pipe Geometry: 8 in (Circular)  
Material: Vitrified Clay Pipe  
Map #/Plan File: 15  
Drainage Area:  
Flow Direction: ↗Northeast  
Surface: Asphalt

### Inspection

Customer: ROSETTA CONSTRUCTION  
Project:  
Job #: 23010MO-11  
Media Date/Time: 2023/04/18 04:19  
Surveyed By: TYLER (P0038607-072022)  
Supervisor: DOUG B  
Pre-Cleaning: Light Cleaning  
Truck: 211MO  
Weather: Dry - No Precipitation During Survey  
Additional Info: CAST IRON SECTION


7895 St. Claire Ave, East St. Louis, IL 62207

## Observations

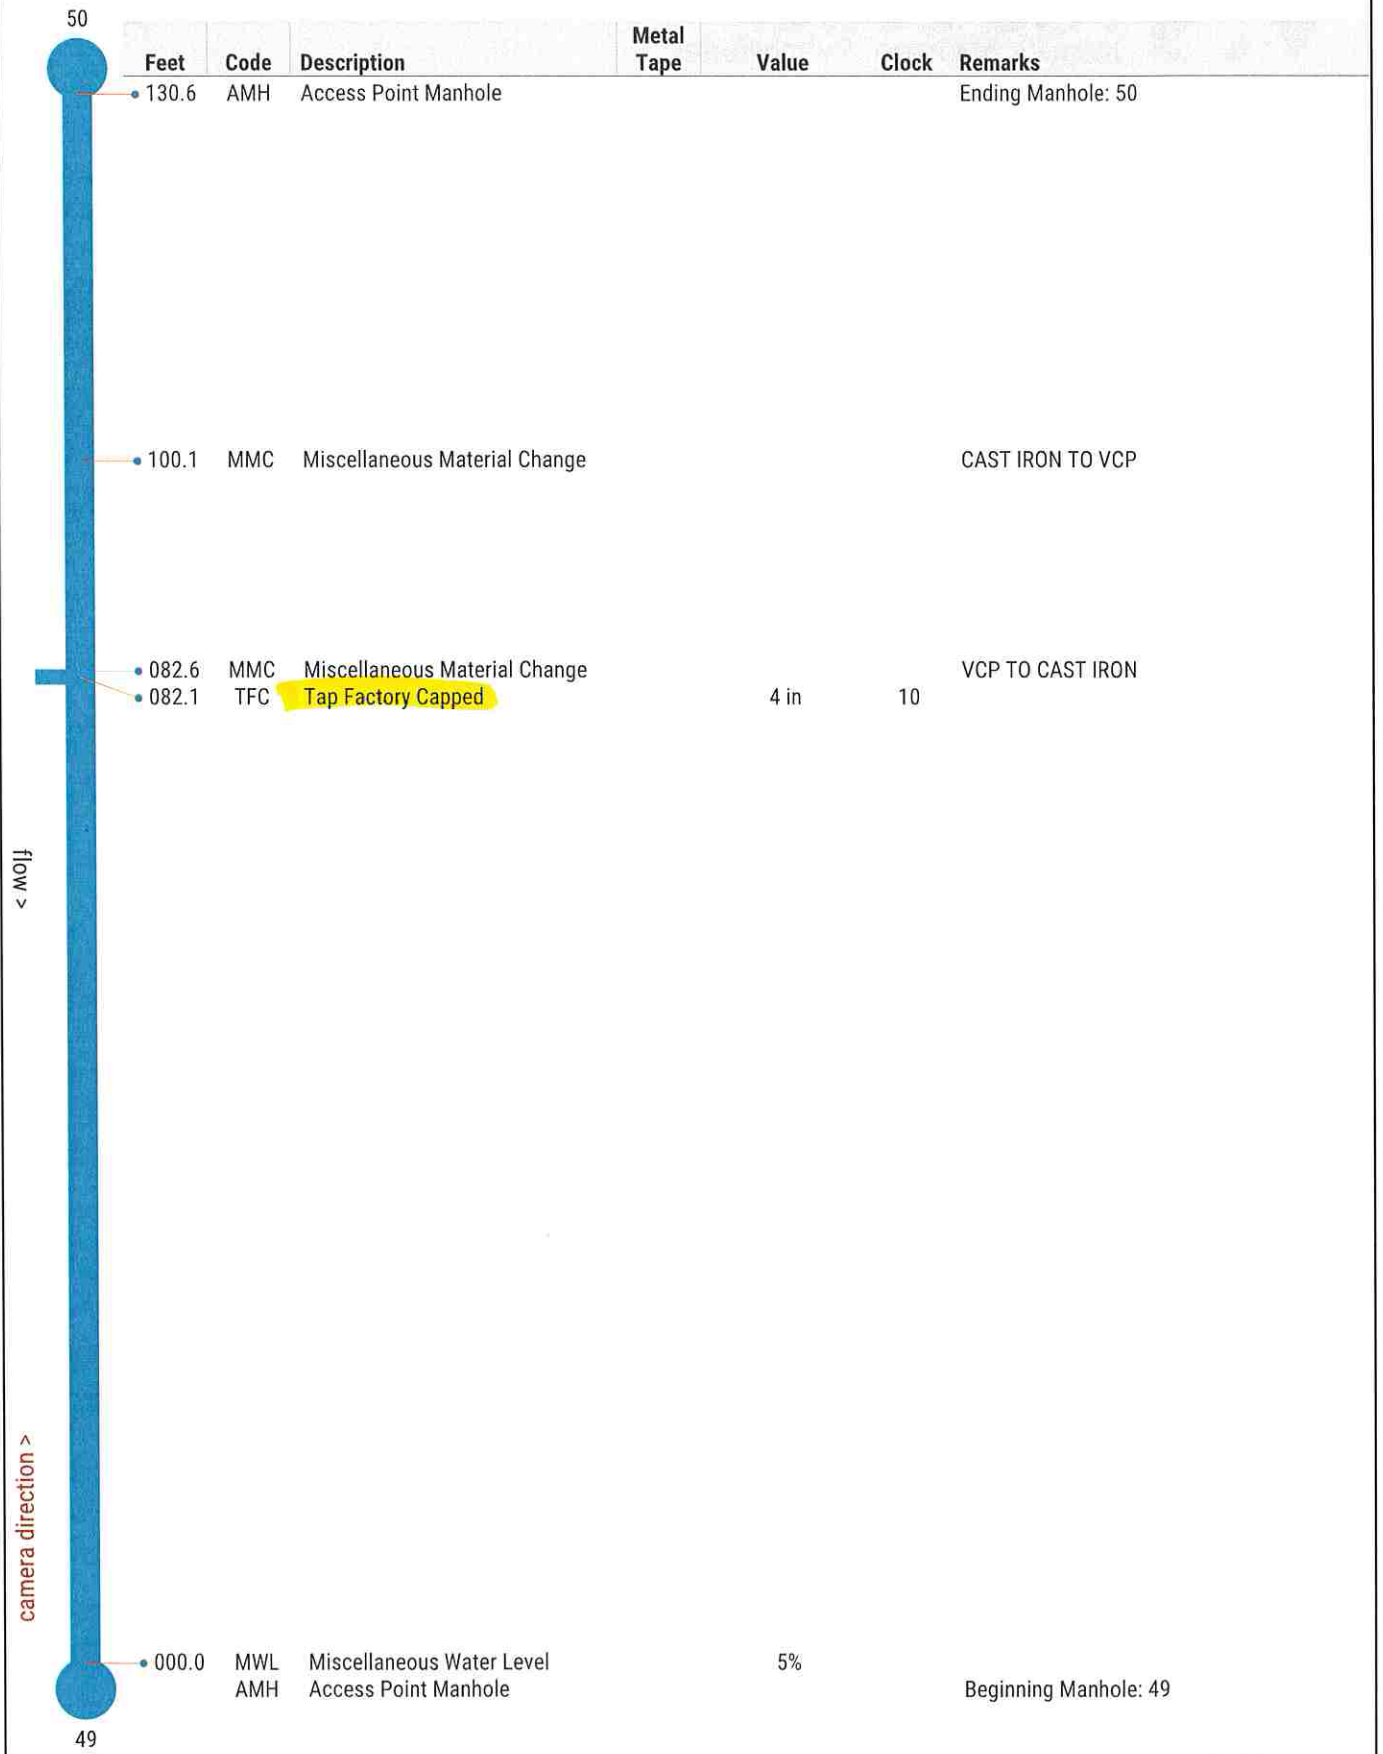

## Inspection Report

### Overview

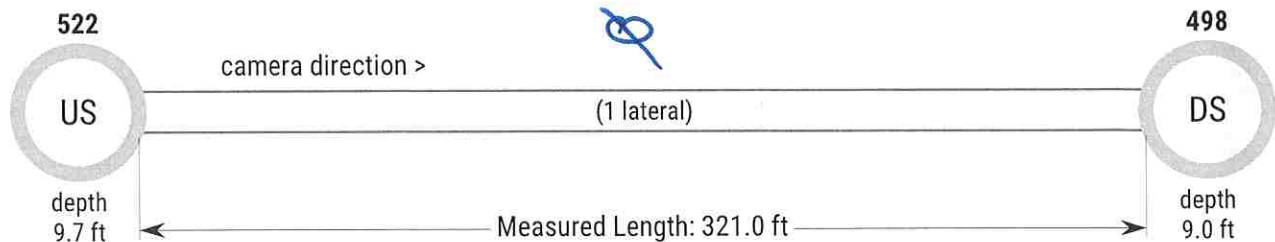

### Asset


Street: FASCO RD  
City: CASSVILLE MO  
Pipe Use: Sanitary Sewage Pipe  
Pipe Geometry: 8 in (Circular)  
Material: Vitrified Clay Pipe  
Map #/Plan File: 17  
Drainage Area:  
Flow Direction: ↑ North  
Surface: Grass

### Inspection

Customer: ROSETTA CONSTRUCTION  
Project:  
Job #: 23010MO-11  
Media Date/Time: 2023/05/02 08:39  
Surveyed By: TYLER (P0038607-072022)  
Supervisor: DOUG B  
Pre-Cleaning: Light Cleaning  
Truck: 211MO  
Weather: Dry - No Precipitation During Survey  
Additional Info:


7895 St. Claire Ave, East St. Louis, IL 62207

## Observations

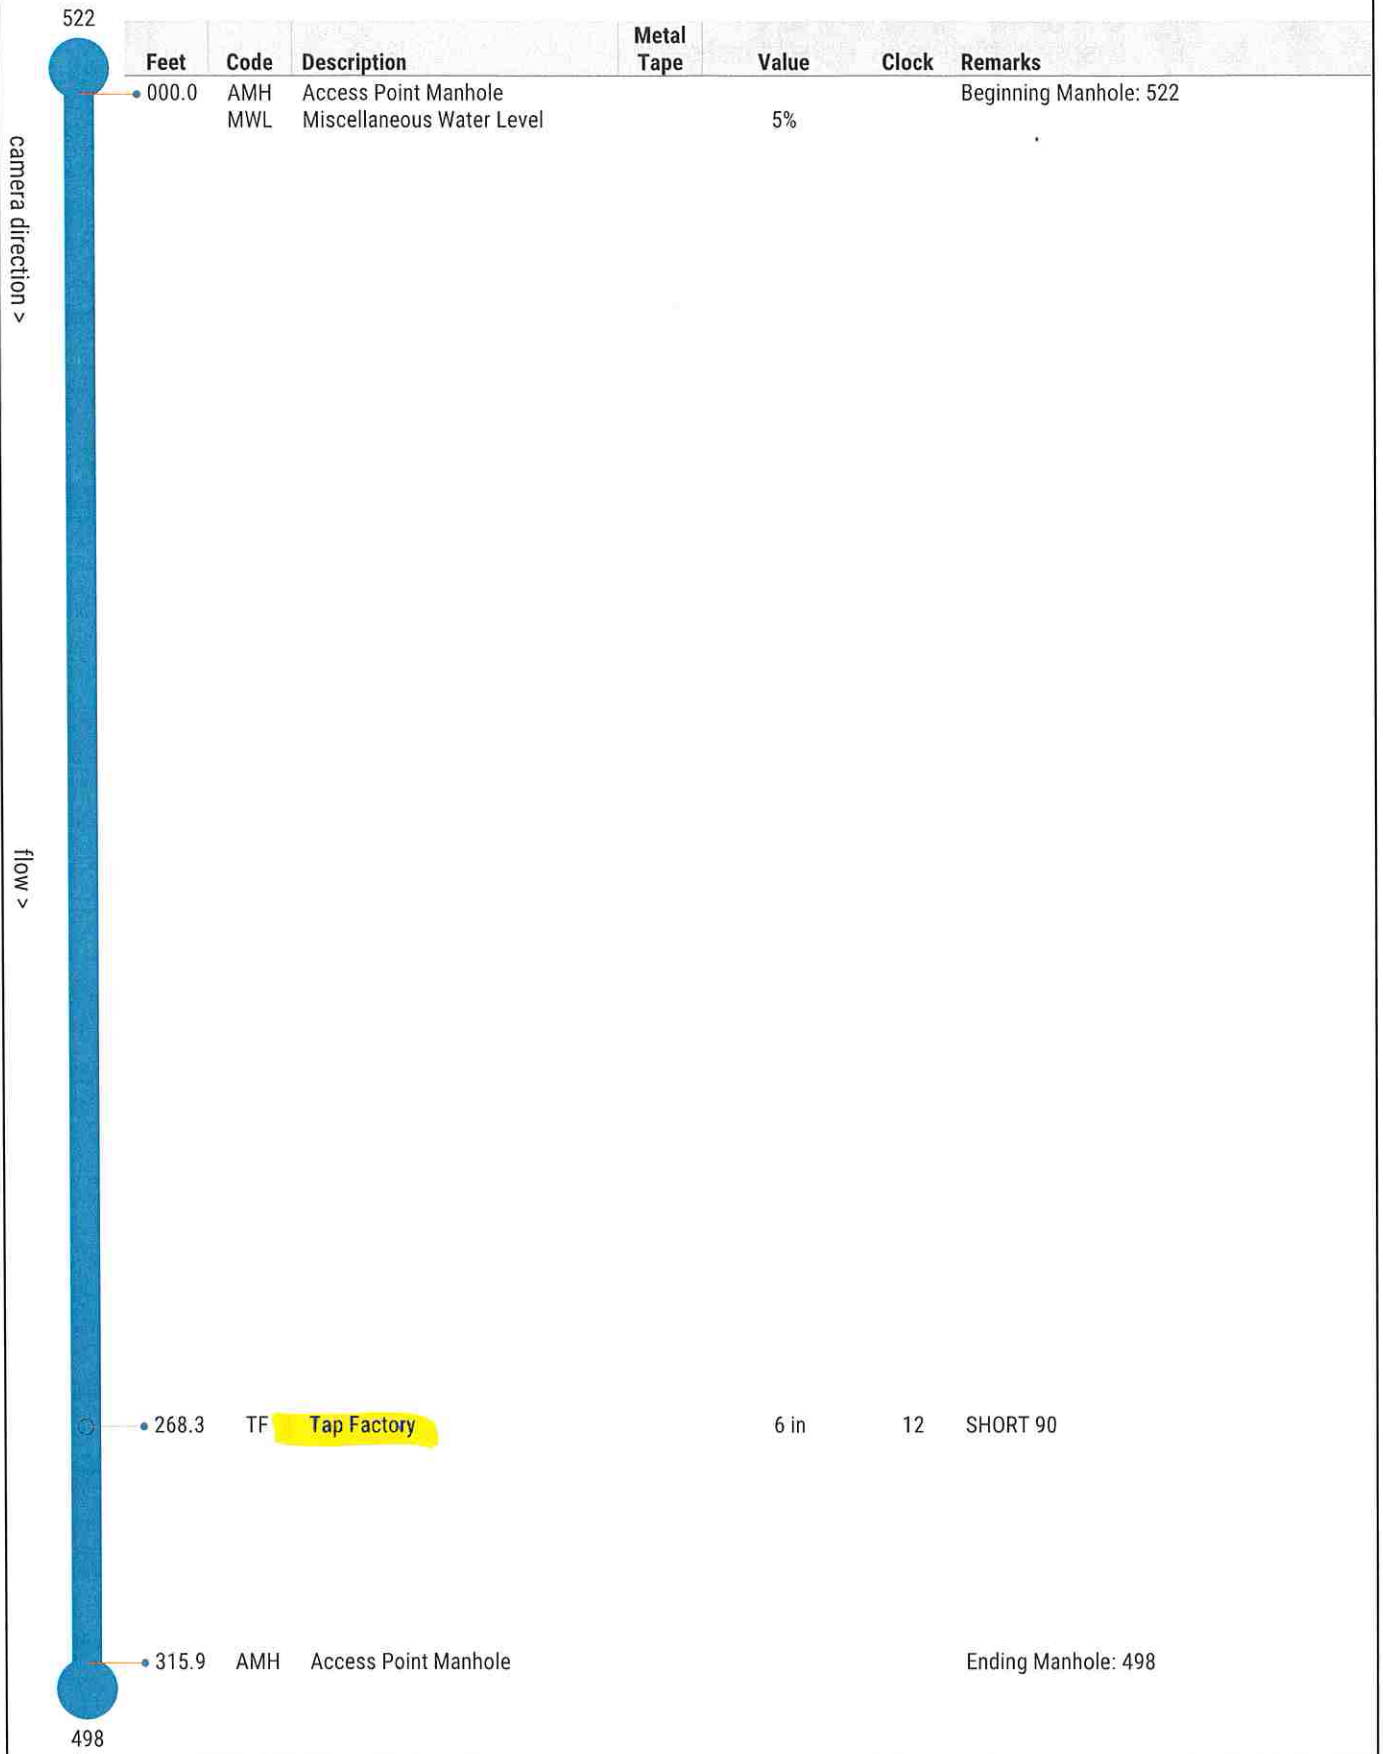

## Inspection Report

### Overview

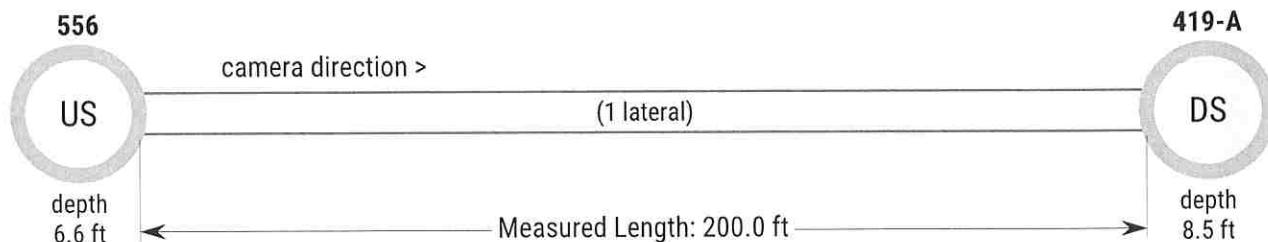

### Asset

Street: COUNTY FARM ROAD  
City: CASSVILLE MO  
Pipe Use: Sanitary Sewage Pipe  
Pipe Geometry: 8 in (Circular)  
Material: Vitrified Clay Pipe  
Map #/Plan File: 14  
Drainage Area:  
Flow Direction: ↓ South  
Surface: Asphalt


### Inspection

Customer: ROSETTA CONSTRUCTION  
Project:  
Job #: 23010MO-11  
Media Date/Time: 2023/04/11 09:02  
Surveyed By: TYLER (P0038607-072022)  
Supervisor: DOUG B  
Pre-Cleaning: Light Cleaning  
Truck: 211MO  
Weather: Dry - No Precipitation During Survey  
Additional Info:

7895 St. Claire Ave, East St. Louis, IL 62207




## Observations

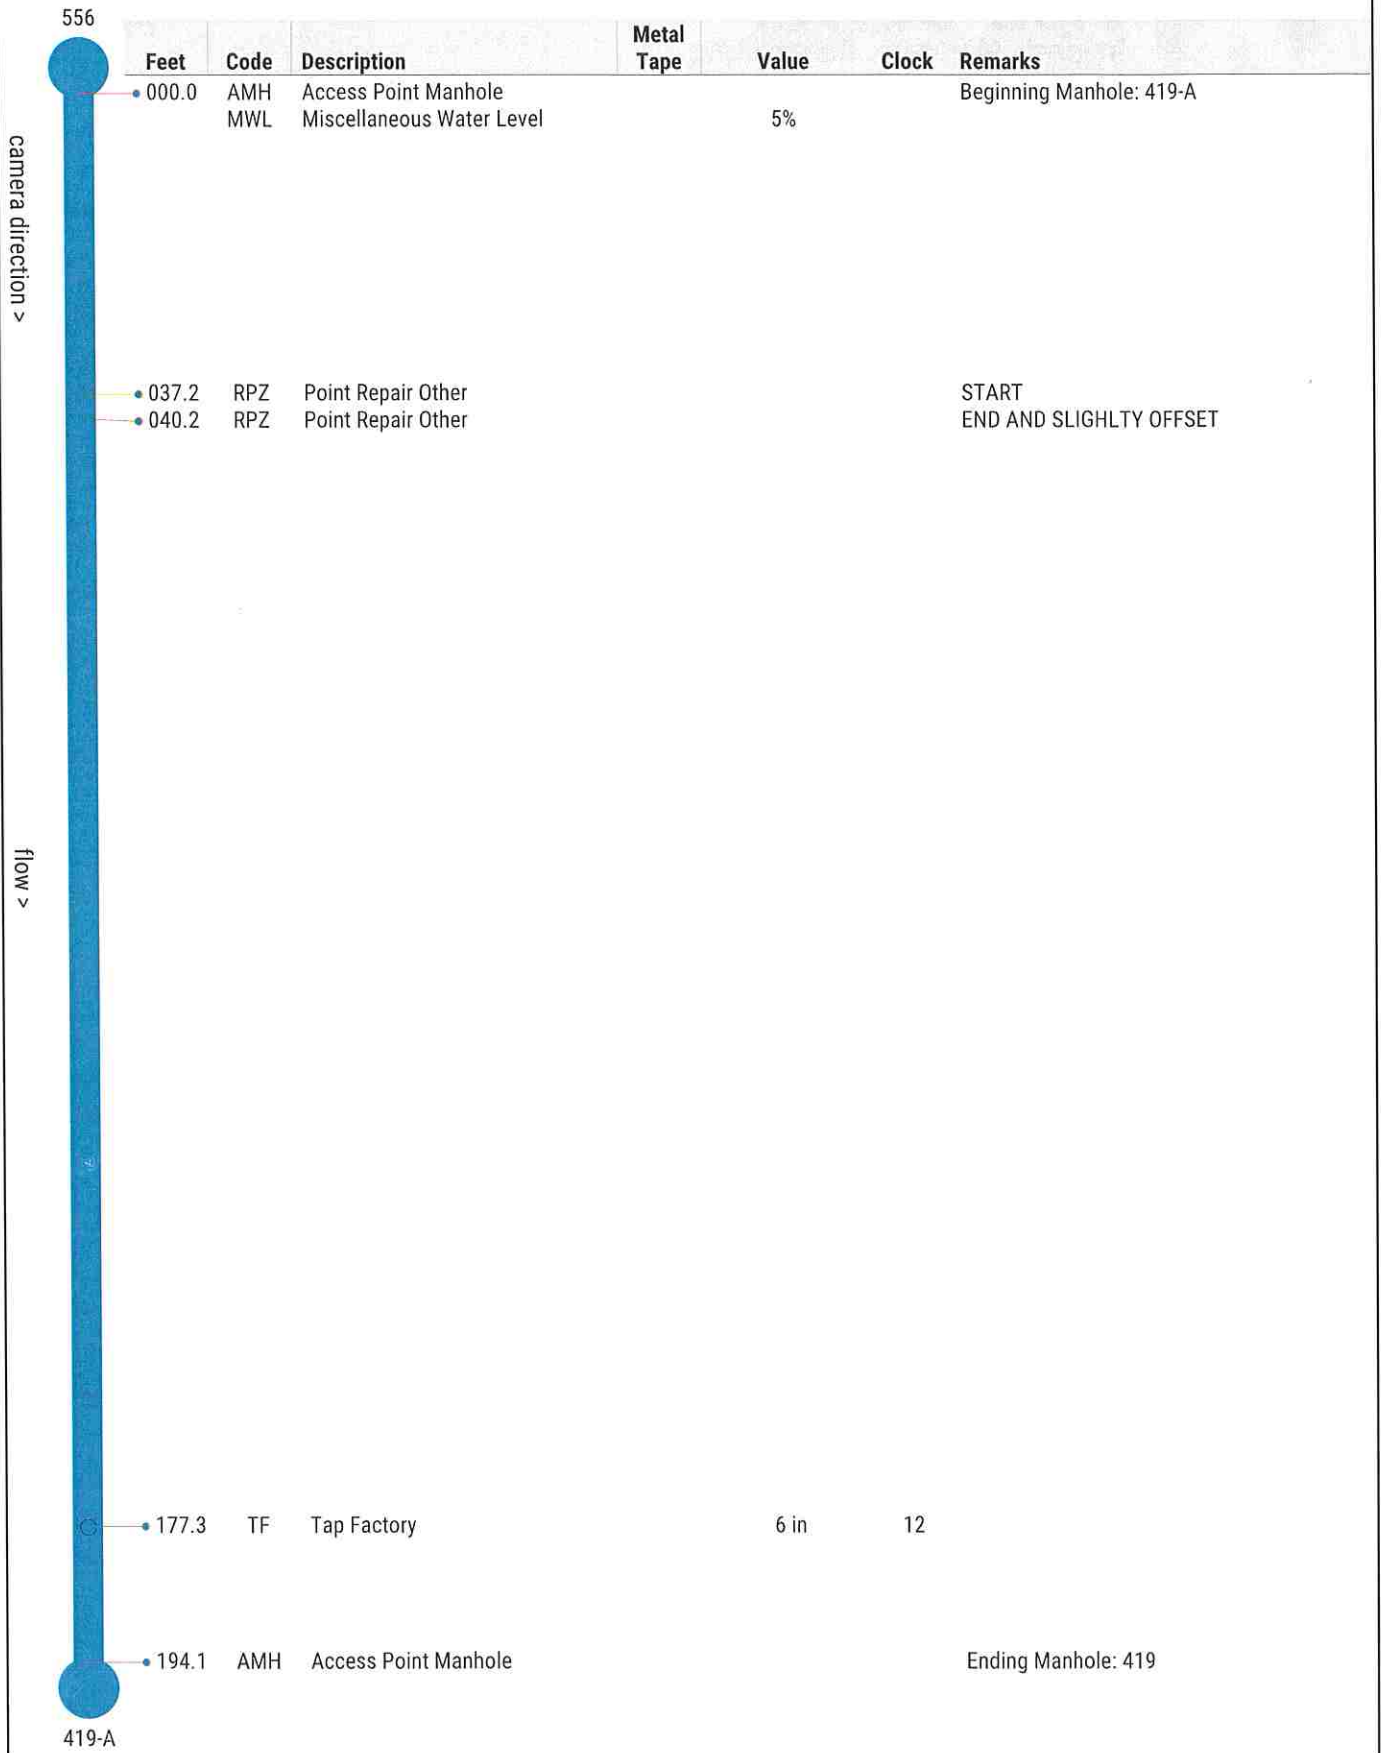

## Inspection Report

### Overview

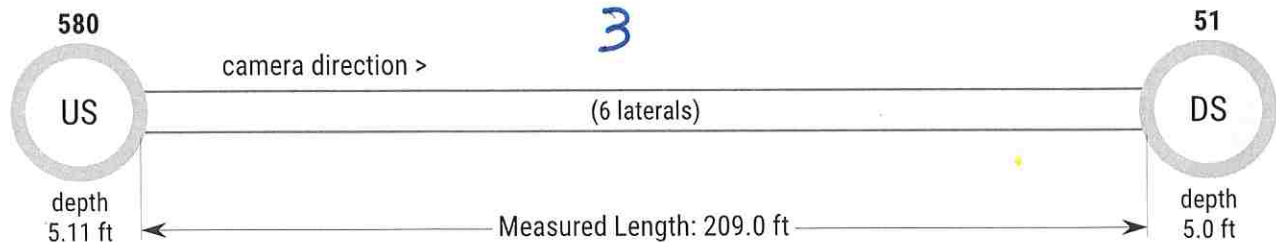

### Asset


Street: GRAVEL ST  
City: CASSVILLE MO  
Pipe Use: Sanitary Sewage Pipe  
Pipe Geometry: 8 in (Circular)  
Material: Vitrified Clay Pipe  
Map #/Plan File: 15  
Drainage Area:  
Flow Direction: ↑ North  
Surface: Asphalt

### Inspection

Customer: ROSETTA CONSTRUCTION  
Project:  
Job #: 23010MO-11  
Media Date/Time: 2023/04/18 10:56  
Surveyed By: TYLER (P0038607-072022)  
Supervisor: DOUG B  
Pre-Cleaning: Heavy Cleaning  
Truck: 211MO  
Weather: Dry - No Precipitation During Survey  
Additional Info: RAN ROOT SAW


7895 St. Claire Ave, East St. Louis, IL 62207

## Observations

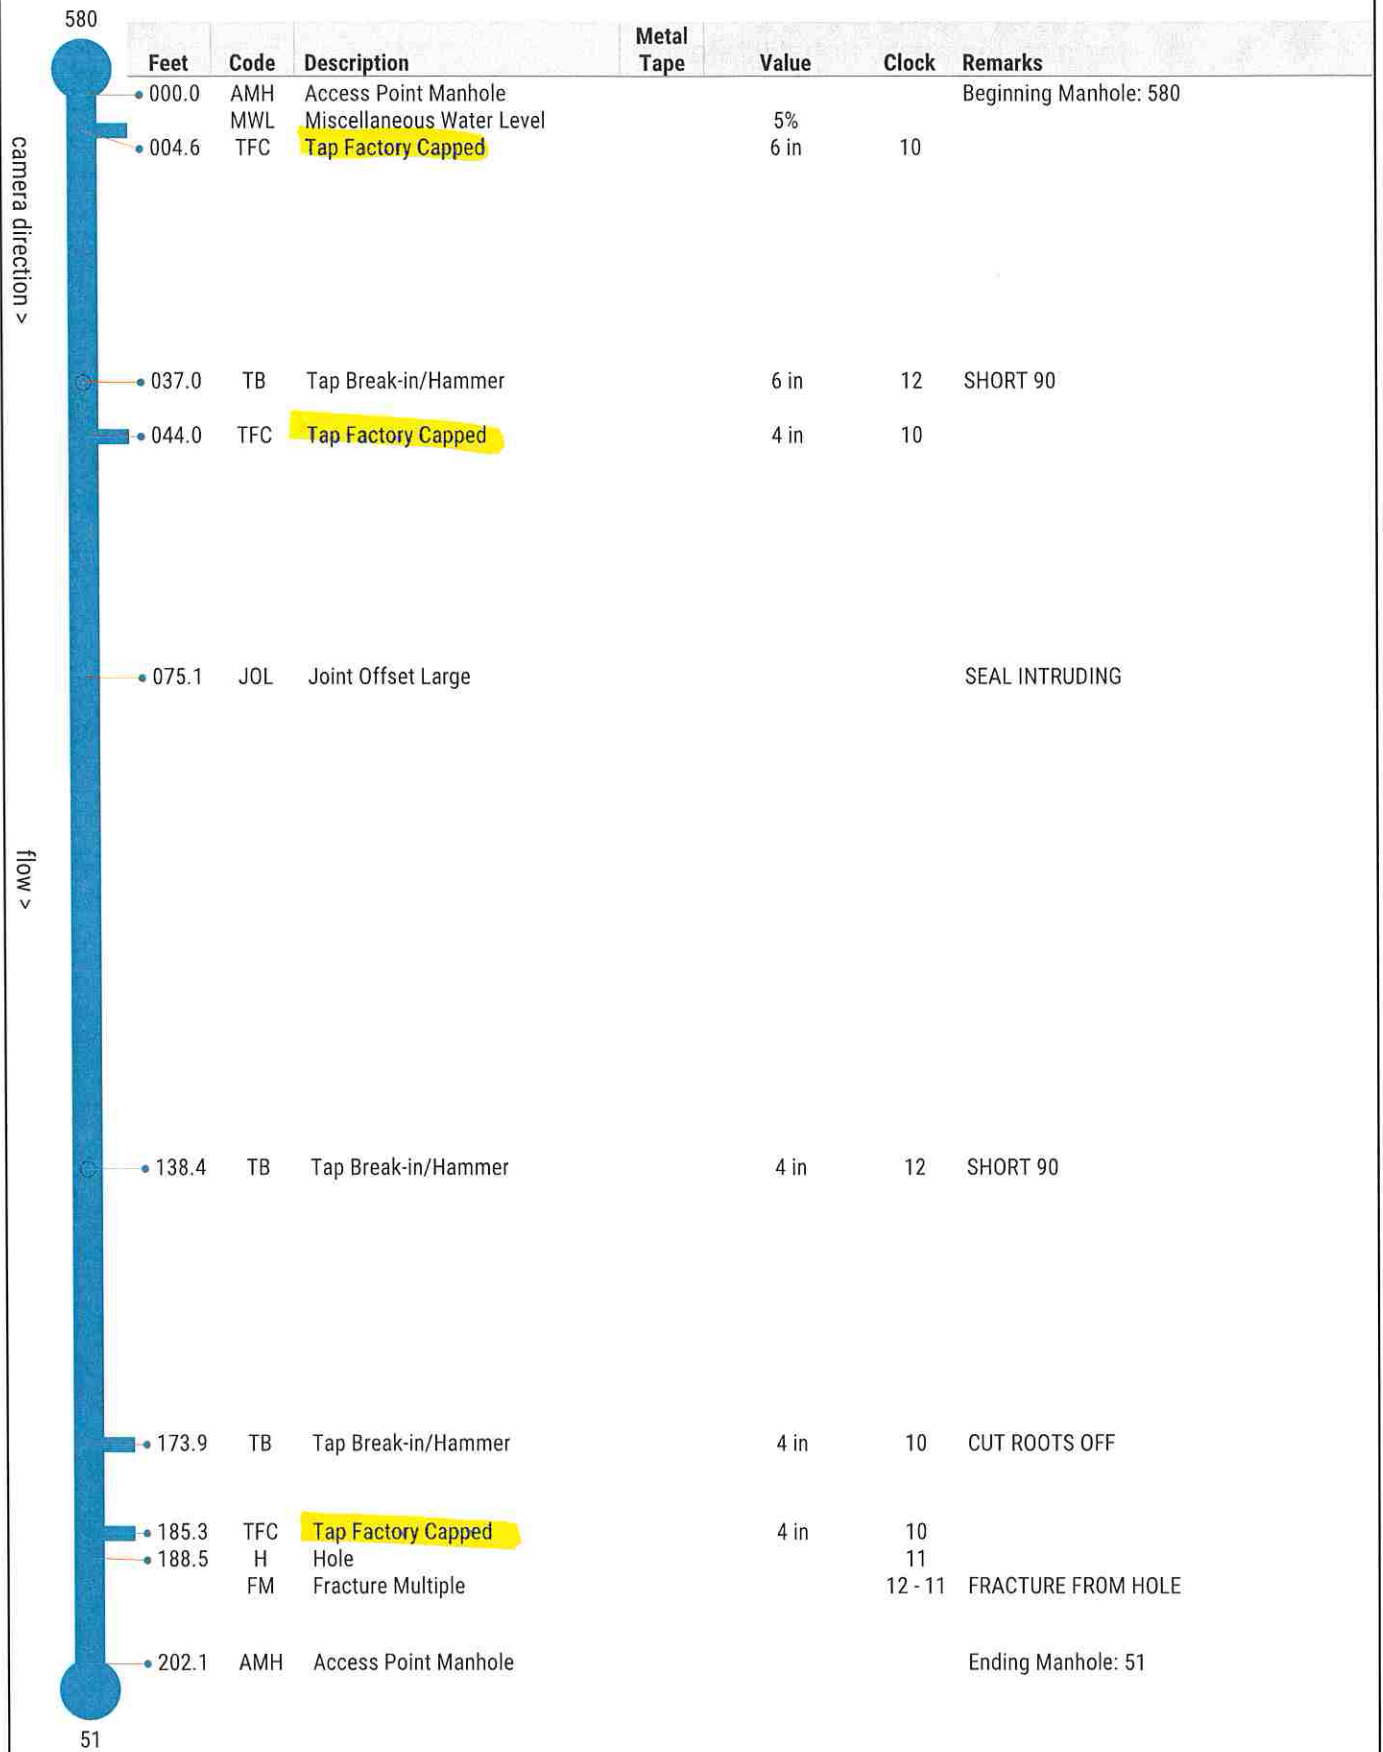

## Inspection Report

### Overview

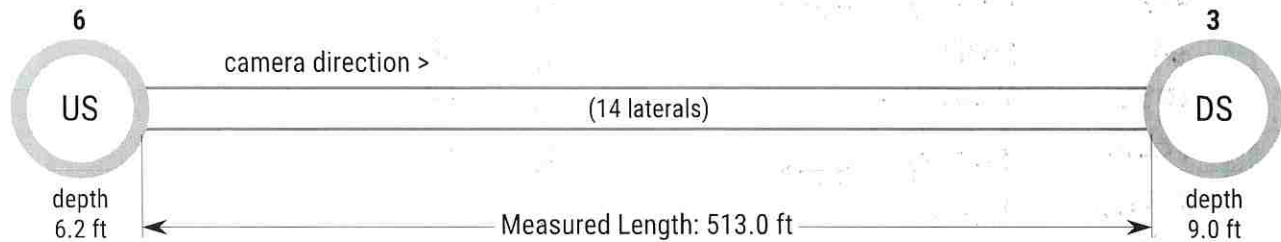

### Asset

Street: MILL ST  
City: CASSVILLE MO  
Pipe Use: Sanitary Sewage Pipe  
Pipe Geometry: 8 in (Circular)  
Material: Vitrified Clay Pipe  
Map #/Plan File: 14  
Drainage Area:  
Flow Direction: ↑ North  
Surface: Asphalt

### Inspection

Customer: ROSETTA CONSTRUCTION  
Project:  
Job #: 23010MO-11  
Media Date/Time: 2023/04/13 04:02  
Surveyed By: TYLER (P0038607-072022)  
Supervisor: DOUG B  
Pre-Cleaning: Heavy Cleaning  
Truck: 211MO  
Weather: Dry - No Precipitation During Survey  
Additional Info: RAN ROOT SAW TO CUT TAPS AND ROOTS


7895 St. Claire Ave, East St. Louis, IL 62207

# Observations

Feet	Code	Description	Metal Tape	Value	Clock	Remarks
000.0	AMH	Access Point Manhole				Beginning Manhole: 6
	MWL	Miscellaneous Water Level		5%		
02		Hammer		4	10	
47.0		Hammer		4	10	
62.0		Factory Capped		6	10	
65.1		Factory		6	3	
105.1		Hammer		4	12	
126.4		Factory Capped		6	10	
147.6		Factory		6	10	
150.6		Factory		6	2	
190.3		Factory Capped		6	10	
199.6	TFC	Tap Factory Capped		6 in	2	
206.2	TB	Tap Break-in/Hammer		4 in	1	ROOTS CUT OFF LATERAL
245.5	TB	Tap Break-in/Hammer		4 in	2	100% ROOTS AND CUT OFF
250.2	TB	Tap Break-in/Hammer		4 in	10	SHORT 90
254.9	TFC	Tap Factory Capped		6 in	10	CUT ROOTS
276.2	TFC	Tap Factory Capped		6 in	2	CUT ROOTS
321.9	TFC	Tap Factory Capped		6 in	10	
325.0	TB	Tap Break-in/Hammer		4 in	12	90
349.5	TF	Tap Factory		6 in	10	
371.1	TF	Tap Factory		6 in	2	REDUCES DOWN TO 4INCH
371.7	TB	Tap Break-in/Hammer		4 in	11	90
420.3	TB	Tap Break-in/Hammer		4 in	12	90
422.7	TFC	Tap Factory Capped		6 in	2	
425.7	TF	Tap Factory		6 in	10	
508.3	AMH	Access Point Manhole				Ending Manhole: 3

## Inspection Report

### Overview

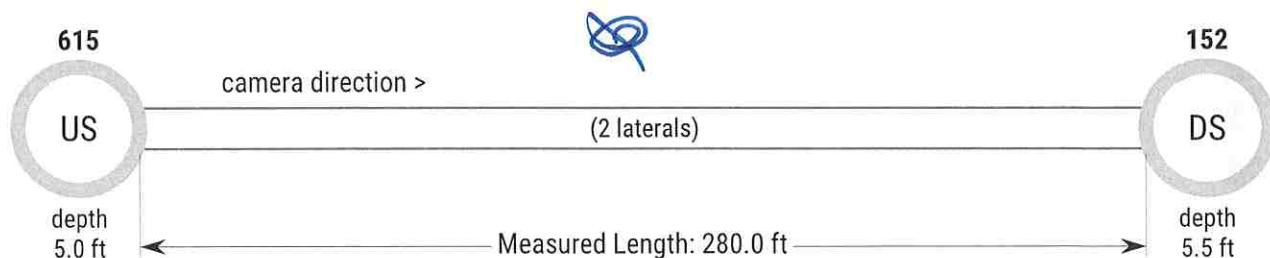

### Asset

Street: 4TH ST  
City: CASSVILLE MO  
Pipe Use: Sanitary Sewage Pipe  
Pipe Geometry: 8 in (Circular)  
Material: Vitrified Clay Pipe  
Map #/Plan File: 17  
Drainage Area:  
Flow Direction: ↗Northeast  
Surface: Asphalt


### Inspection

Customer: ROSETTA CONSTRUCTION  
Project:  
Job #: 23010MO-11  
Media Date/Time: 2023/04/19 03:21  
Surveyed By: TYLER (P0038607-072022)  
Supervisor: DOUG B  
Pre-Cleaning: Light Cleaning  
Truck: 211MO  
Weather: Dry - No Precipitation During Survey  
Additional Info: CROSSES UNDER MAINSTREET

7895 St. Claire Ave, East St. Louis, IL 62207




## Observations

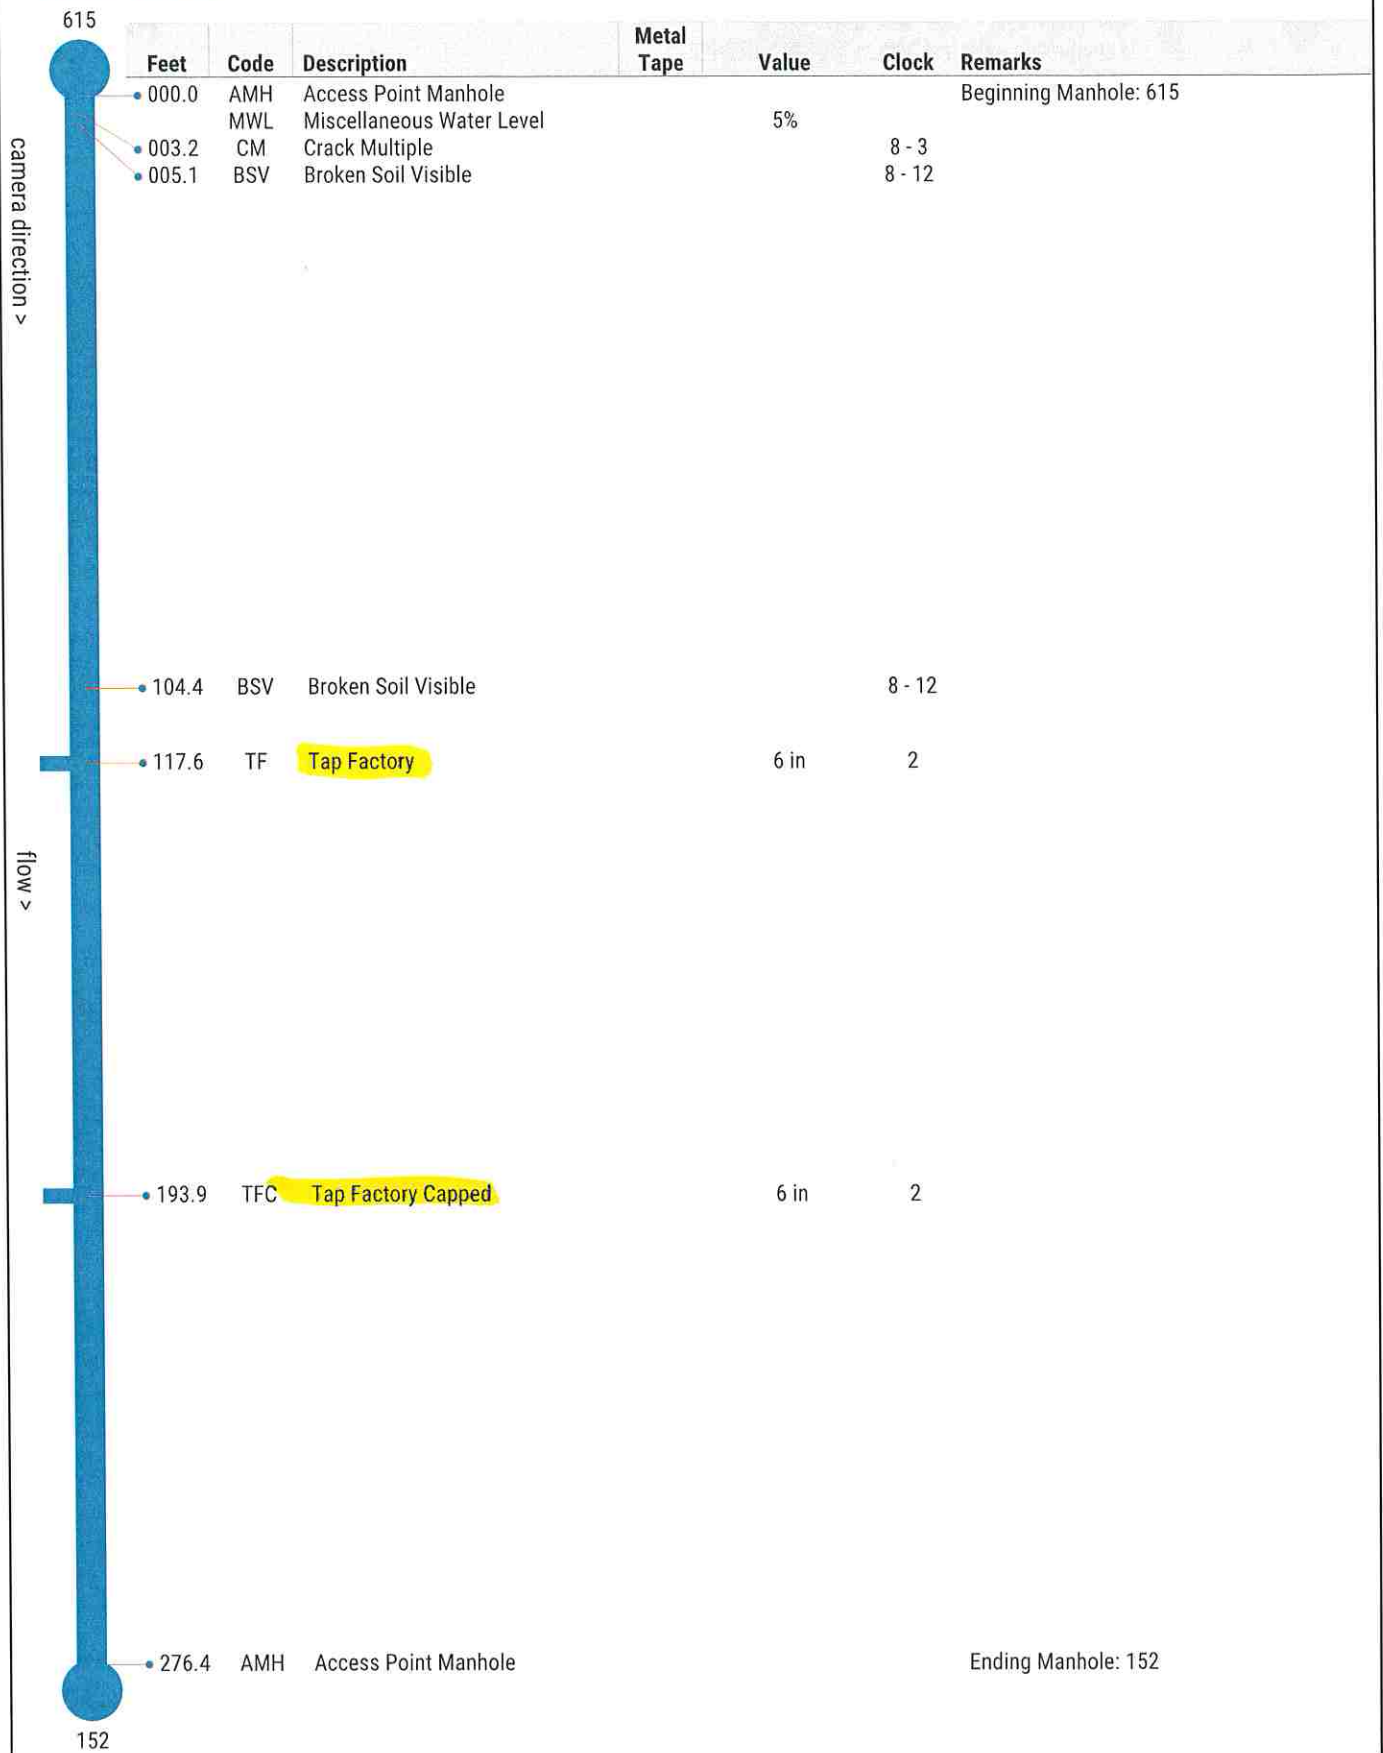



## Inspection Report

### Overview

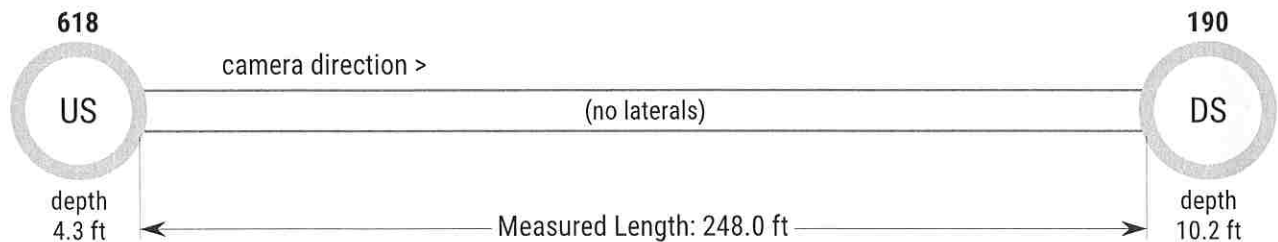

### Asset


Street: HIGHWAY 86  
City: CASSVILLE MO  
Pipe Use: Sanitary Sewage Pipe  
Pipe Geometry: 8 in (Circular)  
Material: Vitrified Clay Pipe  
Map #/Plan File: 17  
Drainage Area:  
Flow Direction: ←West  
Surface: Grass

### Inspection

Customer: ROSETTA CONSTRUCTION  
Project:  
Job #: 23010MO-11  
Media Date/Time: 2023/05/02 03:18  
Surveyed By: TYLER (P0038607-072022)  
Supervisor: DOUG B  
Pre-Cleaning: Light Cleaning  
Truck: 211MO  
Weather: Dry - No Precipitation During Survey  
Additional Info:

7895 St. Claire Ave, East St. Louis, IL 62207


## Observations

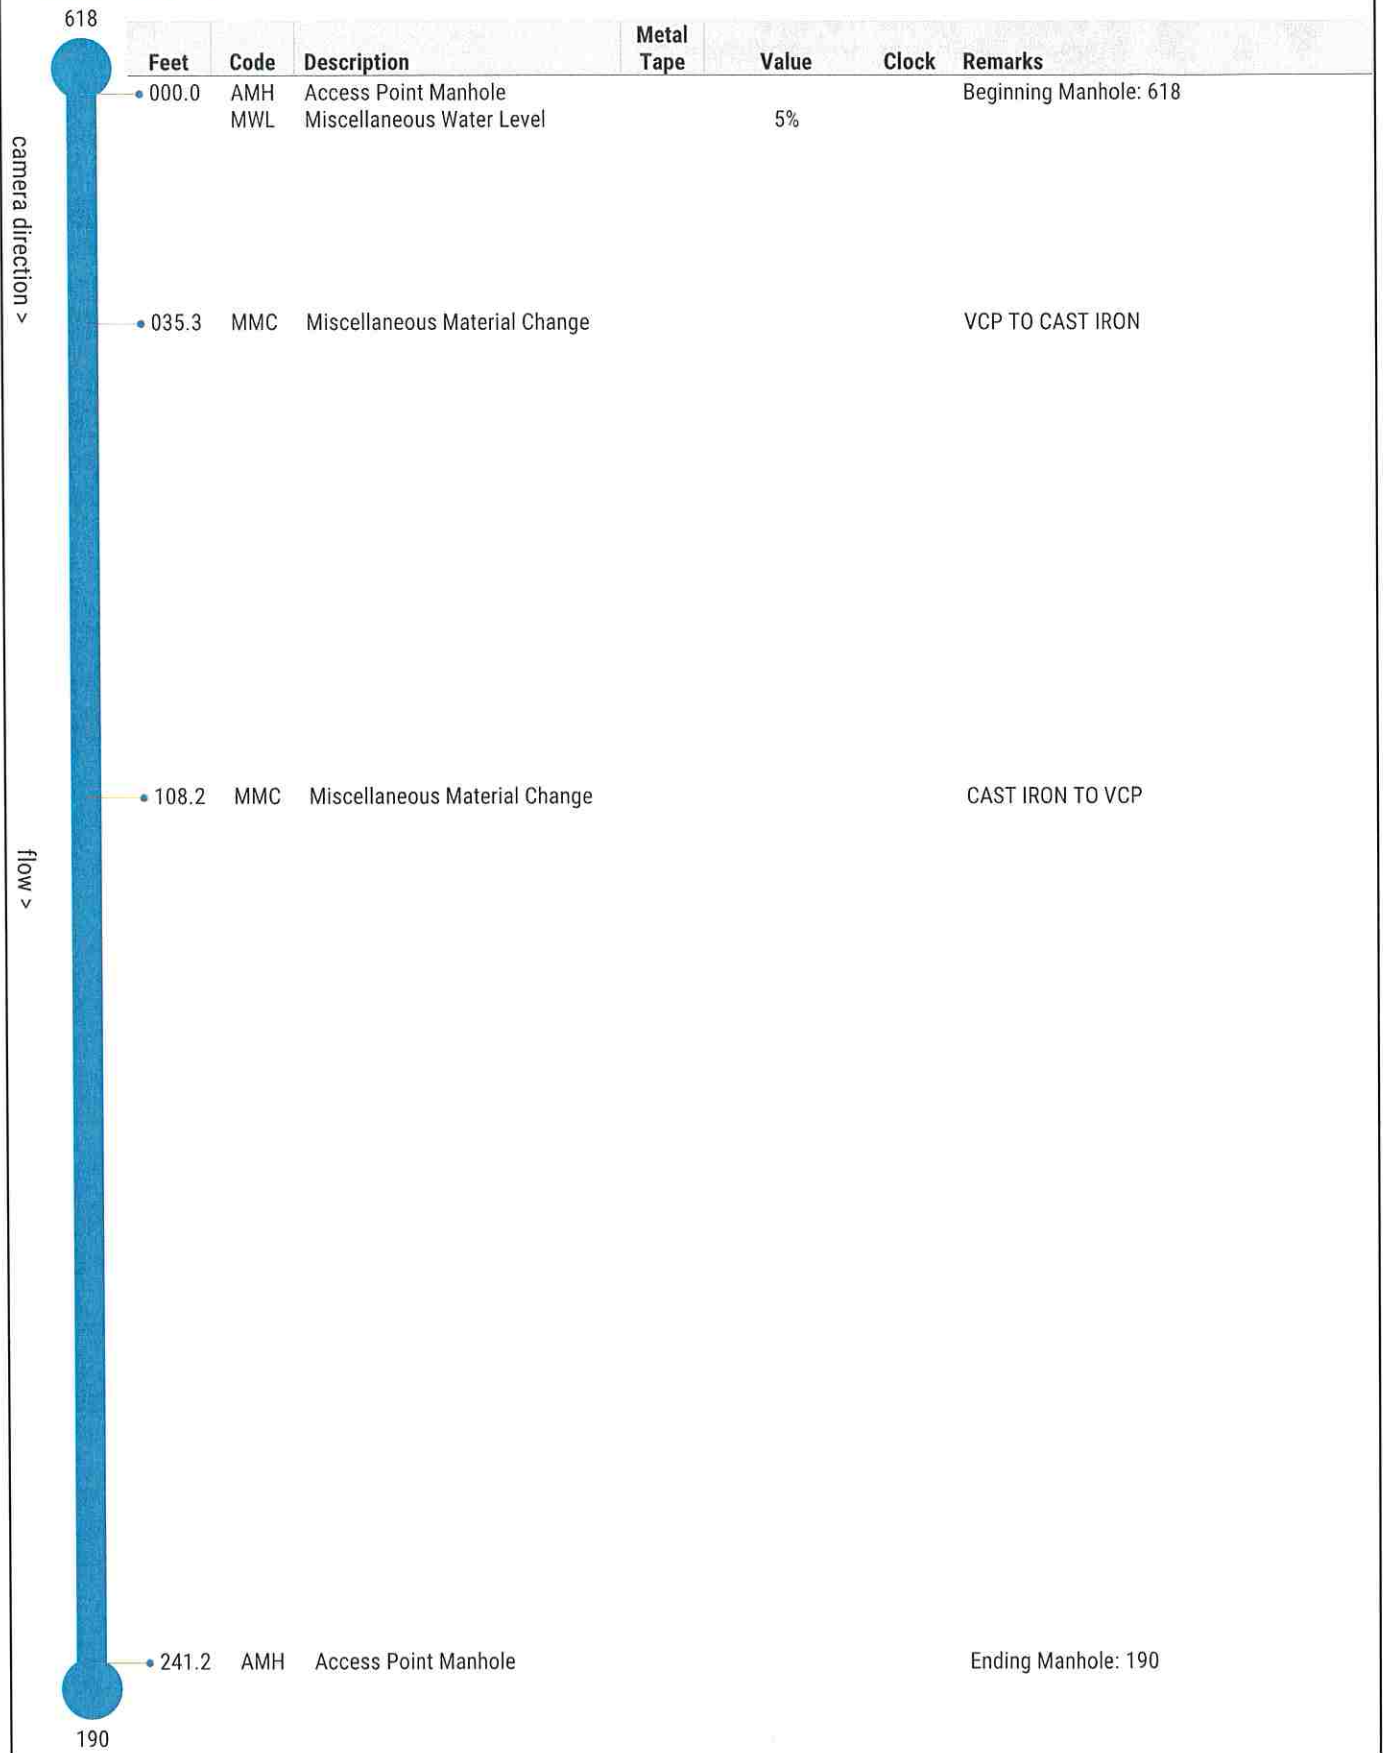



## Inspection Report

### Overview

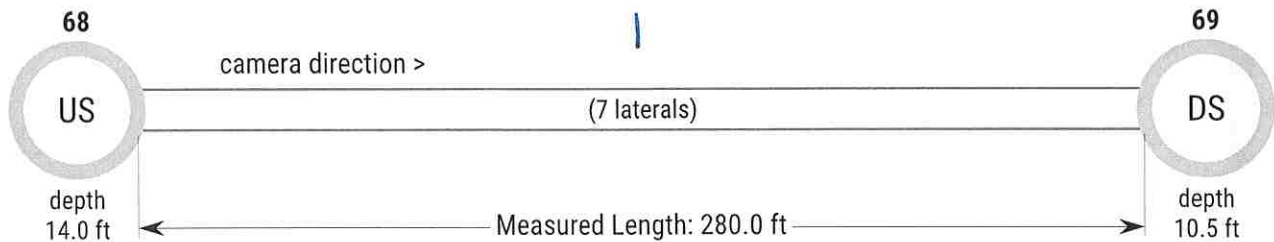

### Asset

Street: FAIR ST  
City: CASSVILLE MO  
Pipe Use: Sanitary Sewage Pipe  
Pipe Geometry: 10 in (Circular)  
Material: Vitrified Clay Pipe  
Map #/Plan File: 16  
Drainage Area:  
Flow Direction: →East  
Surface: Asphalt

### Inspection

Customer: ROSETTA CONSTRUCTION  
Project:  
Job #: 23010MO-11  
Media Date/Time: 2023/05/23 10:12  
Surveyed By: TYLER (P0038607-072022)  
Supervisor: JAMES  
Pre-Cleaning: Light Cleaning  
Truck: 211MO  
Weather: Dry - No Precipitation During Survey  
Additional Info: DOWNSTREAM MANHOLE DROP

7895 St. Claire Ave, East St. Louis, IL 62207

## Observations

